


BASIS OF BEARING
 SOLAR OBSERVATIONS AT THE NE CORNER OF SECT. 2
 Date — Dec. 18, 1980
 Latitude = 45° 46' 26"
 Mean horz. angle = 233° 22' 17"
 Mean vert. angle = 13° 55' 41"
 Surs d = 23° 24' 54.4"

NARRATIVE

This survey was made at the request of Boise Cascade Corporation to establish and reestablish the corners as shown. The survey was started in November, 1980, and completed in 1981. I found the G.L.O. corners as shown, and proportioned those shown, in accordance with the laws of the State of Oregon and the B.L.M. manual of 1973. No unusual conditions were found other than those shown.

Duane I. Griffith
 Duane I. Griffith OPLS 644

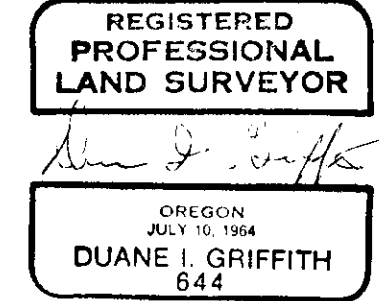

REFERENCE MATERIAL

G.L.O. field notes
 County remonumentation records
 Map of survey no. 68-77

LEGEND

- Found brass cap monument of record.
- ⊙ Found evidence of G.L.O. corner, set 2-1/2" x 30" brass cap.
- ⊙ Set 2-1/2" x 30" brass cap at proportionate distance.
- Set 1-1/2" x 30" brass cap at proportionate distance.
- () Record bearing and distance.
- BC Boise Cascade Corporation.
- DR Delbert Rysdam
- DD Donald DeMoss
- FS U.S. Forest Service

NOTE

For monumentation information, see record of monumentation forms, filed separately.

BAGETT - GRIFFITH & ASSOCIATES LaGrande, Oregon	
Map of Survey Sections 1, 2, 3, 10, & 11 T 3 N, R 39 E, W.M.	
UNION COUNTY, OREGON	
SURVEYED FOR	BOISE CASCADE CORP.
SURVEYED BY	d.i.g., g.t.b., r.g.r. 12/1980
Scale: 1" = 500'	Drawn by: d.i.g. 1/1981