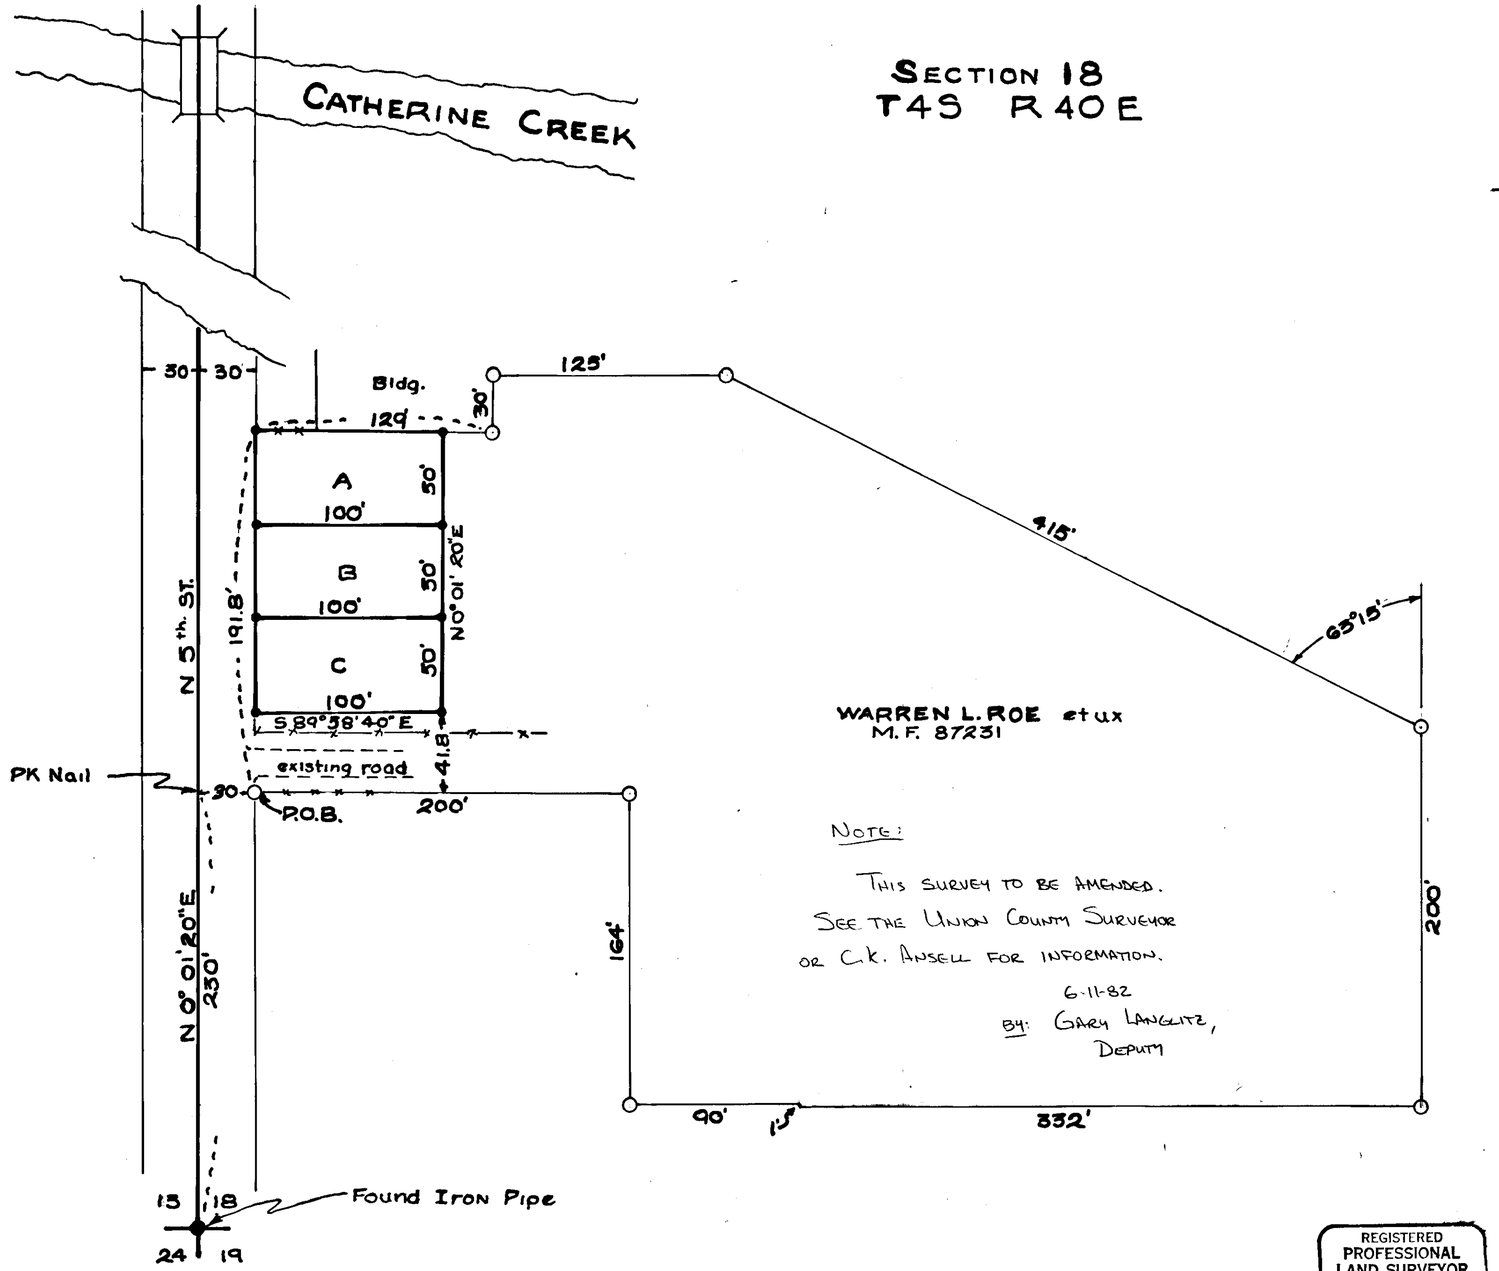

NOTE:

THIS SURVEY TO BE AMENDED.
SEE THE UNION COUNTY SURVEYOR
OR C.K. ANSELL FOR INFORMATION.
6-11-82
BY: GARY LANGLITZ,
DEPUTY

REGISTERED
PROFESSIONAL
LAND SURVEYOR
C. K. Ansell
OREGON
SEPT. 23, 1977
CLAYTON K. ANSELL
01119LS

BASIS OF BEARING

Based on West line Sect. 18

LEGEND

- ● Found Monument of Record
- • Set 5/8" × 30" iron pin
- —x—x— Existing Fence

NARRATIVE

The Deed as recorded was left open on the west line. Using coordinates a distance of 191.8 feet was computed which fit existing conditions within reason. At Mr. Roes instructions, 3 lots were pinned, indicated as A, B & C.

SURVEYED FOR WARREN L. ROE	
SURVEYED BY C. K. ANSELL	
Scale 1" = 50'	Date April 24, 1981

30-81