

BASIS OF BEARING
 RECORD SURVEY NO. 35-79

REFERENCE MATERIAL

ORIGINAL PLAT OF LEWIS' ADDITION
 RECORD SURVEY NO. 35-79

LEGEND

- — — — — PROPERTY LINE
- * * * * — FENCE
- FOUND MONUMENT OF RECORD
A 5/8" PIN W/YELLOW CAP STAMPED "B.G. & A SURVEY MARKER"
- SET 5/8" x 30" REBAR W/YELLOW CAP STAMPED "A.P. & A"
- () RECORD DATA

DESCRIPTION

A parcel of land situated in the west one-half of the southwest one-quarter of Section 18, T4S, R38E, Willamette Meridian, Union, Union County, Oregon, more particularly described as follows: All of lots 7 and 8 of Block 13, Lewis' Addition to the Town of North Union in City and County of Union, Oregon containing 10,004 square feet = 0.230 acres.


UNION COUNTY SURVEYOR

Date Received 10-8-81

Date Filed 10-12-81

By G. LANGLITE, DEPUTY

File No. 71-81

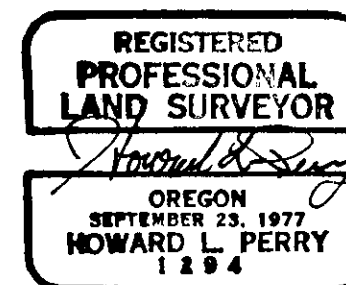

MAP OF SURVEY
 LOTS 7 & 8, BLOCK 13, LEWIS' ADDITION
 UNION, UNION COUNTY, OREGON

FOR: N.E. OREGON HOUSING ASSOCIATION

SCALE 1" = 20'-0"	<p>anderson perry & associates, inc. <small>engineering • surveying • materials testing</small></p> <p>LA GRANDE & ENTERPRISE, OREGON</p>	SHEET NO. 1/1
DATE JAN. 1981		