74-81

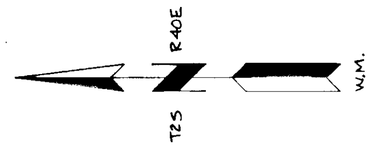

BASIS OF BEARING

SOLAR OBSERVATION

MAGNETIC DECLINATION

N 18° 30' E

REFERENCE MATERIAL

GLO NOTES AND PLATS FOR T2S, R40E, W.M.

7100-52 CORNER RECORD SEARCH CARDS

7100-57 CERTIFIED RECORD OF LAND CORNER MONUMENTATION FILED WITH THE UNION COUNTY SURVEYOR.

FIELD BOOKS 1, 2, & 3.

LEGEND

- SET MONUMENT AS DESCRIBED ON ATTACHED U.S.F.S. FORM R6-7100-57 BASED ON SURVEY.
- SET MONUMENT AS DESCRIBED ON ATTACHED U.S.F.S. FORM R6-7100-57 FROM ORIGINAL EVIDENCE. ORIGINAL CORNER WAS SET BY A JUNIOR SURVEY & IS TREATED AS A CLOSING CORNER AS PER BLM MANUAL SECTION 5-35(3).
- FOUND ORIGINAL CORNER EVIDENCE AS SHOWN, REFER TO U.S.F.S. FORM R6-7100-52 CORNER SEARCH CARD FILED WITH U.S.F.S.
- FOUND EXISTING MONUMENT AS SHOWN.
- NO ORIGINAL CORNER EVIDENCE COULD BE FOUND.
- ( ) RECORD DATA FROM GLO CONTRACT NO. 450 BY HENRY MELDRUM.
- POSTED LINE BY HANGING PINK FLAGGING & SETTING STAKES.
- SET MONUMENT AS DESCRIBED ON ATTACHED U.S.F.S. FORM R6-7100-57 FROM ORIGINAL EVIDENCE.

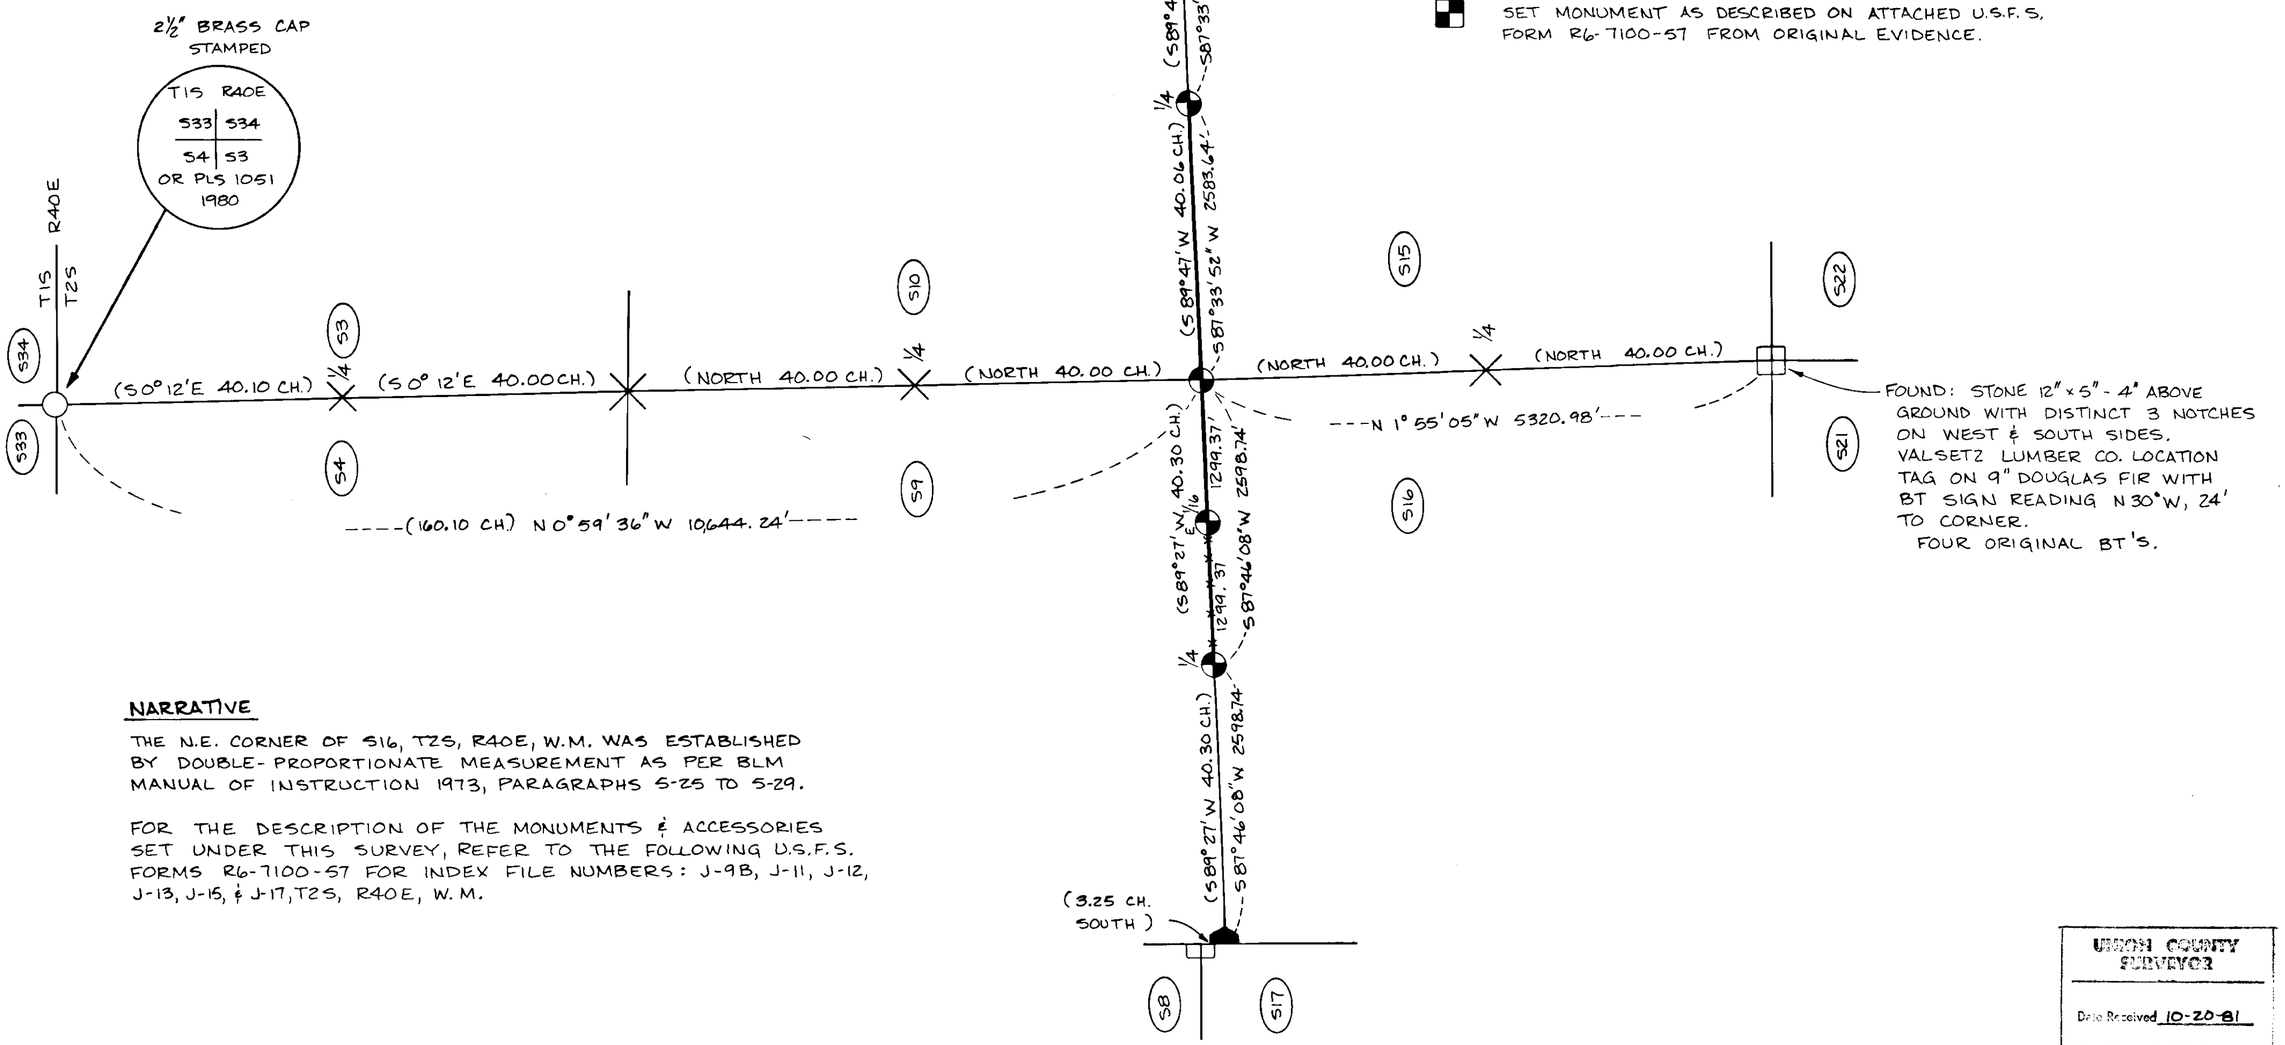

NARRATIVE

THE N.E. CORNER OF S16, T2S, R40E, W.M. WAS ESTABLISHED BY DOUBLE-PROPORTIONATE MEASUREMENT AS PER BLM MANUAL OF INSTRUCTION 1973, PARAGRAPHS S-25 TO S-29.

FOR THE DESCRIPTION OF THE MONUMENTS & ACCESSORIES SET UNDER THIS SURVEY, REFER TO THE FOLLOWING U.S.F.S. FORMS R6-7100-57 FOR INDEX FILE NUMBERS: J-9B, J-11, J-12, J-13, J-15, & J-17, T2S, R40E, W. M.

REGISTERED PROFESSIONAL LAND SURVEYOR
OREGON
DECEMBER 23, 1977
HOWARD L. PERRY
1284

UNION COUNTY SURVEYOR

Date Received 10-20-81

Date Filed 10-20-81

By G. LANGLITZ, DEPUTY

File No. 74-81

MAP OF SURVEY
NORTH LINE OF SECTIONS 15 & 16, T2S, R40E, W.M., UNION COUNTY, OREGON

FOR: BOISE CASCADE CORP. AND PETE MUNDAY

SCALE: 1" = 1,000'

DATE: SEPT. 1981

JOB NO. 823-40

anderson perry & associates, inc.
engineering · surveying · materials testing
LA GRANDE, ORE. & WALLA WALLA, WASH.

SHEET NO. 1/1

74-81