
PORTLAND PRECISION INSTRUMENT

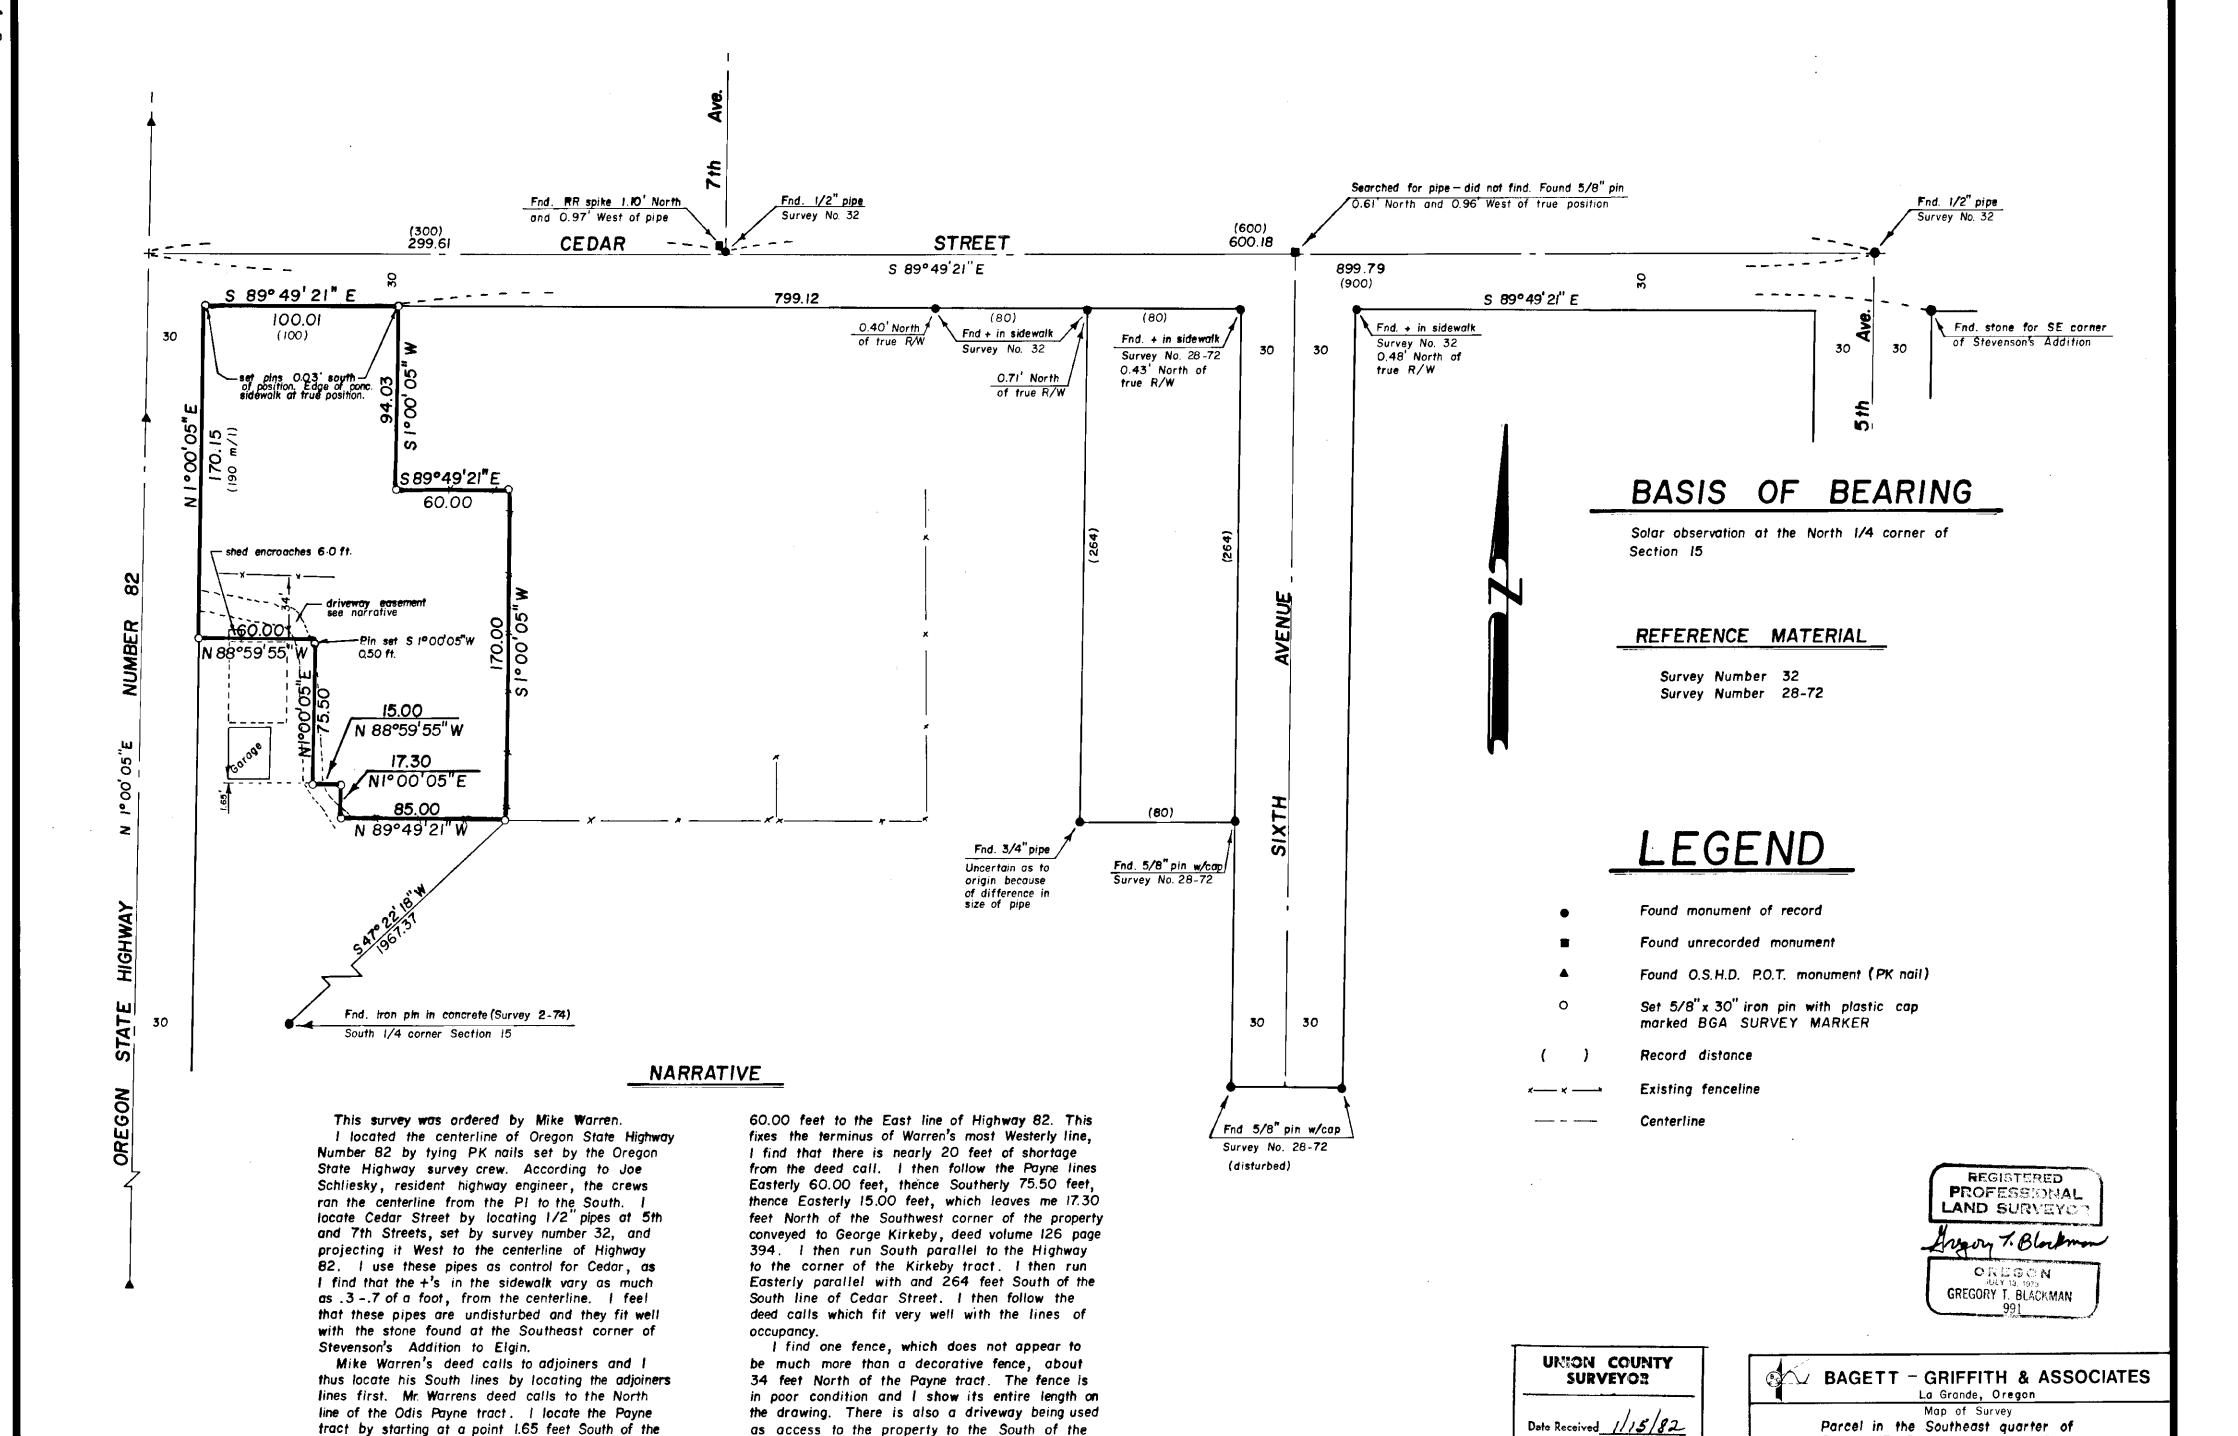

as access to the property to the South of the

Warren property. It is possible that an easement

has ripened. I have no idea how long this road

I encountered no other problems with this

has been used.

survey.

tract by starting at a point 1.65 feet South of the

Southwest corner of the gasoline service station. I

as the Highway is called North and South. I then

thence I run West at right angles to the Highway

run East 60 feet at right angles to the Highway,

run North, parallel to the Highway 75.50 feet,

1/82 1/82

Parcel in the Southeast quarter of

Section 15, Township I North, Range

39 East of the Willamette Meridian

UNION COUNTY, OREGON

Mike Warren

Drawn by: RGR

Elgin

GTB

SURVEYED FOR

SURVEYED BY

Scale: 1"= 50'

Date Filed 1-21-82

By G. LANGLITE DEPUTY