12-82

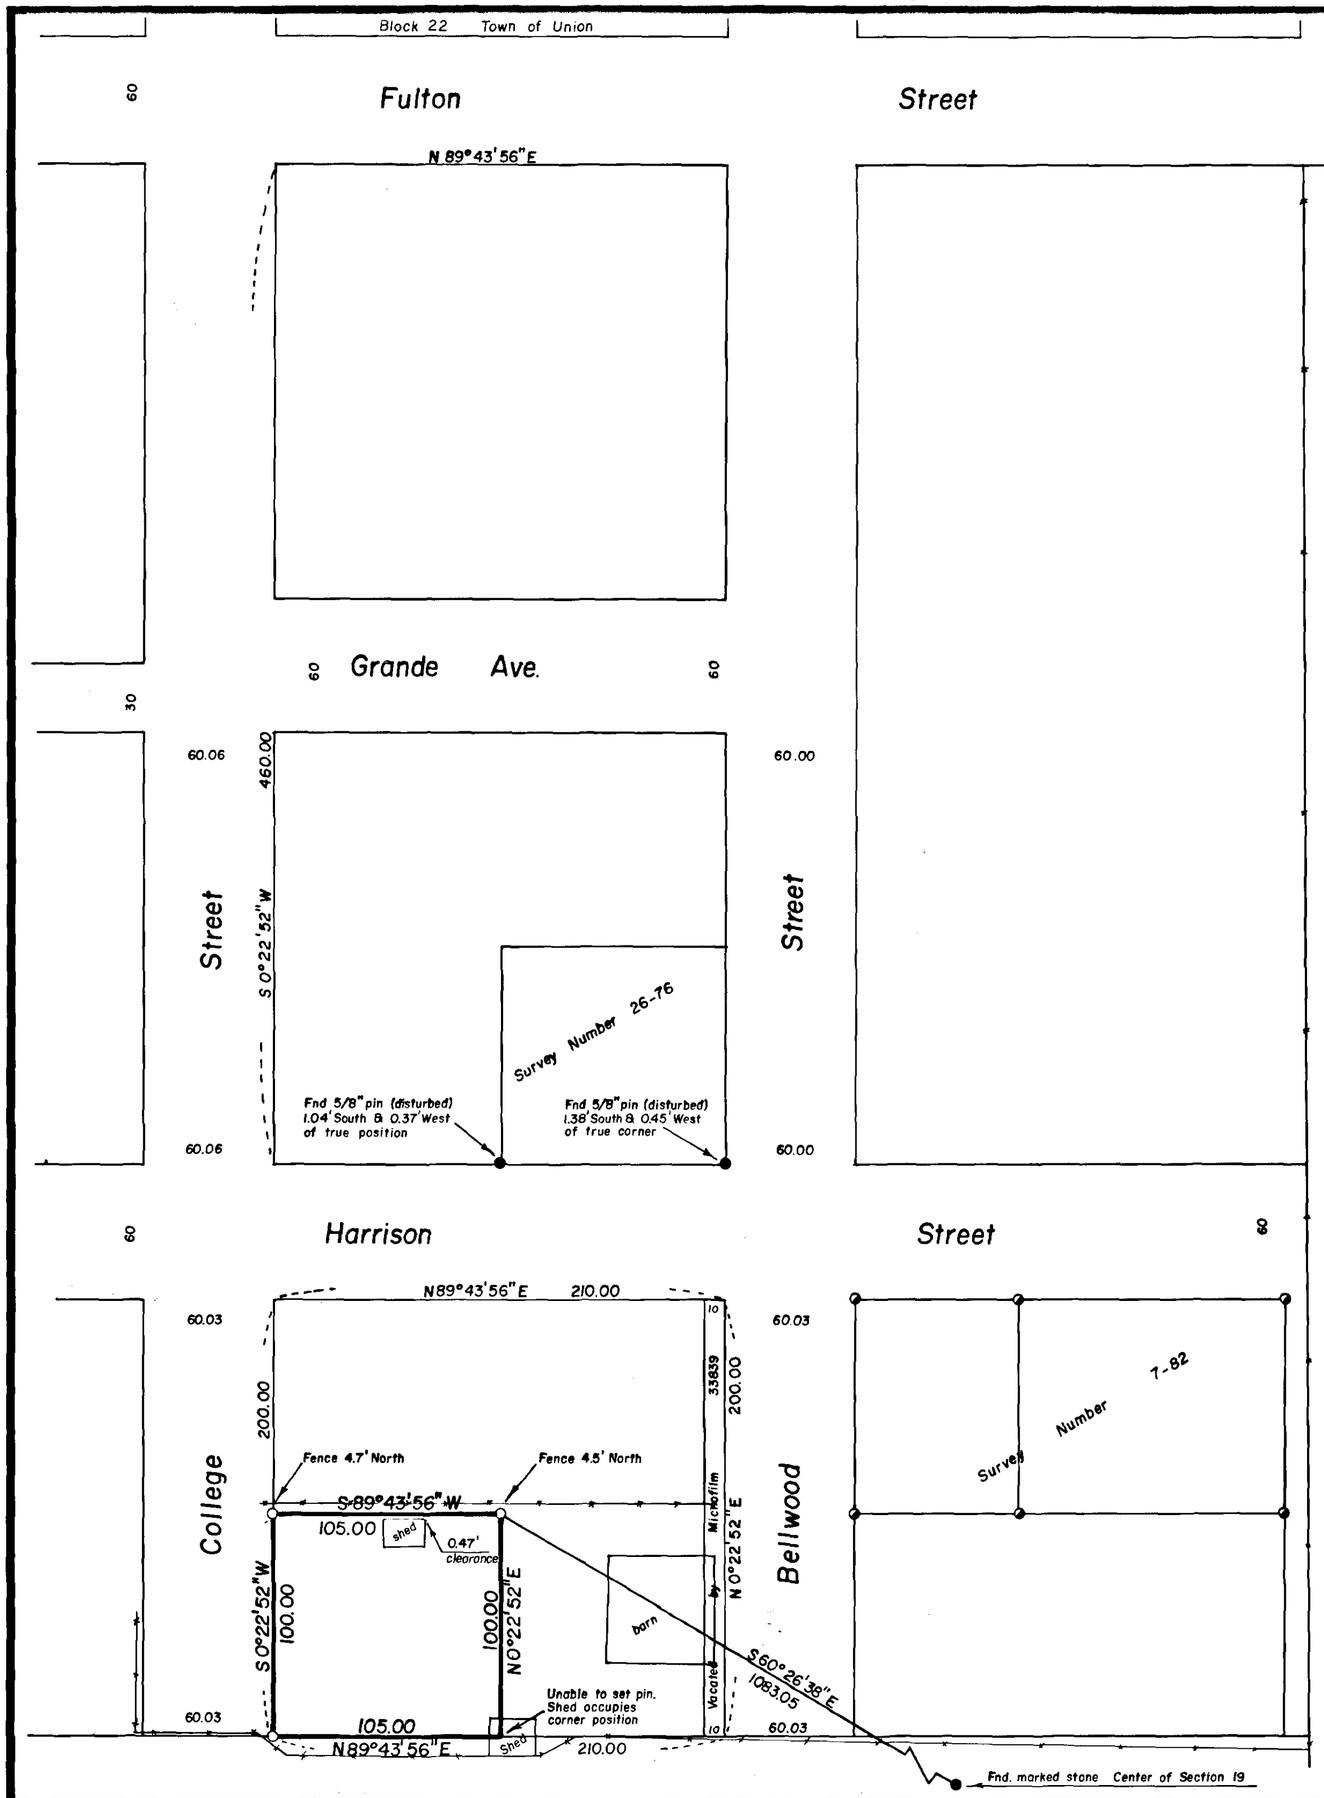

BASIS OF BEARING

Solar observation at the Northwest corner of Section 19, T 4 S, R 40 E, W.M.

LEGEND

- ● Found monument of record
- ◐ Found 5/8" pin with plastic cap set by survey number 7-82
- ○ Set 5/8" x 30" iron pin with plastic cap marked BGA SURVEY MARKER
- Existing fenceline

REFERENCE MATERIAL

Survey Number 26-76
Survey Number 113-78
Survey Number 16-79
Survey Number 19-79
Survey Number 79-81
Survey Number 7-82

DEEDS

Book D Page 63
Book 159 Page 45
Microfilm No. 21402
Microfilm No. 33839

NARRATIVE

This survey was ordered by Leon Lincicum.

The blocks South of Fulton Street and East of Main Street were created by metes and bounds description with the streets junior to the parcels. The blocks were created by beginning at various block corners of the Town of Union. The block we have surveyed had its beginning at the Southwest corner of Block 22, Town of Union. These block corners were established on the basis of survey numbers 16-79 and 19-79.

I have run the North-South lines of the blocks parallel with the centerline of Main Street, and the East-West lines parallel with Fulton Street.

UNION COUNTY SURVEYOR
Date Received 9-27-82
Date Filed 3-30-82
By G. Langlois Dep.
File No. 12-82

REGISTERED PROFESSIONAL LAND SURVEYOR
Gregory T. Blackman
OREGON JULY 13, 1972
GREGORY T. BLACKMAN
991

BAGETT - GRIFFITH & ASSOCIATES
La Grande, Oregon

Map of Survey
Parcel in the Southeast quarter of the Northwest quarter of Section 19, Township 4 South, Range 40 East, Willamette Meridian Union
UNION COUNTY, OREGON

SURVEYED FOR	Leon Lincicum	
SURVEYED BY	GTB	3/82
Scale: 1" = 50'	Drawn by: RGR	3/82

Survey Number 12-82

PORTLAND PRECISION INSTRUMENT