


17-82

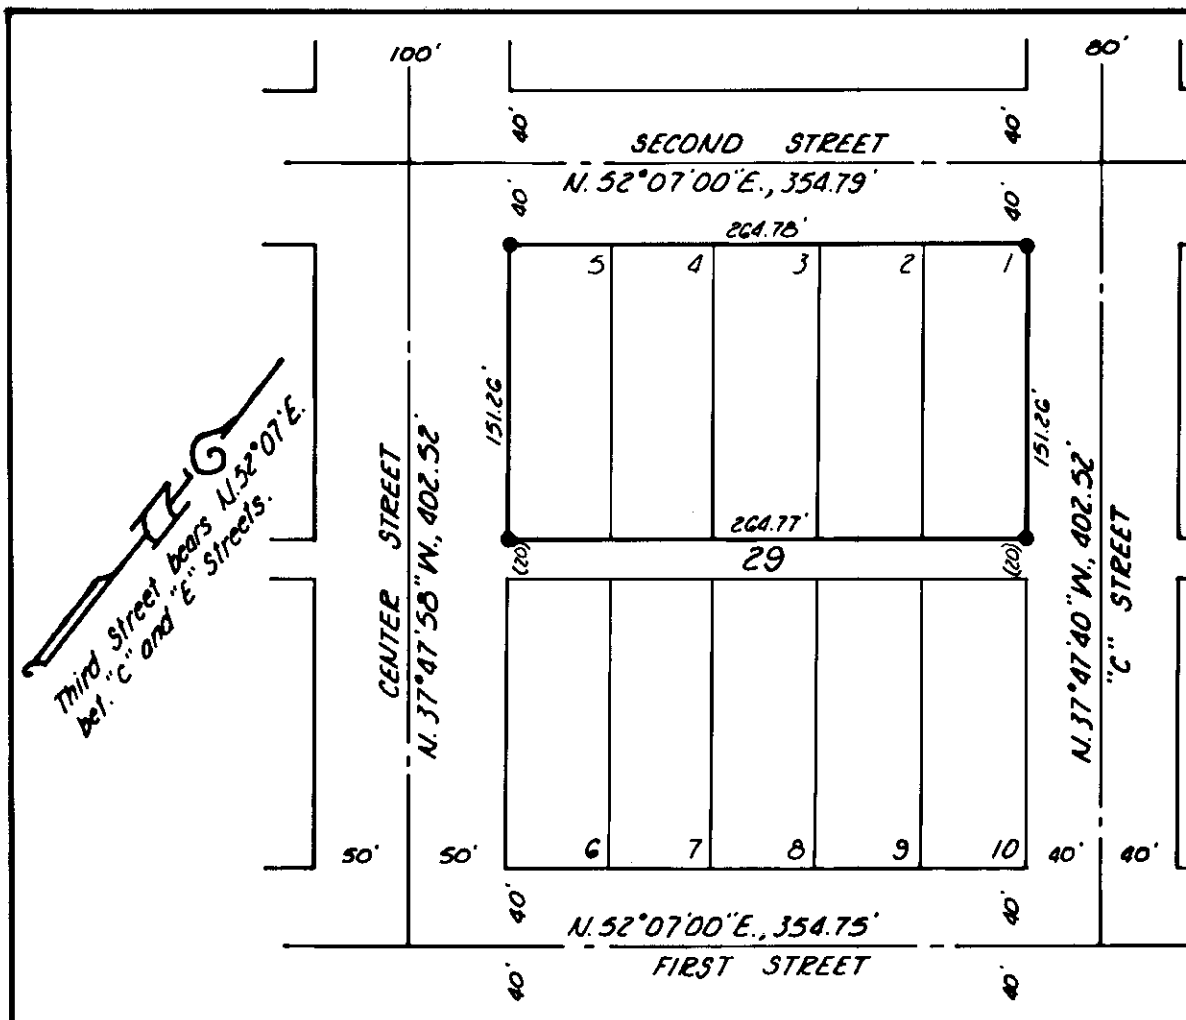

**SURVEY NARRATIVE**

This survey was performed at the request of Gene Dempsey for the purpose of monumenting the corners of the North half of Block 29, North Powder, Oregon, located in the S½NE¼ of Section 22, T 6 S, R 39 E, W.M.

Previously recovered original or reestablished monumentation included a 5/8" rebar at Fourth & "C", a 1½" square iron pin at Third & "C", a 1" square iron pin at Third & "E", a 1" square iron pin at Second & "E", and a 1" square iron pin at First and "E". Third St. bears N 52°07' E, 1054.55 feet between recovered "C" and "E" street monumentation. The centerline of Second St. and First St. are reestablished parallel to Third St. from the recovered monumentation along "E" St. The centerline of "C" St. Southeast-erly of Third St. is reestablished by projecting the line of monuments between Third and Fourth streets to intersect the reestab-lished centerline of Second and First streets respectively. Second St. intersections at "D" St. and Center St and First St. intersections at "D" St. and Center St. are reestablished at their proportional positions, with provisions made for "C", "D", and "E" Streets being 80 feet wide and Center Street being 100 feet wide. Block 29 was then subdivided into its platted lottings using proper survey methods.

- Indicates set ½" x 30" rebar with plastic cap marked HANLEY ENGR PLS 1206

MAP OF SURVEY  
 LOTS 1 THRU 5, BLOCK 29 OF  
 NORTH POWDER UNION COUNTY OREGON  
 Surveyed April 27, 1982 Scale 1"=100'  
 For Gene Dempsey

REGISTERED  
 PROFESSIONAL  
 LAND SURVEYOR

William L. Hanley

OREGON  
 JULY 14, 1978  
 WILLIAM L. HANLEY  
 1639

UNION COUNTY  
 SURVEYOR

Date Received 5-7-82

Date Filed 5-10-82

By G. LANGRISH, Deputy

File No. 17-82

17-82