
PORTLAND PRECISION INSTRUMENT

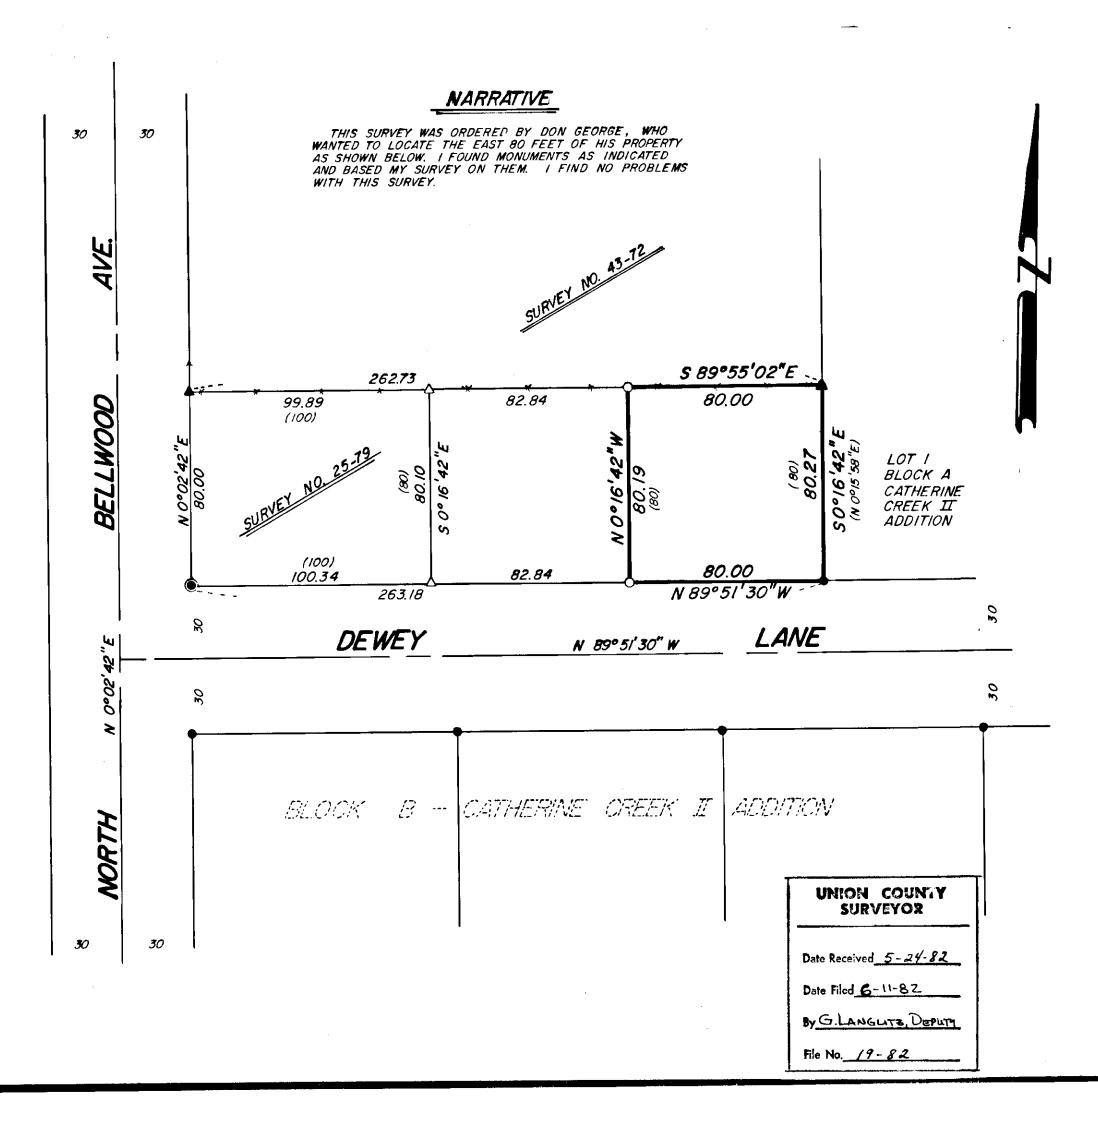

BASIS OF BEARING

SOLAR OBSERVATION TAKEN AT THE SW CORNER OF SECTION 18, T 4 5, R 40E, W.M.

REFERENCE MATERIAL

PLAT OF CATHERINE CREEK II ADDITION SURVEY NUMBER 43-72 SURVEY NUMBER 25-79

LEGEND

- FOUND 5/8" PIN FROM SURVEY NO. 43-72
- FOUND 5/8" PIN FROM SURVEY NO. 25-79
- FOUND MONUMENT FROM CATH. CR. II ADDN.
- FOUND INITIAL POINT OF CATHERINE CREEK II ADDITION
- SET 5/8" x 30" IRON PIN WITH PLASTIC CAP MARKED B.G.A SURVEY MARKER

* * * * EXISTING FENCELINE

REGISTERED PROFESSIONAL LAND SURVEYOR

Lygory T. Black

OREGON
JULY 13, 1978
GRÉGORY T. BLACKMAN
991

BAGETT, GRIFFITH & ASSOCIATES

La Grande, Oregon

Map of Survey PARCEL IN THE SE 1/4 OF THE SW 1/4 OF SECTION 18, T4 S, R40E, W.M.

UNION UNION COUNTY, OREGON

SURVEYED FOR DON GEORGE 5/82 SURVEYED BY GTB 5/82 Scale: /"= 40' Drawn by: RGR