
PORTLAND PRECISION INSTRUMENT

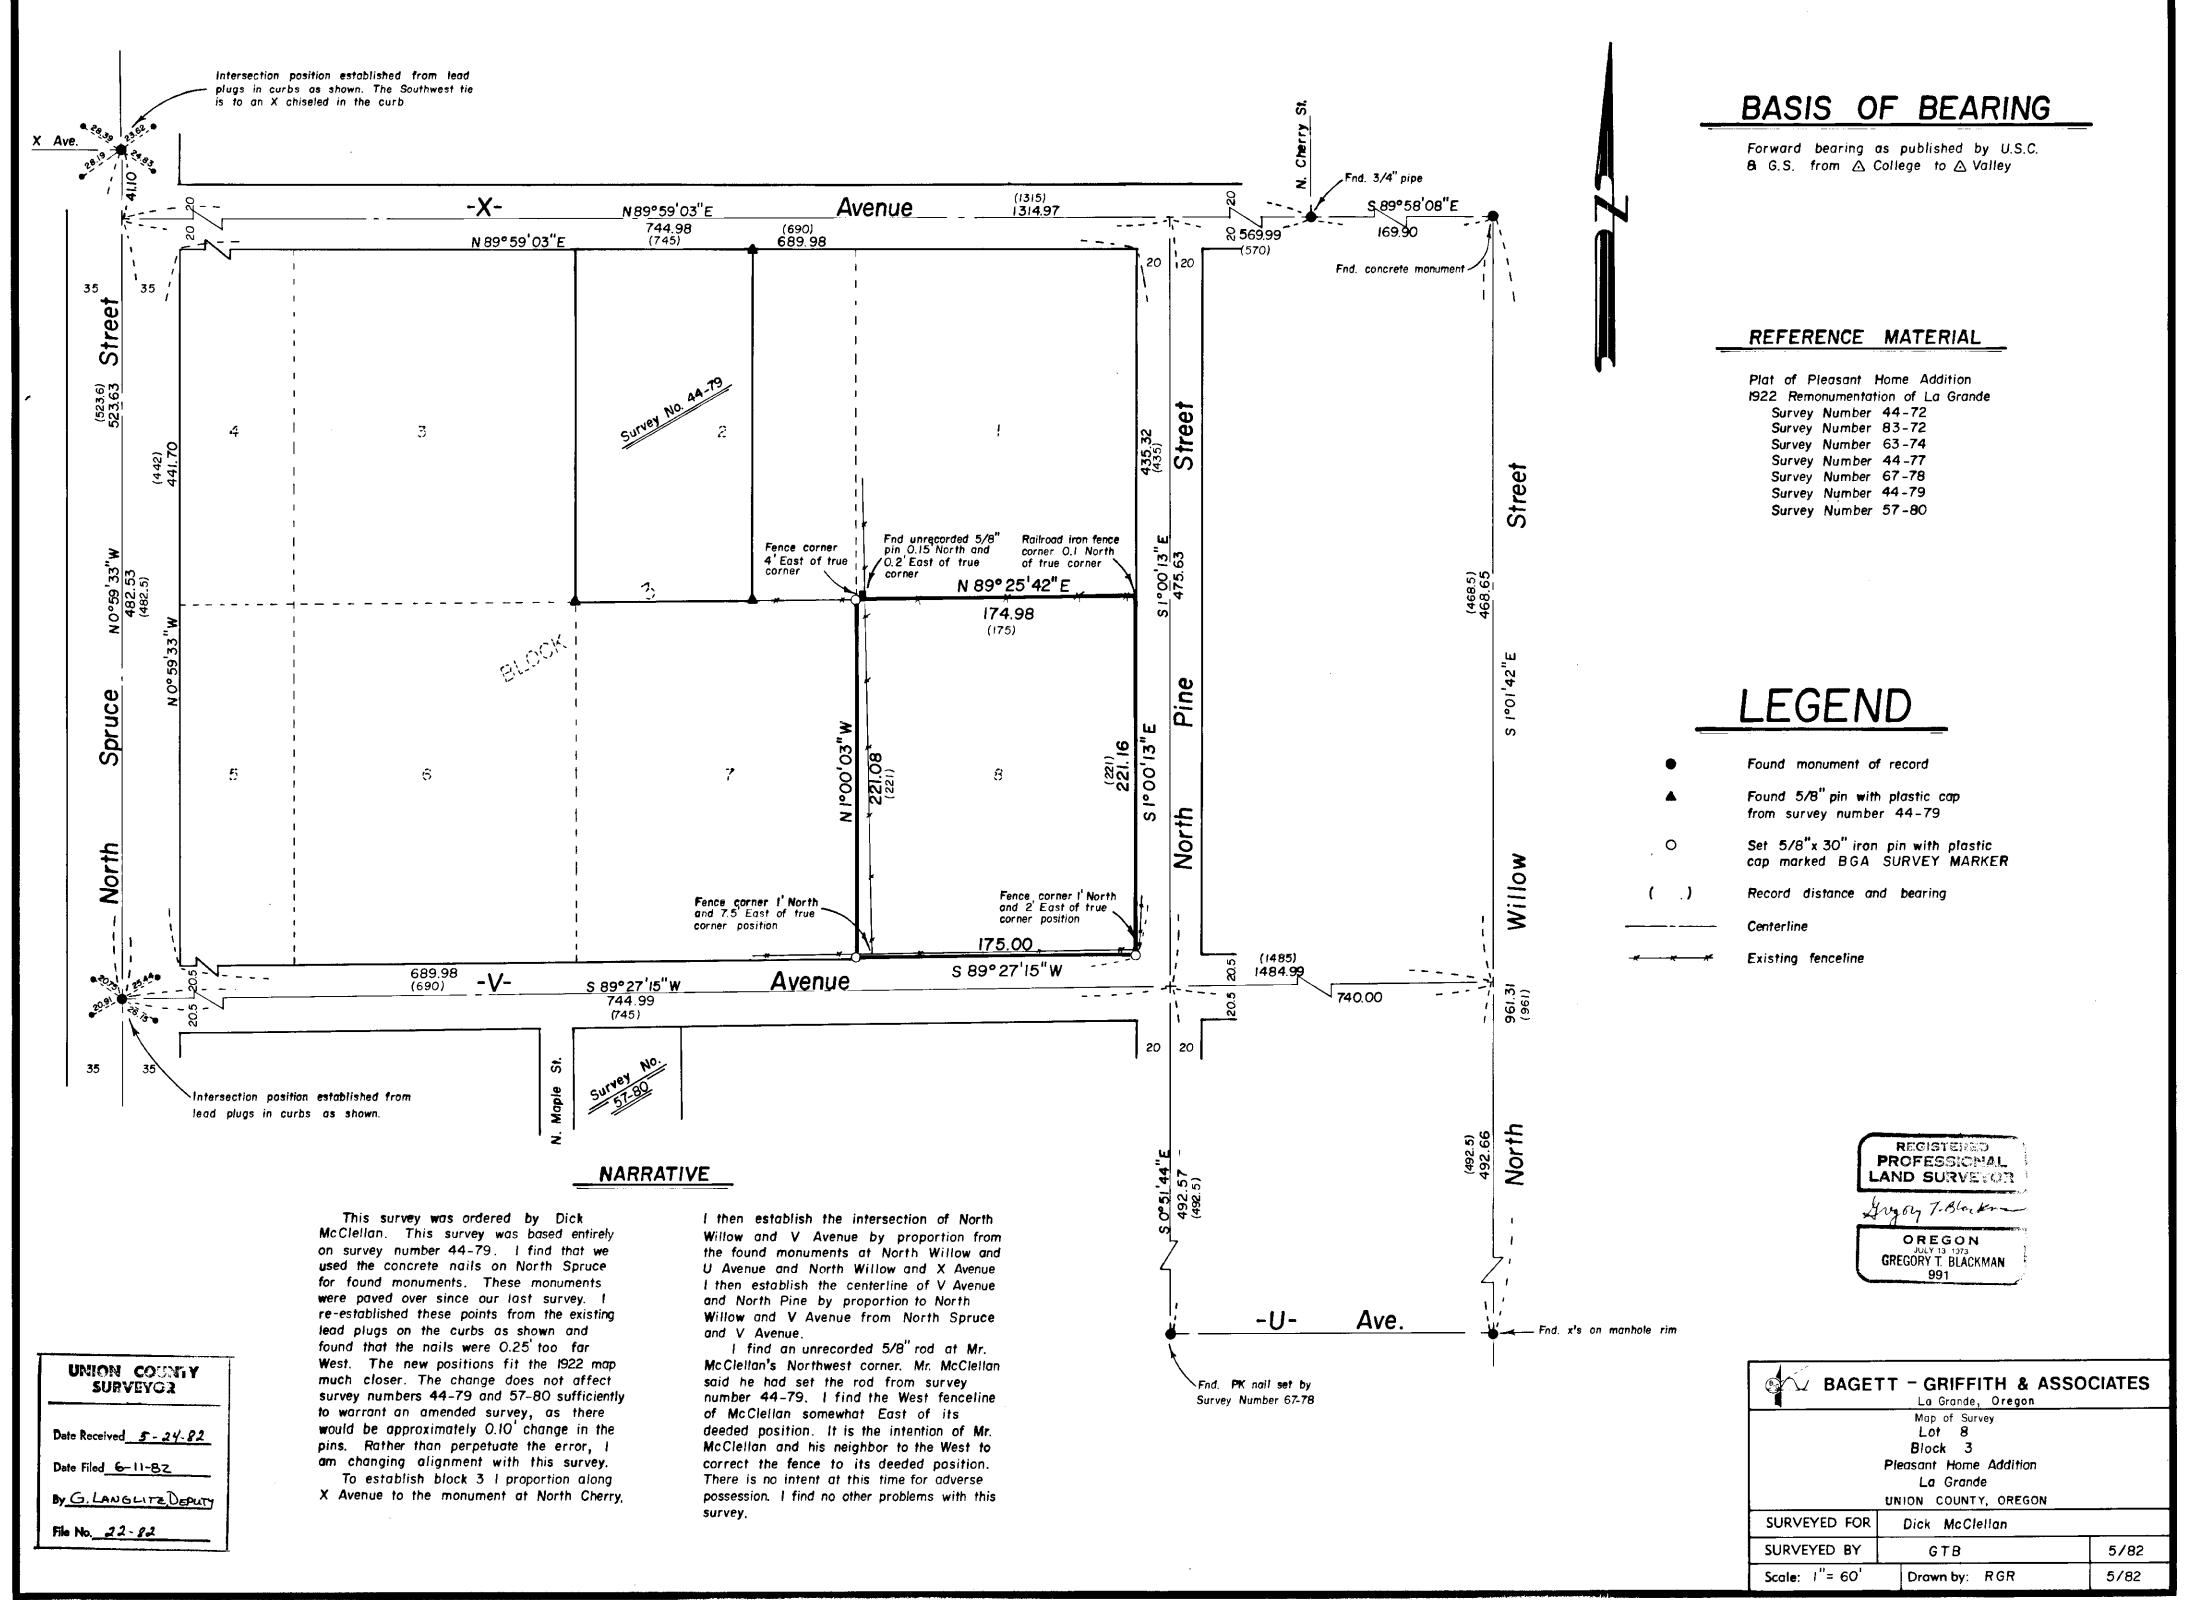

2-82