

Basis of Bearing

N0°03'46"E As shown per record survey #72-77

Legend

- Found Monument as described
- △ Swing tie, lead plug with tack
- set 5/8" x 30" iron rod with plastic cap marked CKA 0119LS
- point no iron rod set

Reference Material

Union County Record Surveys Nos 83-71, 72-77, 12-79
 Union County Microfilm Documents 72173,
 72174, 72175

Narrative of Survey


This survey was performed at the request of Mr. Shaw to locate his property corners. By utilizing data from surveys Nos 72-77 & 83-71 it was possible to locate C of Main Street, from which the location of subject property was determined.
 His property lines as established fit existing fences etc. within reason, the only variant is the position of the garage, for which Mr. Shaw has obtained easements as a accomodation.

Legal Description

Starting at a point which is N0°01'20"E 1338.54 feet & S89°43'49"E 1320.79 feet of the corner which is common to Sections 13, 18, 19 & 24 T4S, R40E W.M.; Thence S0°03'46"W 750.43 feet; Thence N89°56'14"W 30 feet to the true Point of Beginning.
 Thence N89°56'14"W 115 feet;
 Thence S0°03'46"W 100 feet;
 Thence S89°56'14"E 115 feet;
 Thence N0°03'46"E 100 feet to the true Point of Beginning.

UNION COUNTY SURVEYOR
Date Received 7-29-82
Date Filed 8-9-82
By G. LAUGLITE, DEPUTY
File No. 33-82

This Plat is a Revision
to Record Survey No. 40-81

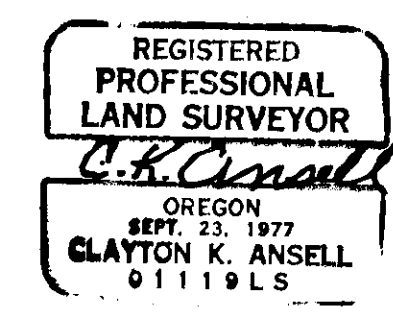

Property Survey Located in the SW 1/4 SW 1/4 of Sec 18 T4S R40E W.M.	
For: Herbert E. Shaw	
By: C.K. Ansell	
Scale: 1"=100'	Date 7-30-82