35-82

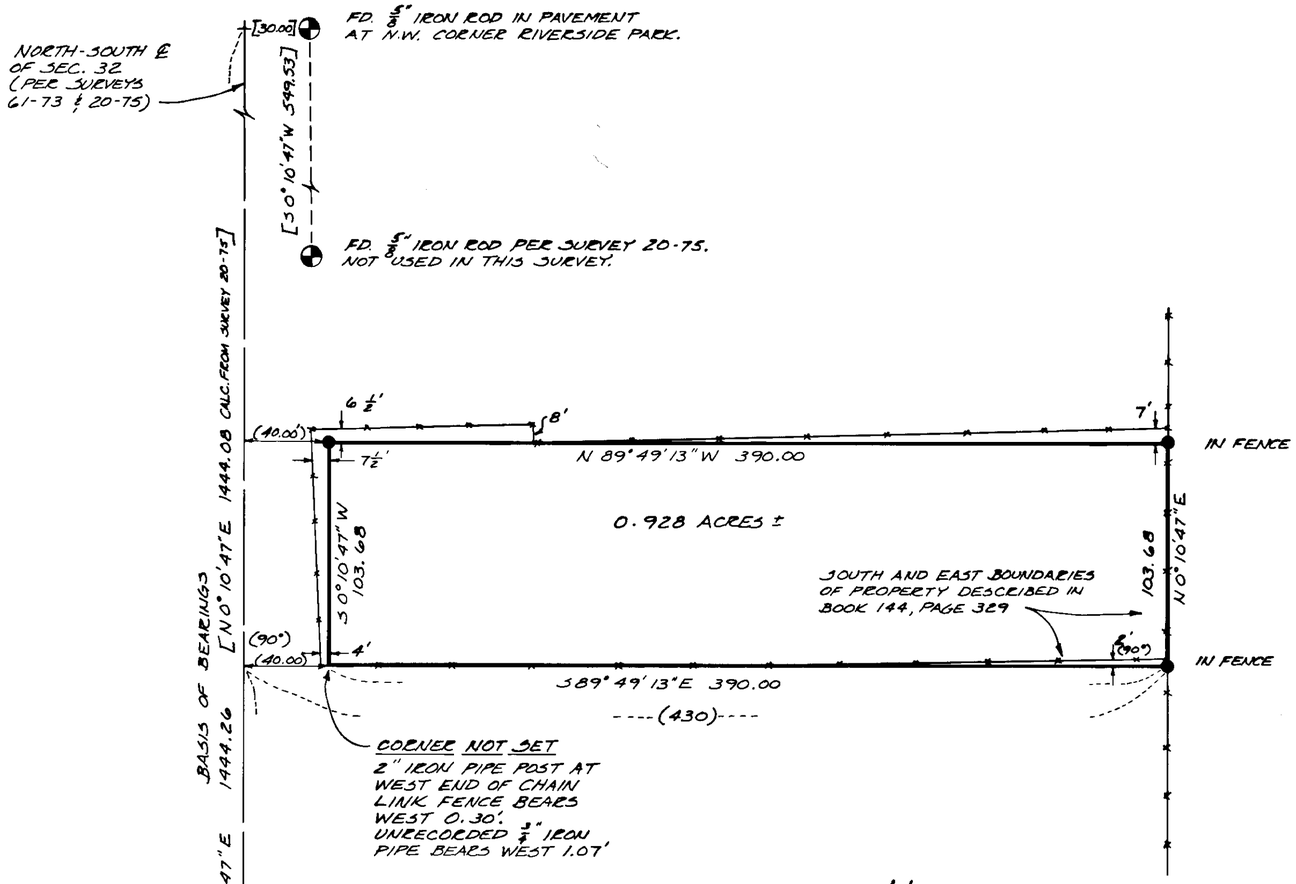

BASIS OF BEARINGS

N0°10'47"E ALONG N-S ℄ OF SECTION 32 PER SURVEY 20-75

LEGEND

- FOUND MONUMENT AS DESCRIBED
- SET ⅝" x 30" IRON ROD (REBAR) WITH YELLOW PLASTIC CAP MARKED "A.P.&A."
- FENCELINE
- ( ) RECORD DIMENSION PER DEED
- [ ] RECORD SURVEY DIMENSION

REFERENCE MATERIAL

UNION COUNTY DEED RECORDS:
BOOK 144, PG 329
" 123, " 451
" 135, " 421

UNION COUNTY RECORD SURVEYS:
61-73 20-75
18-74 24-77

NARRATIVE

THIS SURVEY WAS PERFORMED AT THE REQUEST OF DONNA C. MEULI IN ORDER TO DESCRIBE A PORTION OF HER PROPERTY IN CONNECTION WITH A LAND TRANSFER TO AN ADJOINING OWNER.

THE SOUTH, WEST AND EAST LINES OF THE PARCEL SHOWN WERE ESTABLISHED BASED ON PRIOR SURVEY RECORDS AND DEED INFORMATION AS SHOWN. THE NORTH LINE WAS FIELD LOCATED BY OUR CLIENT ALONG A PORTION OF AN EXISTING FENCELINE.

UNION COUNTY SURVEYOR

Date Received 8-20-82
Date Filed 8-20-82
By G. LANGLITZ, DEPUTY
File No. 35-82

REGISTERED PROFESSIONAL LAND SURVEYOR
OREGON
JULY 22, 1977
GARY L. LANGLITZ
1099

MAP OF SURVEY

LOCATED IN SW 1/4 SE 1/4 SECTION 32, T.2S, R.3BE WILLAMETTE MERIDIAN
UNION COUNTY, OREGON

FOR: DONNA C. MEULI NORTH SPRUCE ST. LAGRANDE, OR. 97850

SCALE: 1" = 50'
DATE: JULY, 1982
JOB NO. 2695-50

anderson perry & associates, inc.
engineering • surveying • materials testing
LA GRANDE, ORE. & WALLA WALLA, WASH.

SHEET NO. 1/1

35-82