

NOTES

Bearings are based upon a survey by Bogett-Griffith and Associates for Boise Cascade Corporation, dated January 1981, Union County Survey Records drawing no. 4-81. The above mentioned survey was based on solar observations.

All field notes on traverses for Sections 3 and 4 are in Book 1. Notes used to set Aluminum Caps are in Book 1, Section C, Pages 1-5. Accessory ties for all corners set are described in Certified Record of Land Monumentation.

All found corners are part of a closed traverse. Computations for all corners set are based on the Manual of Surveying Instruction 1973, Chapter 5.

All lines posted were performed by the Offset Method from the traverse lines.

HISTORY

Survey by Duane L. Griffith, Professional Land Surveyor, Oregon License No. 644, done in December 1980 for Boise Cascade Corporation.

Corners monumented from existing evidence by Wayne O. Harris, Professional Land Surveyor, Oregon License No. 346, in 1978, for the US Forest Service.

Surveys in Sections 3 and 4, Township 3 North, Range 39 East, W.M. were performed by Frank W. Campbell in 1884 under G.L.O. Contract No. 438, dated May 10, 1884.

Survey of south line of Township 4 North, Range 39 East, W.M. was by Rufus S. Moore in 1882, under G.L.O. Contract No. 437.

LEGAL DESCRIPTIONS

Section 3
U.S.D.A., Forest Service ownership; all of Section 3 excepting the South half of the Southeast one-quarter of Section 3, Township 3 North, Range 39 East of the Willamette Meridian.


Section 4
U.S.D.A., Forest Service ownership; all of section 4, Township 3 North, Range 39 East of the Willamette Meridian.

I, David H. Krumbein, a registered land surveyor in the State of Oregon, hereby certify that this plat and the notes hereon are a correct representation of a survey I performed during July 1982, at the request of the U.S.D.A., Forest Service in accordance with the statutes of the State of Oregon and with the Articles of my contract.

Dated this 2 day of August, 1982.

David H. Klein (S) David H. Krumbein
Registered Land Surveyor
Oregon License No. 933

- denotes brass cap of record found
- ◉ denotes 2 1/2 in. x 30 in. aluminum pipe with 2 1/2 in. aluminum cap set from existing evidence
- denotes 2 1/2 in. x 30 in. aluminum pipe with 2 1/2 in. aluminum cap set by proportionate method
- () denotes G.L.O. record bearing, distance, or acreage
- denotes U.S.D.A., Forest Service Boundary and posted line
- - - denotes existing fence line

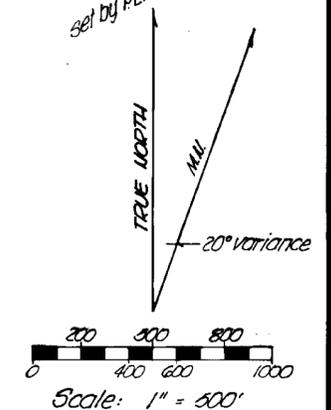

UNION COUNTY SURVEYOR

Date Received 8-13-82
Date Filed 8-20-82
By G. LANGRISH, DEPUTY
File No. 37-82

REGISTERED PROFESSIONAL LAND SURVEYOR
David H. Klein
DAVID H. KRUMBEIN
933

KRUMBEIN ENGINEERING CO.
ENGINEERS - SURVEYORS - PLANNERS
221 S. Main, Pendleton, Oregon

Fry-Mottet Cadastral Survey for
U.S.D.A., FOREST SERVICE
Sections 3 and 4, T3N, R39E, W.M.

SCALE 1" = 500'
DATE August 2, 1982
DRN BY MA
CKD BY D.H.K.
DRNG NO. 82-26C