

UNION COUNTY SURVEYOR
 Date Received 10-4-82
 Date Filed 10-4-82
 By G. Langlitz, Deputy
 File No. 42-82

NARRATIVE

This survey was performed to mark part of the boundary of the Willowa-Whitman National Forest in Sections 8, 17, 18, 19, 20, 21 & 22, T2S, R36E, W.M.
 A diligent effort was made to restore all existing corners to their original position. Search areas were calculated from a control traverse tying in found original monuments along the range line and within the township. Terrain calls made in the original notes were also used to establish search areas for original corner positions. Diligent searches were made for all corner positions between found original corner positions. The corner positions found are shown on the map.

The Blue Mountain Forest Mayside (B.M.F.W.) boundary description is tied to the northerly right-of-way line of the old Oregon Trail Highway at the intersection with the east line of the NW 1/4 of the SW 1/4 of Section 21 and at the intersection with the east line of the SW 1/4 of Section 21. The B.M.F.W. boundary description is also tied to the north 1/4 corner of Section 20, the East 1/4 corner of Section 21 and the northerly right-of-way line of the U.P.R.R. No evidence could be found of any monumentation or record of monumentation for the right-of-way of the old Oregon Trail Highway or the U.P.R.R. Therefore the existing center lines were tied in to use as control for calculating the northerly right-of-way lines. BMFW-34 position was established on the north line of Section 20, the distance from the north 1/4 corner of Section 20 being proportionate to the calculated distance based on survey from the N 1/4 corner of Section 20 and BMFW 27/10 and the distance between the two said points calculated based on deed calls, the calculated bearing and distance based on survey between BMFW 34 and BMFW 27/10 is S48°26'31"E, 5126.983 feet compared to the calculated data from the deed calls being S48°18'E, 5095.477 feet. The corner positions between these two corners were established by rotating the deed calls counter-clockwise 0°08'31" to fit true bearings and calculating the distances using a scale factor, obtained by dividing the calculated surveyed distance by the calculated deed distance, multiplied by the deed distances. This method was also used to establish BMFW 10 between BMFW 9/11 and the East 1/4 corner S21.



Wood posts, 4"x4" square, were found near the BMFW boundary but no consistency could be found between the posts and record distances. No records could be found as to when or who these posts were set by and so they were not used.

REFER TO NARRATIVE
 DRAINER 1/3


BASIS OF BEARING

POLARIS OBSERVATIONS TAKEN AT TRAVERSE POINT AA-7, 740 FT. EAST OF THE NORTH 1/4 CORNER OF SECTION 8, & THE TRAVERSE POINT E-5EJ-IT-E, 900 FT. EAST & 100 FT. NORTH OF THE SOUTH 1/4 CORNER OF SECTION 17.

MEAN MAGNETIC DECLINATION
 18 1/2° EAST

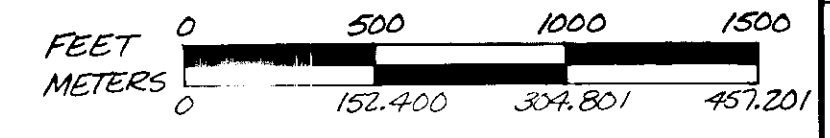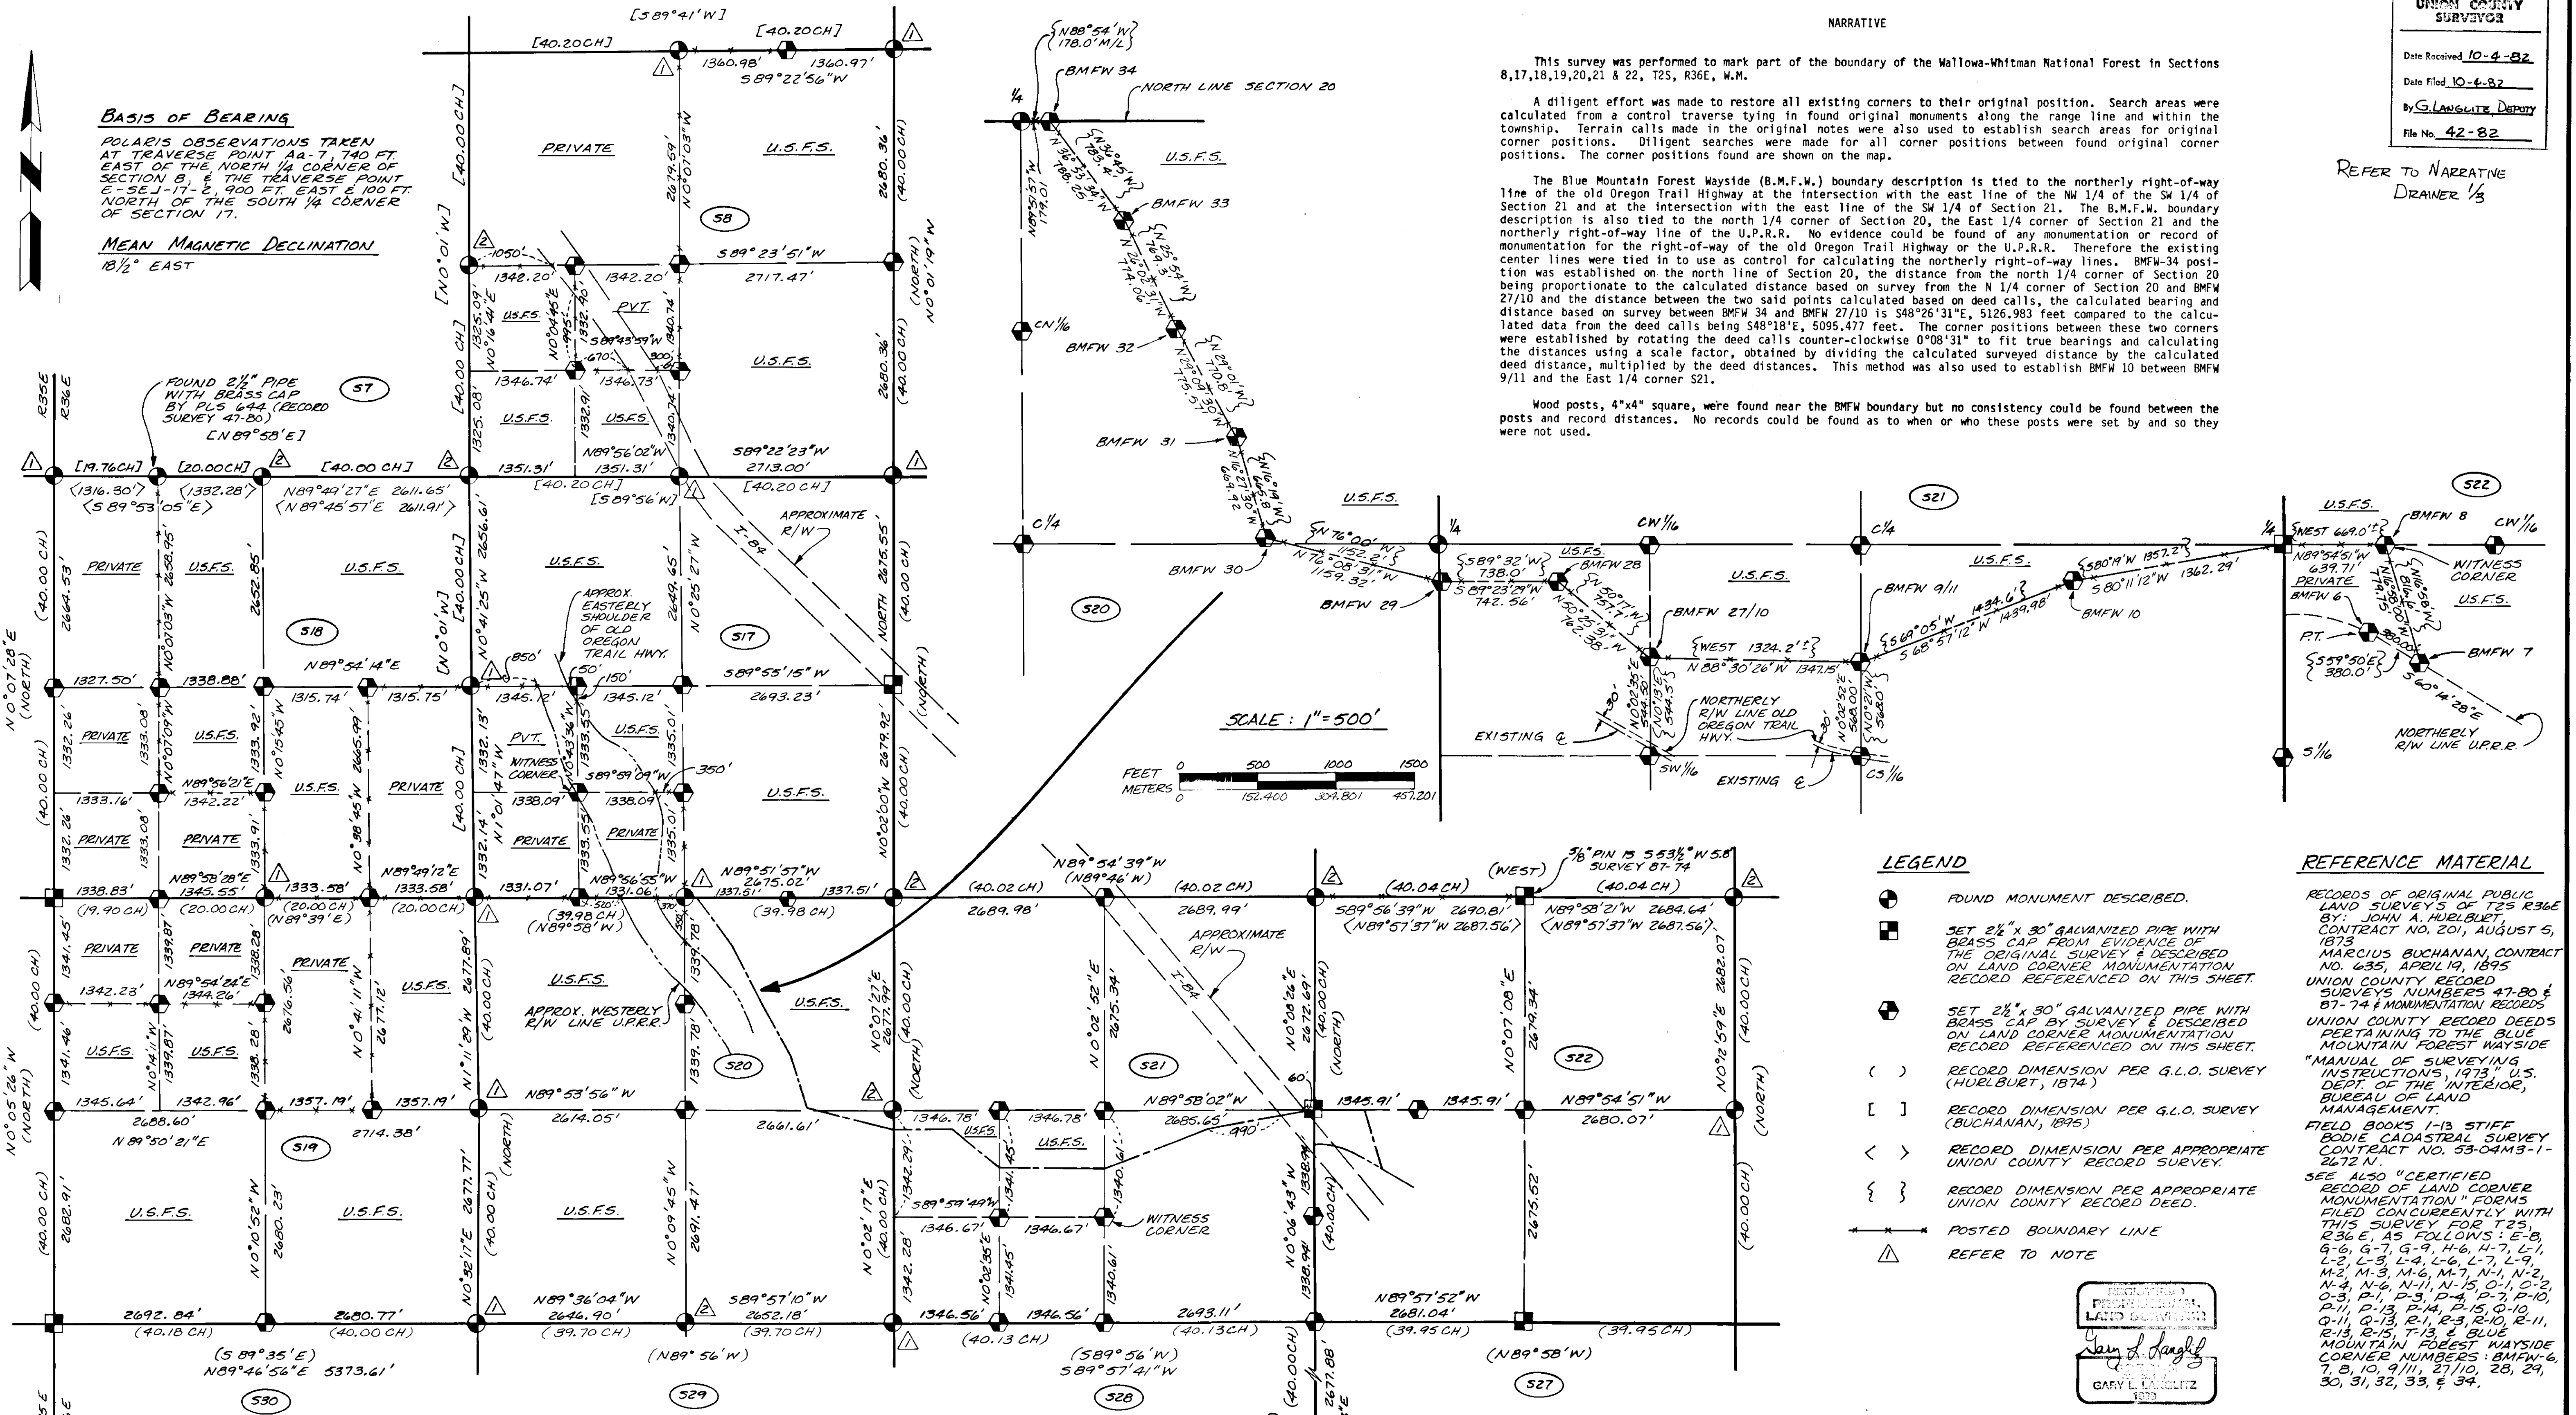

SCALE: 1" = 1000'

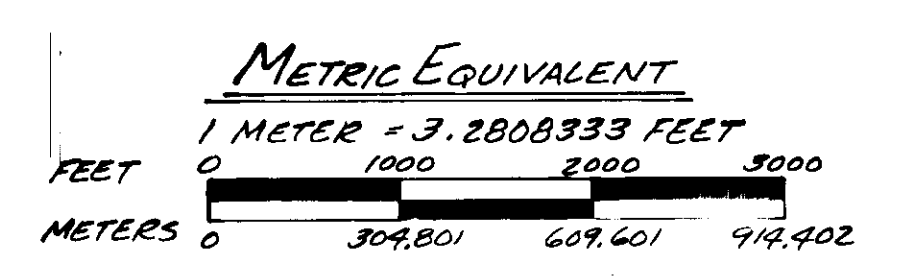

LEGEND

- FOUND MONUMENT DESCRIBED.
- SET 2 1/2" x 30" GALVANIZED PIPE WITH BRASS CAP FROM EVIDENCE OF THE ORIGINAL SURVEY & DESCRIBED ON LAND CORNER MONUMENTATION RECORD REFERENCED ON THIS SHEET.
- ⊕ SET 2 1/2" x 30" GALVANIZED PIPE WITH BRASS CAP BY SURVEY & DESCRIBED ON LAND CORNER MONUMENTATION RECORD REFERENCED ON THIS SHEET.
- () RECORD DIMENSION PER G.L.O. SURVEY (HUELBUET, 1874)
- [] RECORD DIMENSION PER G.L.O. SURVEY (BUCHANAN, 1895)
- < > RECORD DIMENSION PER APPROPRIATE UNION COUNTY RECORD SURVEY.
- { } RECORD DIMENSION PER APPROPRIATE UNION COUNTY RECORD DEED.
- *— POSTED BOUNDARY LINE
- △ REFER TO NOTE

REFERENCE MATERIAL

RECORDS OF ORIGINAL PUBLIC LAND SURVEYS OF T2S R36E BY: JOHN A. HUELBUET, CONTRACT NO. 201, AUGUST 5, 1873
 MARCIUS BUCHANAN, CONTRACT NO. 635, APRIL 19, 1895
 UNION COUNTY RECORD SURVEYS NUMBERS 47-80 & 87-74 & MONUMENTATION RECORDS
 UNION COUNTY RECORDED DEEDS PERTAINING TO THE BLUE MOUNTAIN FOREST MAYSIDE
 "MANUAL OF SURVEYING INSTRUCTIONS, 1973" U.S. DEPT. OF THE INTERIOR, BUREAU OF LAND MANAGEMENT.
 FIELD BOOKS 1-13 STIFF BODIE CADASTRAL SURVEY CONTRACT NO. 53-04M3-1-2672 N.
 SEE ALSO "CERTIFIED RECORD OF LAND CORNER MONUMENTATION" FORMS FILED CONCURRENTLY WITH THIS SURVEY FOR T2S, R36E, AS FOLLOWS: E-8, G-6, G-7, G-9, H-6, H-7, L-1, L-2, L-3, L-4, L-6, L-7, L-9, M-2, M-3, M-6, M-7, N-1, N-2, N-4, N-6, N-11, N-15, O-1, O-2, O-3, P-1, P-3, P-4, P-7, P-10, P-11, P-13, P-14, P-15, Q-10, Q-11, Q-13, R-1, R-3, R-10, R-11, R-13, R-15, T-13 & BLUE MOUNTAIN FOREST MAYSIDE CORNER NUMBERS BMFW-6, 7, 8, 10, 9/11, 27/10, 28, 29, 30, 31, 32, 33, & 34.

NOTES:

- △ FOUND 2 1/2" PIPE WITH BRASS CAP SET BY B.L.M. FROM ORIGINAL EVIDENCE.
- △ FOUND 2 1/2" PIPE WITH BRASS CAP SET BY P.L.S. 381 FROM ORIGINAL EVIDENCE

NOTE:
 BOUNDARY LINE POSTING CONSISTS OF PLACING STEEL POSTS INTERVISIBLY ALONG AND WITHIN ONE FOOT OF THE TRUE LINE WITH A FOREST SERVICE SIGN ATTACHED INDICATING THE LOCATION OF NATIONAL FOREST LAND. TRUE LINE WAS ESTABLISHED BETWEEN EXISTING CORNERS BY DIRECT SIGHTING OR BY CALCULATED OFFSETS FROM A RANDOM TRAVERSE. MEASURED BEARINGS & DISTANCES ARE NOT SHOWN ON LINES WHERE THE CONTROLLING CORNERS WERE EXISTING DUE TO THE USE OF A LOW ORDER SURVEY TO LOCATE THE TRUE LINE.

I, Gary L. Langlitz, a registered land surveyor in the State of Oregon, hereby certify that this plat and the notes hereon, or attached, are a correct representation of a survey I performed during July, 1981, September, 1982, for the U.S. Forest Service, in accordance with the statutes of the State of Oregon and with the Articles of the Stiff Bodie Cadastral Survey, Contract No. 53-04M3-1-2672N.

Gary L. Langlitz (s)
 Gary L. Langlitz
 Registered Land Surveyor
 Oregon License 1099

STIFF BODIE CADASTRAL SURVEY
 CONTRACT NO. 53-04M3-1-2672N
 LOCATED IN SECTIONS 8, 17, 18, 19, 20, 21, 22, 27 & 28 T2S, R36E, WILLAMETTE MERIDIAN, UNION COUNTY, OREGON

FOR: U.S. DEPT. OF AGRICULTURE, U.S. FOREST SERVICE

SCALE: AS SHOWN

DATE: 1982

JOB NO. 830-90

anderson perly & associates, inc.
 engineering - surveying - materials testing
 LA GRANDE, ORE. & WALLA WALLA, WASH.


SHEET NO. 1/3

CERTIFIED RECORD OF LAND CORNER MONUMENTATION

History of original corner establishment:

Not previously established.

Index File No. BMFW-6

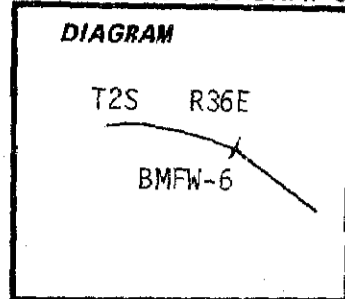

(SEE SURVEY 42-82)

Description of corner evidence found:

None.

UNION COUNTY SURVEYOR	
Date Received	_____
Date Filed	_____
By	_____
File No.	NARRATIVE DRAWER 1/3

REFER TO SURVEY 42-82

Description of monument and accessories established to perpetuate the original location of this corner:

Boundary of Blue Mtn. Forest wayside determined by survey.

At surveyed point: Set 2 1/2"x30" galvanized pipe with brass cap stamped:

Set pipe 24" in ground with mound of stone to cap.

From which:

- A Lodgepole Pine 6" dia. bears N77°W, 21.3 ft., scribed BMFW 6 BT.
- A Pond. Pine 22" dia. bears N 4°W, 66.4 ft., scribed BMFW 6 BT.


Attached brass washer stamped LS 1099 to foot blaze of BT's. Attached 54-3 and 54-4 signs to BT's and painted blazes and 6" band around BT's red. Attached 54-9 sign to metal post 5 ft. S.E. of corner.

Corner falls on small fill on north side of U.P.R.R. 50' from centerline and 20' north of fence. BMFW 6 is the beginning of the curve in the northerly R/W.

Compass Declination: 18 1/2°

I hereby certify the above described corner monument and/or accessories was established as described on December 14, 1981.

Witnesses: Rodger Orton
Gary Langlitz

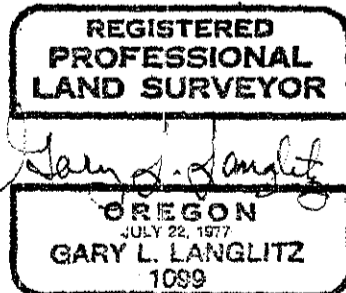


Office of..... Surveyor..... County of..... Union.....
 State of..... Oregon....., I hereby certify that the within instrument was filed in this office
 for record on the... 4... day of... OCTOBER... 1982
 Howard L. Perry by Gary L. Langlitz
 (COUNTY OFFICIAL) DEPUTY

CERTIFIED RECORD OF LAND CORNER MONUMENTATION

Index File No. BMFW-7

History of original corner establishment:

Not previously established.

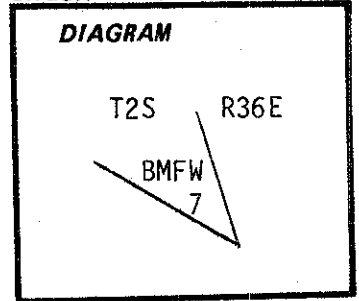

(SEE SURVEY 42-82)

Description of corner evidence found:

None.

UNION COUNTY SURVEYOR

Date Received _____

Date Filed _____

By _____

NARRATIVE DRAWER 1/3

File No. _____

REFER TO SURVEY 42-82

Description of monument and accessories established to perpetuate the original location of this corner:


Boundary of Blue Mtn. Forest wayside determined by survey.

At surveyed point set 2 1/2"x30" galvanized pipe with brass cap stamped:
Set pipe 24" in ground with stone to cap.

From which:

A Pond. Pine 12" dia. bears N 79°E, 121.3 ft., scribed BMFW 7 BT.

A Pond. Pine 16" dia. bears N 40°W, 126.0 ft., scribed BMFW 7 BT.

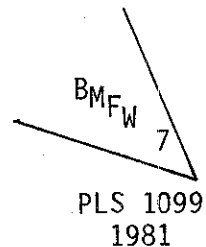


Attached brass washer stamped LS 1099 to foot blaze of BT's. Attached 54-3 and 54-4 signs to BT's. Painted blazes and 6" band around BT's red. Attached 54-2 and 54-9 signs to metal post 5 ft. N.W. of corner. Corner falls in large opening 6 ft. South of E-W fence and 50 ft. Northeast of centerline UPRR. This point is on the northerly line of the UPRR R/W.

Compass Declination: 18 1/2° East

I hereby certify the above described corner monument and/or accessories was established as described on Dec. 14, 1981.

Witnesses: Rodger Orton
Gary Langlitz

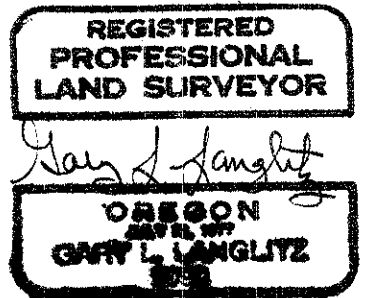

Office of... Surveyor County of... Union

State of... Oregon, I hereby certify that the within instrument was filed in this office

for record on the... 4 ... day of... OCTOBER 1982

Howard L. Perry by Gary L. Langlitz


(COUNTY OFFICIAL) (DEPUTY)

CERTIFIED RECORD OF LAND CORNER MONUMENTATION

Index File No. BMFW-8WC

History of original corner establishment:

Not previously established

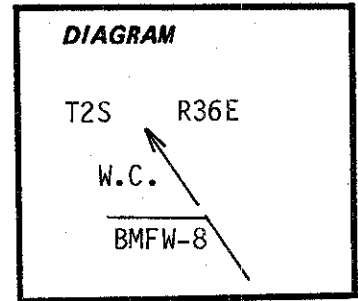

(SEE SURVEY 42-82)

Description of corner evidence found:

None

UNION COUNTY SURVEYOR	
Date Received	_____
Date Filed	_____
By	_____
File No.	NARRATIVE DRAWER 1/3

REFER TO SURVEY 42-82


Description of monument and accessories I established to perpetuate the original location of this corner:

Boundary of Blue Mtn. Forest Wayside determined by survey. The location for BMFW-8 falls in channel of small creek 10 ft. wide therefore set 2 1/2"x30" galvanized pipe with brass cap stamped: True corner position is N16° 58' W, 50.00' of monument. For witness corner to BMFW-8 true location, set pipe 24" in ground with stones to cap from which:

A Ponderosa Pine 20" diameter bears N36°E, 85.5 ft. scribed W.C. BMFW 8 BT.

An Engleman Spruce 18" dia. bears S23°E, 87.6 ft. scribed WC BMFW 8 BT.

Attached 54-3 and 54-4 signs to BT's. Attached brass washer stamped LS1099 to foot blaze of BT's. Painted blazes and 6" band around BT's. Attached 54-2 and 54-9 signs to metal post 5' S.E. of witness corner. Witness corner falls 50' south and 50' west of small creek course S.E. also 160 ft. south of N.W. pipeline gas line clearing.

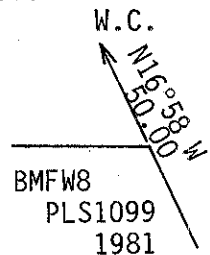

Compass Declination: 18 1/2° East

I hereby certify the above described corner monument and/or accessories was established as described on December 14, 1981.

Witnesses: Rodger Orton
Gary Langlitz




Surveyor _____ Union
 Office of _____ County of _____
 State of Oregon _____, I hereby certify that the within instrument was filed in this office
 for record on the 4 day of OCTOBER, 1982
 Howard L. Perry _____ by Gary Langlitz _____
 (COUNTY OFFICIAL) (DEPUTY)

CERTIFIED RECORD OF LAND CORNER MONUMENTATION

Index File No. BMFW 9-11

History of original corner establishment:

Not previously established

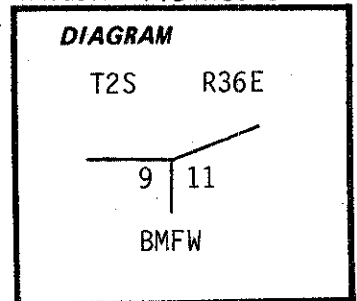

(SEE SURVEY 42-82)

Description of corner evidence found:

None

UNION COUNTY SURVEYOR	
Date Received	_____
Date Filed	_____
By	_____
NARRATIVE DRAWER 1/3	
File No.	_____


REFER TO SURVEY 42-82

Description of monument and accessories I established to perpetuate the original location of this corner:

Boundary of Blue Mtn. Forest Wayside determined by survey

At surveyed point:

Set 2 1/2"x30" galvanized pipe with brass cap attached 25" in the ground stamped:

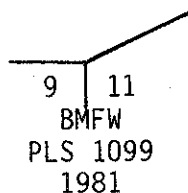

From which:

A 10" Pond. Pine bears S38 1/2°W 30.1 ft. scribed BMFW 9/11 BT

A 10" Doug. Fir bears N27° W 35.3 ft. scribed BMFW 9/11 BT

Attached 54-3 and 54-4 signs to BT's. Painted blazes and 6" red ring around BT's. Attached brass washers LS 1099 to foot blazes. Set metal post 5" westerly with 54-2 sign. Set metal post 5' easterly with 54-2 and 54-9 signs. Corner falls on slight east slope 300' south of power line.

Compass Declination: 18 1/2° East

I hereby certify the above described corner monument and/or accessories was established as described on December 3, 1981.

Witnesses: Loren Huntsman
Gary Langlitz

**REGISTERED
PROFESSIONAL
LAND SURVEYOR**

Gary L. Langlitz
OREGON
JULY 22, 1877
GARY L. LANGLITZ
 1099


Office of..... Surveyor..... County of..... Union.....
 State of..... Oregon..... I hereby certify that the within instrument was filed in this office
 for record on the... A... day of... OCTOBER... 1982
 Howard L. Perry..... by Gary L. Langlitz.....
(COUNTY OFFICIAL) (DEPUTY)

CERTIFIED RECORD OF LAND CORNER MONUMENTATION

Index File No. BMFW-10

History of original corner establishment:

Not previously established.

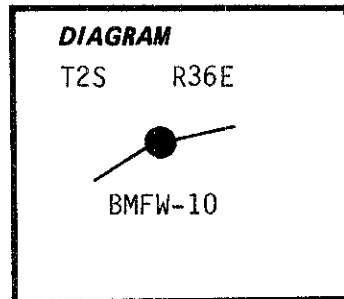

(SEE SURVEY 42-82)

Description of corner evidence found:

None

UNION COUNTY SURVEYOR	
Date Received	_____
Date Filed	_____
By	_____
NARRATIVE DRAWER 1/3	
File No.	_____

REFER TO SURVEY 42-82

Description of monument and accessories | established to perpetuate the original location of this corner:

Boundary of Blue Mtn. Forest Wayside determined by survey

At surveyed point set 2 1/2" x 30" galvanized pipe with brass cap attached 25" in the ground stamped:

From which:

A 16" Pond. Pine bears N82°W 39.1 ft., scribed "BMFW 10 BT" on a double blaze.

A 14" Tamarack bears N56 1/2° E 24.9 ft., scribed "BMFW 10 BT" on a double blaze.

Attached 54-3 and 54-4 signs to BT's. Painted blazes and 6" red ring around BT's. Attached brass washers LS 1099 to foot blazes. Set metal post 5' easterly on wayside boundary with 54-2 and 54-9 sign. Set metal post 5' westerly on wayside boundary with 54-2 sign.

BMFW-10
OR PLS 1099
1981

Corner falls on northeast slope 165' north of dirt road.

Compass Declination: 18 1/2° East.

I hereby certify the above described corner monument and/or accessories was established as described on December 3, 1981.

Witnesses: Gary Langlitz
Loren Huntsman




Surveyor _____ Union _____
 Office of _____ County of _____
 State of Oregon, I hereby certify that the within instrument was filed in this office
 for record on the 4 day of OCTOBER, 1982
 Howard L. Perry by Gary L. Langlitz
 (COUNTY OFFICIAL) (DEPUTY)

CERTIFIED RECORD OF LAND CORNER MONUMENTATION

Index File No. BMFW 27-10

History of original corner establishment:

Not previously established

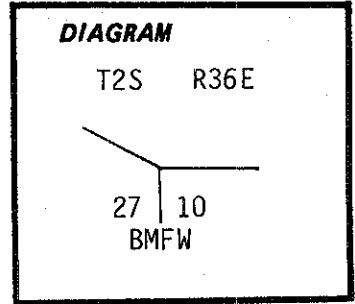

(SEE SURVEY 42-82)

Description of corner evidence found:

None

UNION COUNTY SURVEYOR

Date Received _____

Date Filed _____

By _____

NARRATIVE DRAWING 1/3

File No. _____

REFER TO SURVEY 42-82

Description of monument and accessories I established to perpetuate the original location of this corner:

Boundary of Blue Mtn. Forest Wayside determined by survey
At surveyed point set 2 1/2"x30" galvanized pipe with brass cap stamped:

Set pipe 14" in ground with mound of stone and dirt to cap.

From which:

A Ponderosa Pine 12" dia. bears N21°E, 144.8 ft. scribed
BMFW 27/10 BT.


A Ponderosa Pine 14" dia. bears N42°W, 136.1 ft. scribed
BMFW 27/10 BT.

Attached brass washer stamped 1099 to foot blaze of both BT's.
Attached 54-3 and 54-4 signs to both Bt's and painted blazes and
6" band around BT's red. Attached 54-2 and 54-9 signs to metal
post 5' west of cor. and 54-2 sign to metal post 5' east of cor.
Cor. falls on steep rocky south slope 250' south of old E-W road.

Compass Declination: 18 1/2° East

I hereby certify the above described corner monument and/or
accessories was established as described on December 11, 1981.

Witnesses: Rodger Orton
Gary Langlitz

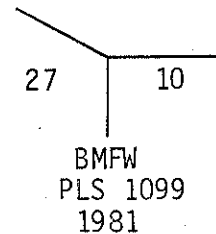

REGISTERED PROFESSIONAL LAND SURVEYOR

Gary L. Langlitz

OREGON
JULY 22, 1977
GARY L. LANGLITZ
1099


Office of..... Surveyor..... County of..... Union
Oregon
State of..... I hereby certify that the within instrument was filed in this office
for record on the 4 day of OCTOBER..... 1982
Howard L. Perry..... by *Gary L. Langlitz*
(COUNTY OFFICIAL) (DEPUTY)

CERTIFIED RECORD OF LAND CORNER MONUMENTATION

Index File No. BMFW-28

History of original corner establishment:

Not previously established

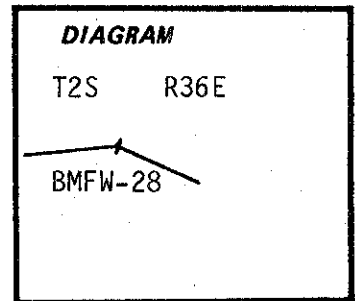

(SEE SURVEY 42-82)

Description of corner evidence found:

None

UNION COUNTY SURVEYOR

Date Received _____

Date Filed _____

By _____

NARRATIVE DRAWER 1/3

File No. _____

REFER TO SURVEY 42-82

Description of monument and accessories established to perpetuate the original location of this corner:

Boundary of Blue Mtn. Forest Wayside determined by survey.

At surveyed point set 2 1/2"x30" galvanized pipe with brass cap attached, 15" in the ground stamped:

BMFW28
PLS1099
1981

From which:

A 12" Douglas Fir bears N24°E 143.5 ft. scribed
BMFW 28 BT

A 14" Pond. Pine bears S70°W 69.8 ft. scribed
BMFW 28 BT

Attached 54-3 and 54-4 signs to BT's. Painted blazes and 6" red ring around BT's. Attached brass washers LS 1099 to foot blazes. Set metal post 5' westerly of monument with 54-2 and 54-9 signs. Set metal post 5' easterly of monument with 54-2 sign.

Corner falls on mostly bare south slope 50' north of dirt road.

Compass Declination: 18 1/2° East

I hereby certify the above described corner monument and/or accessories was established as described on December 3, 1981.

Witnesses: Loren Huntsman
Gary Langlitz




Office of... Surveyor..... County of... Union.....
 State of... Oregon..... I hereby certify that the within instrument was filed in this office
 for record on the... 4... day of... OCTOBER..... 1982
 Howard L. Perry..... by Gary L. Langlitz
 (COUNTY OFFICIAL) (DEPUTY)

CERTIFIED RECORD OF LAND CORNER MONUMENTATION

Index File No. BMFW-29

History of original corner establishment:

Not previously established

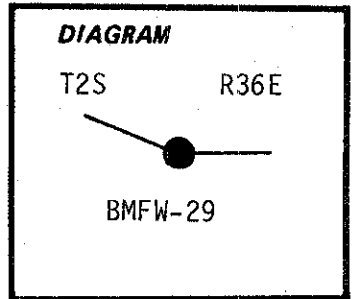

(SEE SURVEY 42-82)

Description of corner evidence found:

None

UNION COUNTY SURVEYOR	
Date Received	_____
Date Filed	_____
By	_____
File No.	NARRATIVE DRAWER 1/3

REFER TO SURVEY 42-82

Description of monument and accessories established to perpetuate the original location of this corner:

Boundary of Blue Mtn. Forest Wayside determined by survey.

At surveyed point set 2 1/2"x30" galvanized pipe with brass cap stamped:
Set pipe 24" in ground with mound of stone to cap.

From which:

A Douglas Fir 14" dia. bears S72°E, 61.2 ft. scribed
BMFW 29 BT

A Ponderosa Pine 10" dia. bears N3°E, 25.0 ft. scribed
BMFW 29 BT.

Attached brass washer stamped LS 1099 to foot blaze of both BT's.
Attached 54-3 and 54-4 signs to both BT's and painted blazes
and 6" band around BT's red. Attached 54-2 and 54-9 signs to
metal post 5' west of Cor. and 54-2 sign 5 ft. East of cor.

Cor. falls on SW slope 50 ft. east of bottom of draw course S.E. and
245 ft. south of east 1/4 S20 in old E-W road.

Compass Declination: 18 1/2° East

I hereby certify the above described corner monument and/or
accessories was established as described on December 11, 1981.

Witnesses: Rodger Orton
Gary Langlitz

BMFW 29
PLS 1099
1981

REGISTERED
PROFESSIONAL
LAND SURVEYOR

Gary L. Langlitz
OREGON
JULY 22, 1977
GARY L. LANGLITZ
1099


Office of..... Surveyor..... County of..... Union.....
Oregon
State of..... Oregon..... I hereby certify that the within instrument was filed in this office
for record on the 4 day of OCTOBER, 1982
Howard L. Perry by *Gary L. Langlitz*
(COUNTY OFFICIAL) (DEPUTY)

CERTIFIED RECORD OF LAND CORNER MONUMENTATION

History of original corner establishment:

Not previously established

Index File No. BMFW-30

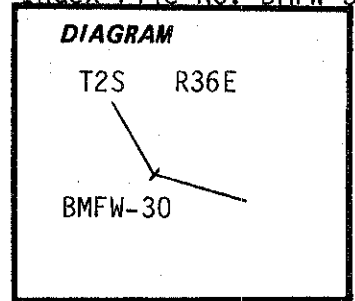

(SEE SURVEY 42-82)

Description of corner evidence found:

None


UNION COUNTY SURVEYOR	
Date Received	_____
Date Filed	_____
By	_____
NARRATIVE DRAWER 1/3	
File No.	_____

REFER TO SURVEY 42-82

Description of monument and accessories established to perpetuate the original location of this corner:

Boundary of Blue Mtn. Forest Wayside determined by survey.

At surveyed point set 2 1/2"x30" galvanized pipe with brass cap stamped:
Set pipe 16" in ground with mound of stone to cap.

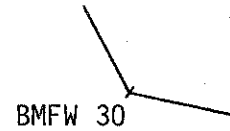

PLS 1099

1981

From which:

A Douglas Fir 24" dia. bears S79°W 40.5 ft. scribed
BMFW 30 BT.


A Ponderosa Pine 15" dia. bears N5°W 66.6 ft. scribed
BMFW 30 BT.

Attached brass washer stamped LS1099 to foot blaze of both BT's.
Attached 54-3 and 54-4 signs to both BT's and painted blazes
and 6" band around BT's. Attached 54-2 and 54-9 signs to metal
post 5 ft. N.W. of Cor. and 54-2 sign to metal post 5 ft. S.E.
of Cor.

Cor. falls on S.W. slope in middle of large clearing.

Compass Declination: 18 1/2° East

I hereby certify the above described corner monument and/or
accessories was established as described on December 10, 1981.

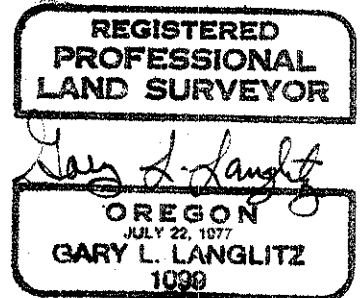

Witnesses: Rodger Orton
Loren Huntsman


Office of..... Surveyor..... County of..... Union.....
 State of..... Oregon....., I hereby certify that the within instrument was filed in this office
 for record on the... 4 ... day of... OCTOBER....., 1982.
 Howard L. Perry by Gary L. Langlitz
 (COUNTY OFFICIAL) (DEPUTY)

CERTIFIED RECORD OF LAND CORNER MONUMENTATION

History of original corner establishment:

Not previously established.

Index File No. BMFW-31

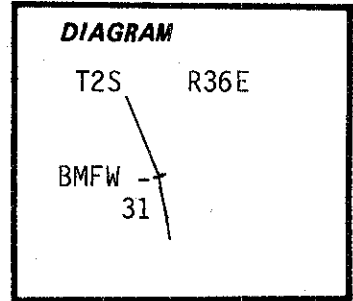

(SEE SURVEY 42-82)

Description of corner evidence found:

None

UNION COUNTY SURVEYOR
Date Received _____
Date Filed _____
By _____
NARRATIVE DRAWER 1/3
File No. _____

REFER TO SURVEY 42-82

Description of monument and accessories I established to perpetuate the original location of this corner:

Boundary of Blue Mtn. Forest Wayside determined by survey.

At surveyed point set 2 1/2"x30" galvanized pipe with brass cap stamped:

Set pipe 20" in ground to rock with mound of stone to cap.
From which:

- A P. Pine 6" dia. bears S16°E, 19.4 ft. scribed BMFW 31 BT
- A Douglas Fir 8" dia. bears N79°W, 12.6 ft. scribed BMFW 31 BT


BMFW 31
PLS 1099
1981

Attached brass washer stamped LS1099 to foot blaze of both BT's. Attached 54-3 and 54-4 signs to both BT's and painted blazes and 6" ring around BT's red. Attached 54-2 and 54-9 signs to metal post 5 ft. S.E. of Cor. and 54-2 sign on metal post 5 ft. N.W. of Cor. Corner falls on steep west slope (rocky) 40 ft. west of top of N-S knoll at south end of knoll.

Compass Declination: 18 1/2° East

I hereby certify the above described corner monument and/or accessories was established as described on December 10, 1981.

Witnesses: Rodger Orton
Loren Huntsman

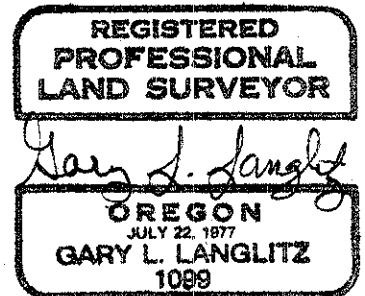


Office of.....Surveyor..... County of.....Union.....
 State of.....Oregon..... I hereby certify that the within instrument was filed in this office
 for record on the...4... day of...OCTOBER....., 1982
Howard L. Perry..... by Gary L. Langlitz.....
 (COUNTY OFFICIAL) (DEPUTY)

CERTIFIED RECORD OF LAND CORNER MONUMENTATION

Index File No. BMFW-32

History of original corner establishment:

Not previously established

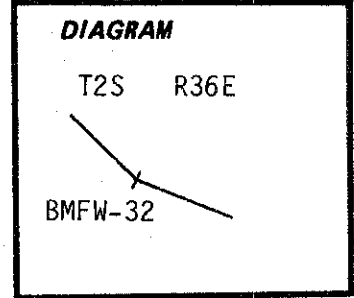

(SEE SURVEY 42-82)

Description of corner evidence found:

None

UNION COUNTY SURVEYOR

Date Received _____

Date Filed _____

By _____

NARRATIVE DRAWER 1/3

File No. _____

REFER TO SURVEY 42-82

Description of monument and accessories established to perpetuate the original location of this corner:

Boundary of Blue Mtn. Forest Wayside determined by survey.

At surveyed point set 2 1/2"x30" galvanized pipe with brass cap attached, stamped:
Set pipe 16" in ground with mound of stone and dirt to cap. From which:

BMFW 32
PLS1099
1981

A Pond. Pine 8" dia. bears N48°W, 34.5 scribed
BMFW 32 BT.

A Douglas Fir 10" dia. bears S70°W, 23.8 ft. scribed
BMFW 32 BT.

Attached brass washer stamped LS1099 to foot blaze of both BT's. Attached 54-3 and 54-4 signs to both BT's and painted blazes and 6" band around both BT's red. Attached 54-2 and 54-9 signs to metal post 5' north of cor. and 54-2 sign on metal post 5' SE of Cor. Corner falls on steep rocky S.W. slope at beginning of draw, course S.W. 75' south of top edge of S.W. slope and approximately 200' south of E-W telephone line.

Compass Declination: 18 1/2° East

I hereby certify the above described corner monument and/or accessories was established as described on December 8, 1981.

Witnesses: Rodger Orton
Gary Langlitz




Office of..... Surveyor..... County of..... Union.....
State of..... Oregon..... I hereby certify that the within instrument was filed in this office
for record on the... 4... day of... OCTOBER... 1982
Howard L. Perry by *Gary L. Langlitz*
(COUNTY OFFICIAL) (DEPUTY)

CERTIFIED RECORD OF LAND CORNER MONUMENTATION

Index File No. BMFW-33

History of original corner establishment:
Not previously established.

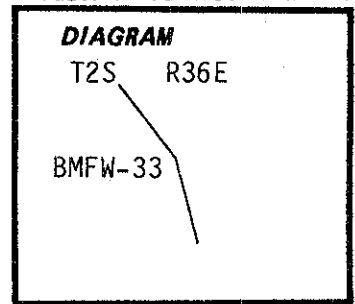

(SEE SURVEY 42-82)

Description of corner evidence found:

None

UNION COUNTY SURVEYOR

Date Received _____

Date Filed _____

By _____

NARRATIVE DRAWER 1/3
File No. _____

REFER TO SURVEY 42-82

Description of monument and accessories established to perpetuate the original location of this corner:

Boundary of Blue Mtn. Forest Wayside determined by survey

At surveyed point set 2 1/2"x30" galvanized pipe with brass cap attached stamped:

BMFW33
PLS 1099
1981

Set pipe 14" in ground with mound of dirt and stone to cap.

From which:

A Pond. Pine 24" dia. bears S65°E, 61.0 Ft. scribed BMFW 33 BT

A Pond. Pine 9" dia. bears N5°E, 43.6 Ft. scribed BMFW 33 BT


Attached brass washer stamped LS1099 to foot blaze of both BT's.

Attached 54-3 and 54-4 signs to both BT's and painted blazes

and 6" band around both BT's red. Attached 54-2 and 54-9 signs on metal post 5 ft. west of cor. and 54-2 sign on metal post 5 ft. east of cor. Cor falls 40 ft. south of top edge of steep rocky S.W. slope 100 ft. south of E-W telephone line.

Compass Declination: 18 1/2° East

I hereby certify the above described corner monument and/or accessories was established as described on December 8, 1981.

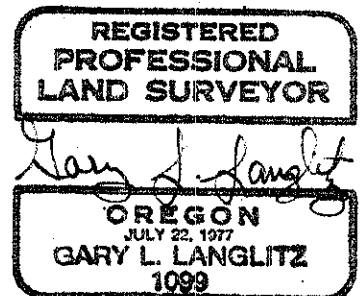

Witnesses: Rodger Orton
Gary Langlitz


Office of.....Surveyor..... County of.....Union.....
State of.....Oregon....., I hereby certify that the within instrument was filed in this office
for record on the...4... day of...OCTOBER....., 1982.
.....Howard L. Perry..... by Gary L. Langlitz
(COUNTY OFFICIAL) (DEPUTY)

CERTIFIED RECORD OF LAND CORNER MONUMENTATION

Index File No. BMFW-34

History of original corner establishment:

Not previously established

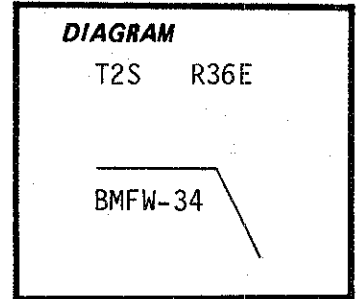

(SEE SURVEY 42-82)

Description of corner evidence found:

None

UNION COUNTY SURVEYOR	
Date Received	_____
Date Filed	_____
By	_____
File No.	NARRATIVE DRAWER 1/3

REFER TO SURVEY 42-82

Description of monument and accessories established to perpetuate the original location of this corner:

Boundary of Blue Mtn. Forest Wayside determined by survey.

At surveyed point set 2 1/2" x 30" galvanized pipe with brass cap attached stamped:


Set pipe 6" in ground to solid rock with mound of stones to cap.

From which:

A Ponderosa Pine 13" dia. bears S51°E, 38.0 ft. scribed BMFW 34 BT

A Douglas Fir 14" dia. bears N73°W, 100.7 ft. scribed BMFW 34 BT

Attached brass washer stamped LS1099 to foot blaze of both BT's. Attached 54-3 and 54-4 signs to both BT's. Painted blazes and 6" band around both BT's red. Attached 54-2 and 54-9 signs to metal post 5' West of corner and 54-2 sign to metal post 5' east of corner. Corner falls on steep rocky S.W. slope 179' east of N 1/4 S20

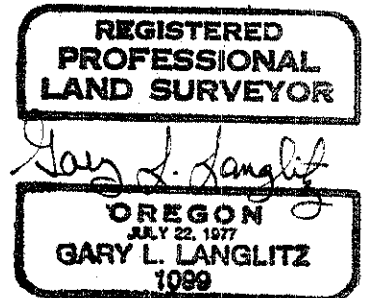

Compass Declination: 18 1/2° East

I hereby certify the above described corner monument and/or accessories was established as described on December 8, 1981.

Witnesses: Rodger Orton
Gary Langlitz

Office of..... Surveyor..... County of..... Union.....
 State of..... Oregon..... I hereby certify that the within instrument was filed in this office
 for record on the... 4... day of... OCTOBER... 1982...
 Howard L. Perry..... by Gary L. Langlitz.....
 (COUNTY OFFICIAL)..... (DEPUTY).....