



NARRATION

THE EXTERIOR LINES TO T.2N. R.39E, W.M. WERE RUN BY RUFFS S. MOORE IN 1881, THE CLOSING CORNER TO S.1, T.2N., R.38E. AND S.36, T.3N., R.38E, WAS SET BY JOHN W. KIMBRELL IN 1903, THE CLOSING CORNER WAS REMONUMENTED BY P.E. 6164 IN 1976, BUT I COULD FIND NO INFORMATION ON THIS IN THE COUNTY SURVEY FILES. THE TOWNSHIP CORNER TO TOWNSHIPS 213 NORTH, RANGES 38 & 39 EAST, WAS REMONUMENTED BY WAYNE O. HARRIS IN 1978, THE CORNER TO SECTIONS 1 & 12, T.2N., R.38E., AND SECTIONS 6 & 7, T.2N., R.39E., WAS REMONUMENTED BY WAYNE O. HARRIS IN 1978. I SET THE 1/4 CORNER OF SECTIONS 1 & 6, T.2N., RANGES 38 & 39 EAST BY PROPORTIONATE MEASURE AFTER A THOROUGH SEARCH AND FINDING NO EVIDENCE REMAINING OF THE ORIGINAL CORNER. A RANDOM TRAVERSE WAS RUN CONNECTING THE CORNERS 1/2 MILE NORTH AND SOUTH OF THE 1/4 CORNER, CLOSED AND BALANCED, AND THE CORNER WAS THEN SET. THE PURPOSE OF THIS SURVEY WAS TO ESTABLISH THE BOUNDARY BETWEEN THE NATIONAL FOREST AND PRIVATE LAND.

SURVEY FOR U.S. FOREST SERVICE
UMATILLA NATIONAL FOREST
CONTRACT № 53-04R3-2-01243
SEC. 6, T.2 N., R.39E., W.M..
UNION COUNTY, OREGON
SCALE 1"=500' MAY- SEP, 1982
SURVEYOR: CLAYTON J. MARTIN RPLS 1910
CHAINMEN: J. MARTIN, B. WILSON, R. GERIG
MONUMENT FOUND •
MONUMENT SET •

REGISTERED
PROFESSIONAL
LAND SURVEYOR
Clayton J. Martin
OREGON
CLAYTON J. MARTIN
1910

C.J. MARTIN SURVEYING
2751 JUNIPER ST.
SWEET HOME, OR 97386

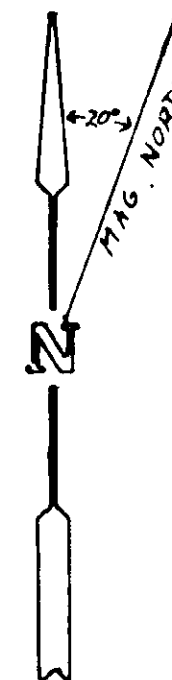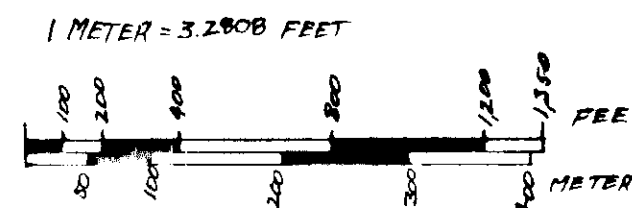

- ① SEC. COR. 36 ⁵³¹/₁₅₆ FOUND A 2 1/2" DIAM. BRASS CAP SET 4" ABOVE GROUND IN A STONE MOUND AND STAMPED PER SKETCH, 10" D.B.H. WHITE FIR, N.47°W, 12.7', (11.1') WITH A HEALED FACE, BT. TAG. 18" D.B.H. WHITE FIR N.38°E., 16.5', WITH SCRIBES BT VISIBLE, B.T. TAG. 10" D.B.H. WHITE FIR S.38°E., (15.2') 16.5', WITH SCRIBES S6, BT TAG, DEAD & DOWN. STEEL FENCE POSTS 4' SOUTH AND 4' EAST. 10" D.B.H. WHITE FIR S.59°E., 51.9' SCRIBED T2N R39E S6 BT (NEW BT) BRASS WASHER BETWEEN B&T RPLS 1910.
- ② CLOSING CORNER ⁵³¹/₁₅₆ R39E FD. A 2 1/2" BRASS CAP SET IN A 2" IRON PIPE IN A ROCK MOUND AND STAMPED PER SKETCH. A 16" D.B.H. WHITE FIR S.38°W, 40.2', SCRIBED T2N R38°E S1 BT, BRASS WASHER PE 6164. A B.T. STOB, S.32°W, 26.3', SCRIBES R38°E, ORIG. BT. (S.27°W, 26.4'), A 20" D.B.H. WHITE FIR, N.51°E., (S.51°E)(33.4') 39.0' SCRIBED T2N R39E S6 BT, CORRODED BRASS WASHER. STEEL FENCE POST, 4' S & E. 8" D.B.H. WHITE FIR, N.60°W, 73.2', SCRIBED T3N R38E S36 BT, RPLS 1910 BRASS WASHER BTWN. B&T (NEW BT)
- ③ 1/4 COR. S1, S6, T.2N. SET A 2 1/2" DIAM. BRASS CAP IN A 2" x 30" IRON PIPE STAMPED PER SKETCH. FROM THE CAP BEARS AN 8" D.B.H. DOUGLAS FIR N.07°E., 34.0', SCRIBED 1/4 S6 BT. A 10" D.B.H. WHITE FIR, S.49°W, 16.8', SCRIBED 1/4 S1 B.T. A RAVINE, NORTH, 23', BEARS S.45°E. BRASS WASHER RPLS 1910 BETWEEN B&T ON BOTH TREES. STEEL FENCE POST 4' S & E.
- ④ COR. SEC'S, 1 & 12, T.2N., R.38E., AND SEC'S, 6 & 7, T.2N., R.39E. A 2 1/2" DIAM. BRASS CAP SET 6" ABOVE GROUND IN A 2" DIAM. IRON PIPE AND STAMPED PER SKETCH. FENCE POST (STEEL) WITH ATTENTION SIGNS 1.4' SOUTH. 10" D.B.H. BT. WHITE FIR, N.40°E., (59.7') 59.3', SCRIBED T.2N R.39E S6 BT ORIGINAL B.T., A WHITE FIR STOB, N.60°E., 51 LKS., SCRIBES VISIBLE, BT. TAG. ORIG. B.T., A DOWN STOB. S.35°E., (S.44°E.) 19.9' (26 LKS), BT. SCRIBES VISIBLE, B.T. TAG. 10" D.B.H. WHITE FIR S.11°E., 23.0', (S.09°E., 23.4') SCRIBES T.2N R.39E S7 BT. VISIBLE, BT TAG, ORIG. BT, WHITE FIR S.11°E., S.33°W., (S.38°W., 16.5') 18.4' WITH SCRIBES S12 VISIBLE (12" D.B.H.) 28" D.B.H., 8" D.B.H. WHITE FIR, S.72°W., 26.2', SCRIBED T2N R38E S12 BT, BRASS WASHER RLS 346, B.T. TAG, 14" D.B.H. WHITE FIR (10" D.B.H.) N.78°W., (N.73°W.), 21.6' (20.12') WITH SCRIBES VISIBLE, B.T. TAG. FENCE IS 1.4' EAST, ROAD IS 65' WEST, LOCATION POSTER ON ROAD (TAG).

NOTE ALL B.T.S. HAVE BT. TAGS, ATTENTION SIGNS AND HAVE RED PAINTED BANDS.
BEARINGS BASED ON SOLAR OBSERVATIONS
G.L.D. DISTANCES AND BEARINGS ARE IN BRACKETS ()

FR = FOUND ALUM. = ALUMINIUM. G.L.D. = GENERAL LAND OFFICE B.L.M. = BUREAU OF LAND MANAGEMENT MAG. = MAGNETIC

I, CLAYTON J. MARTIN, A REGISTERED LAND SURVEYOR IN THE STATE OF OREGON, HEREBY CERTIFY THAT THIS PLAT IS A CORRECT REPRESENTATION OF A SURVEY I PERFORMED DURING MAY, JUNE, JULY, AUGUST AND SEPTEMBER FOR THE U.S. FOREST SERVICE IN ACCORDANCE WITH THE STATUTES OF OREGON AND THE B.L.M. MANUAL OF SURVEYING INSTRUCTIONS, 1973. *Clayton J. Martin* RPLS #1910

||||| BOUNDARY, POSTED WITH STEEL FENCE POSTS AND U.S.F.S. BOUNDARY SIGNS.
ALL DISTANCES TO BEARING TREES ARE TO CENTER OF TREE 1 FOOT ABOVE ROOT CROWN.

UNION COUNTY
SURVEYOR
Date Received 10-7-82
Date Filed 10-29-82
By G. LANGRISH DEPUTY
File No. 47-82

