
PORTLANT PRECISION INSTRUMENT.

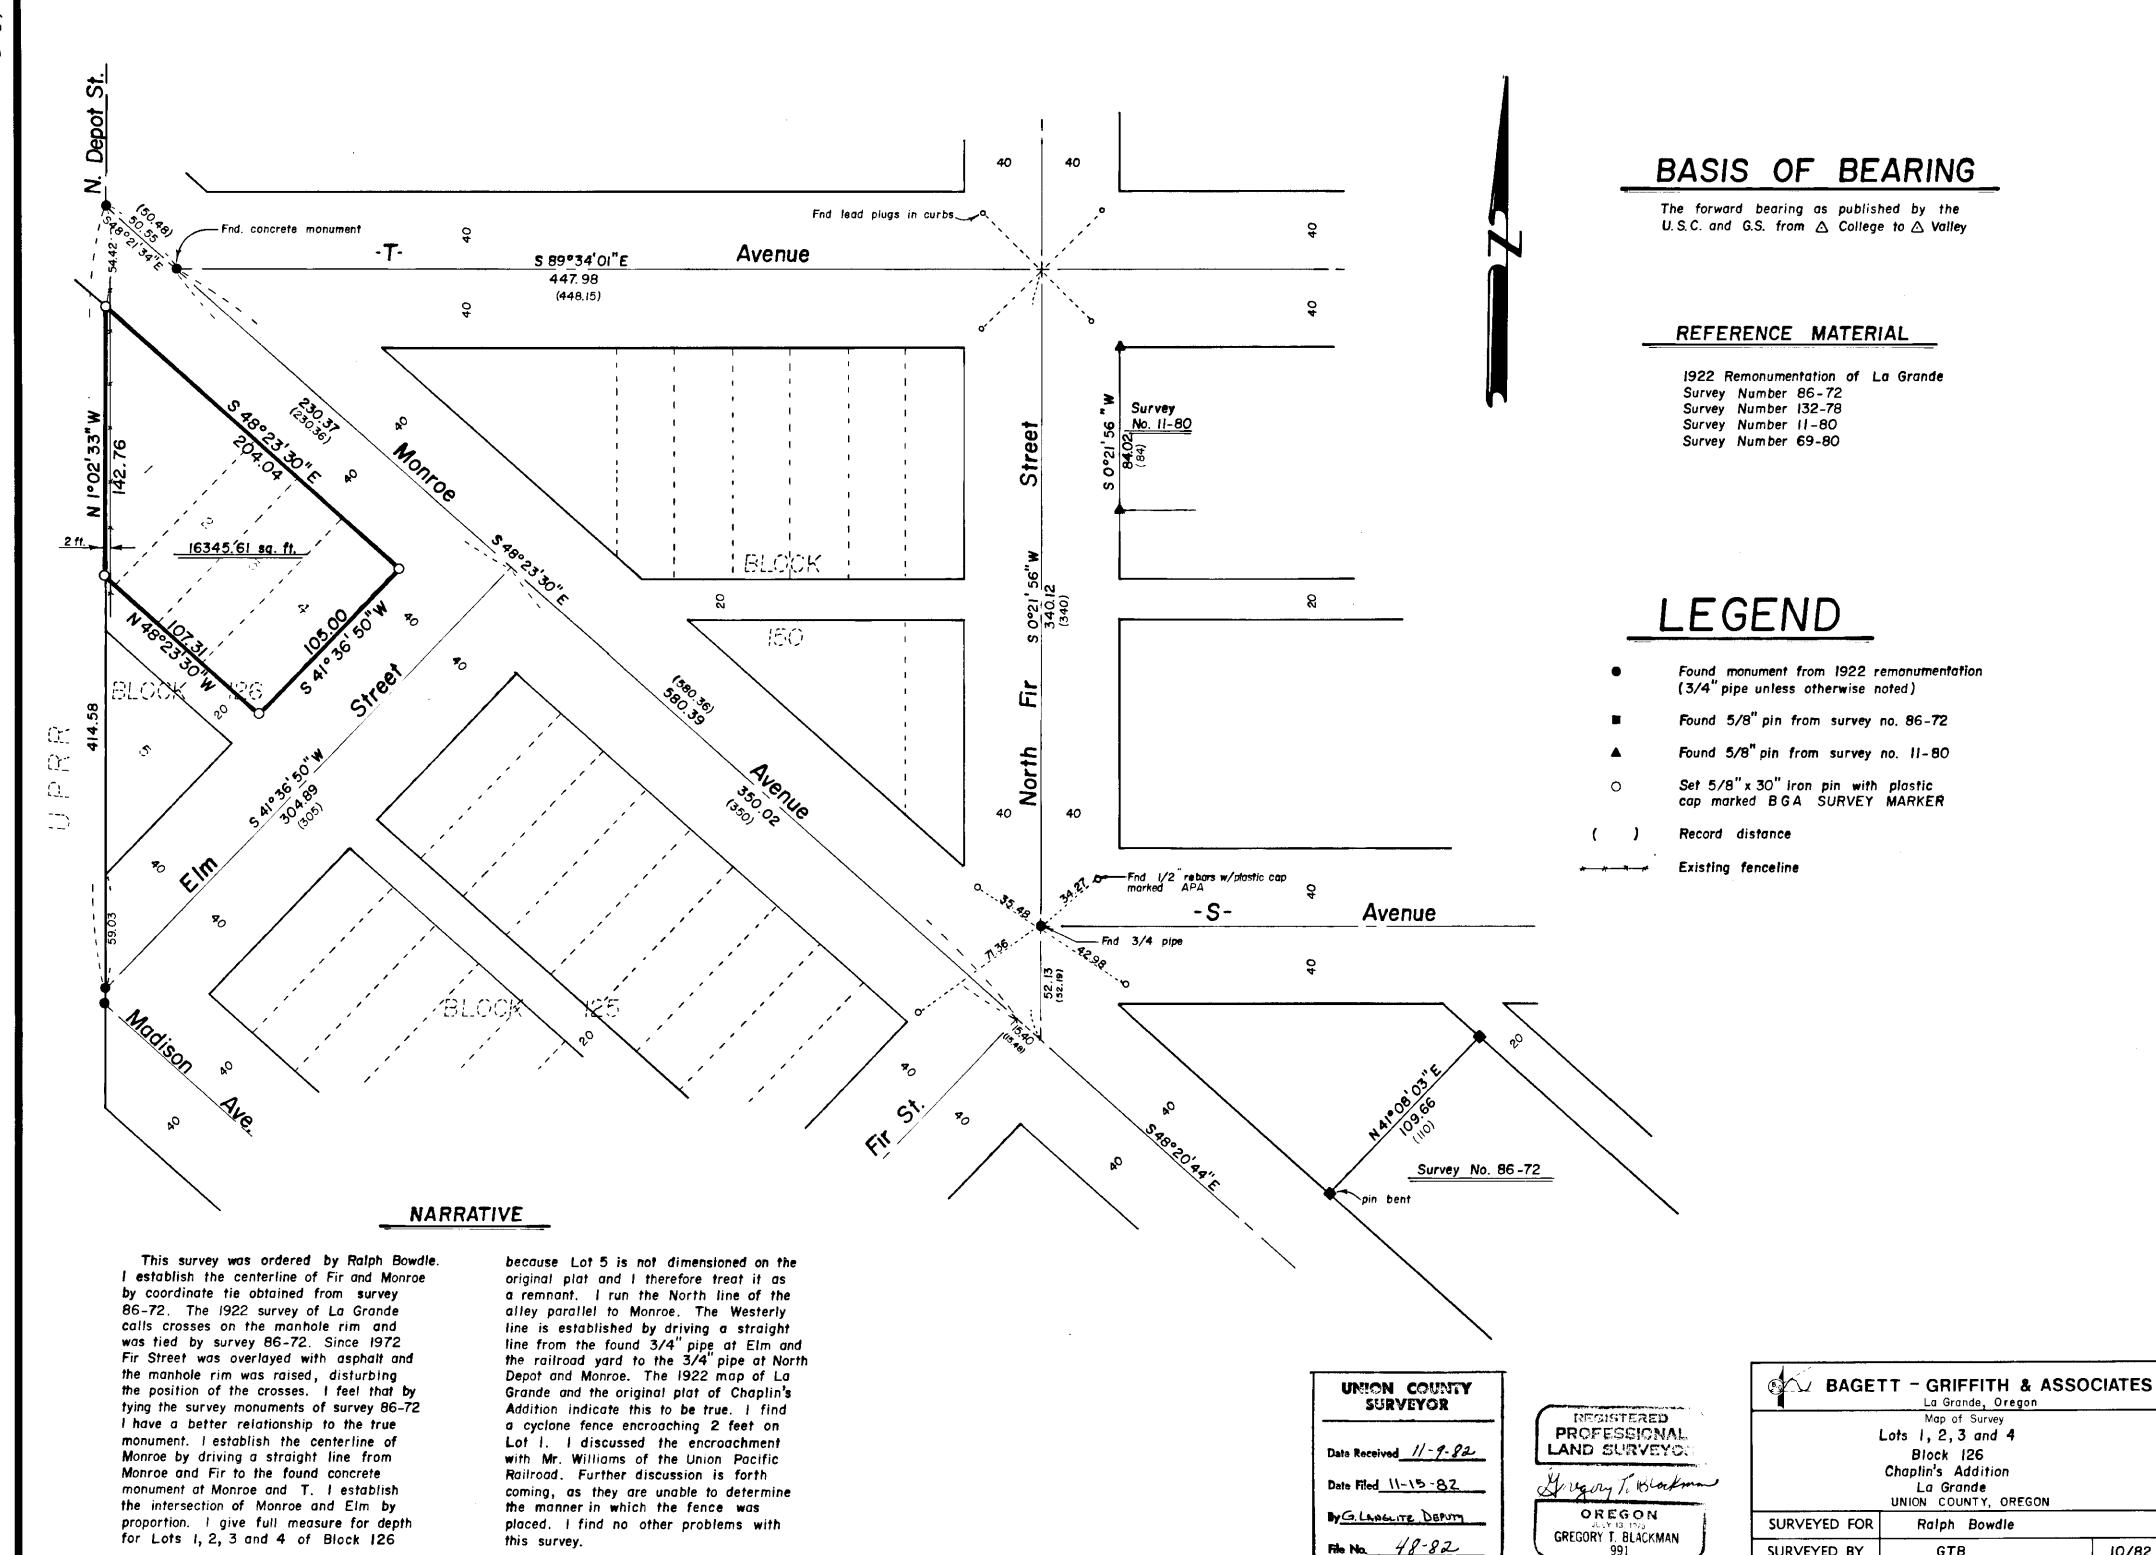

10/82

10/82

SURVEYED BY

Scale: 1"= 50'

GTB

Drawn by: RGR