
11/82

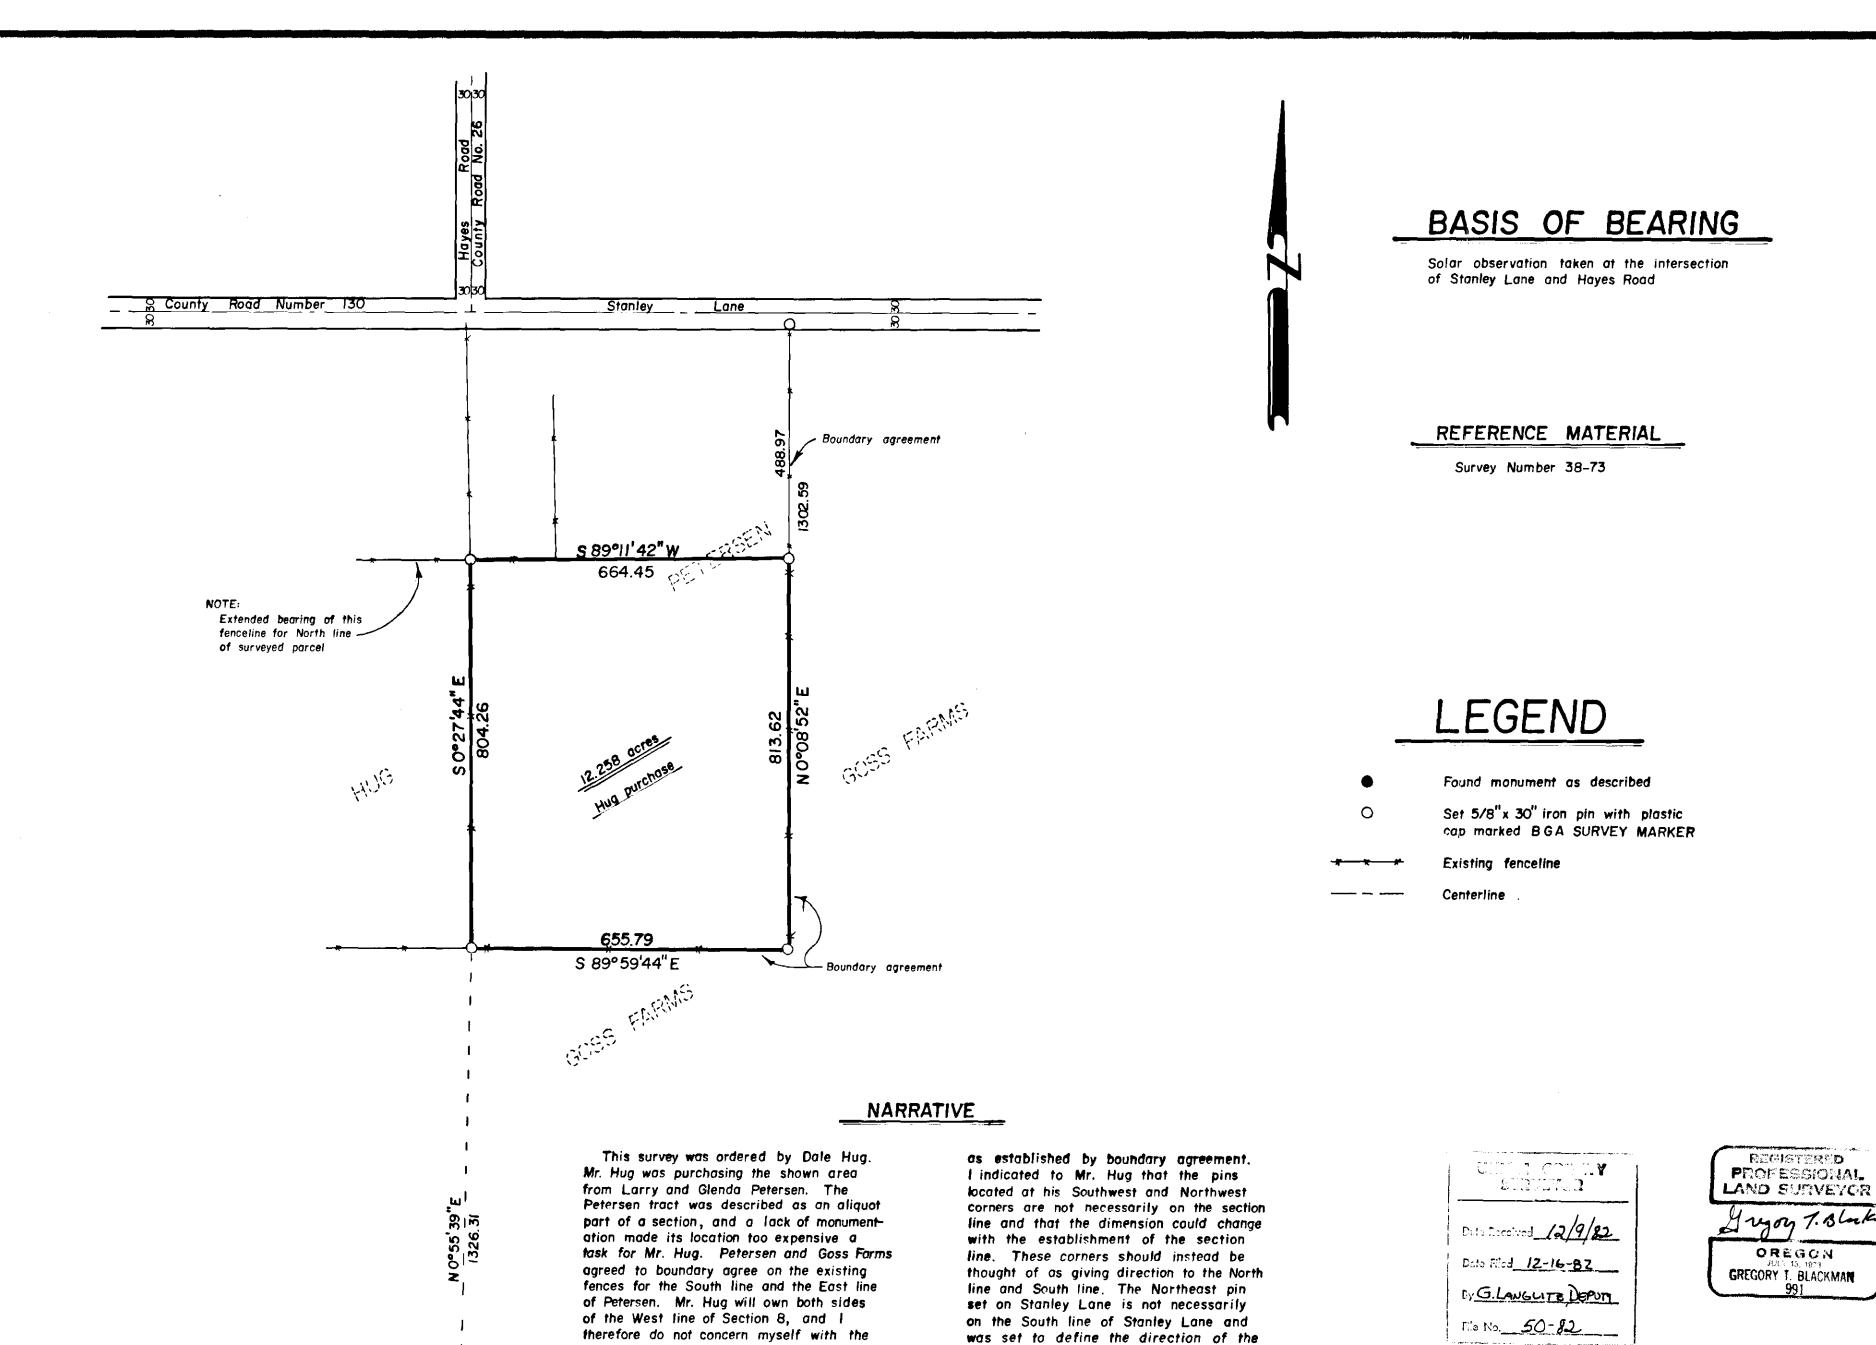

line between Petersen and Goss Farms.

The purpose of the drawing is to

the North line of the land to be

purchased by Mr. Hug.

define the boundary agreement and

true location of the section line. The North

line of the tract Hug is to purchase was

established by his direction, by extending

intersection of the East line of Petersen

an existing fenceline Easterly to the

BAGETT - GRIFFITH & ASSOCIATES

La Grande, Oregon

Map of Survey

Parcel in the Southwest quarter of
Section 8, Township 2 South, Range
39 East of the Willamette Meridian

Alicel
UNION COUNTY, OREGON

SURVEYED FOR Dale Hug

SURVEYED BY GTB 11/82

Drawn by: RGR

Scale: 1"= 200'

PORTLAND PRECISION INSTRUMENT

Found brass cap 18" in ground with

18 | 17

marked stone alongside

(set by County Surveyor)