


SECTIONS 10 & 11

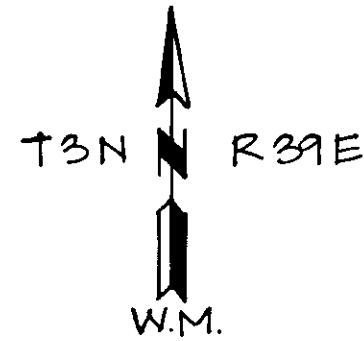

LEGEND

- FOUND RECORD BRASS OR ALUMINUM MONUMENT.
- SET ALUMINUM PIPE AND CAP FROM ORIGINAL G.L.O. EVIDENCE
- ⊕ SET ALUMINUM PIPE AND CAP MONUMENT FROM SURVEY
- MARKED LINE OFFSET METHOD
- () ORIGINAL RECORD BEARING AND DISTANCE

BASIS OF BEARING

THE SECTION LINE BETWEEN THE SOUTHEAST SEC. COR. AND THE EAST 1/4 COR. OF SECTION 10, IS N0°32'16"E. RECORD BEARING OF SURVEYS 4-81 AND 17-83.

MEAN MAGNETIC DECLINATION

N19°30"E

REFERENCE MATERIAL

ORIGINAL G.L.O. NOTES AND PLATS. SURVEYS 4-81, 37-82 AND 17-83. FIELD BOOKS NUMBER 1 AND 2.

NARRATIVE

SURVEY WAS PERFORMED FOR BOISE CASCADE CORPORATION, DURING OCTOBER, 1984. THE SURVEY WAS PERFORMED TO SUB-DIVIDE THE SECTIONS AND SET 1/16 CORNERS FOR PROPERTY LOCATION. THE SOUTH 1/4 CORNER AND THE SOUTHEAST SECTION CORNER OF SECTION 11, WERE SET FROM ORIGINAL G.L.O. EVIDENCE. NO TRACE OF THE EAST 1/4 CORNER OF SECTION 11 COULD BE FOUND AND THIS CORNER WAS SET BY SINGLE PROPORTIONATE MEASUREMENT. THE LINE BETWEEN THE NORTH AND SOUTH HALVES, ON THE NORTHEAST 1/4 OF SECTION 10 WAS BLAZED AND PAINTED USING THE OFFSET METHOD. A MAC II-H EDM AND A WILD T-2 WERE USED FOR THE SURVEYS.

SURVEY HISTORY

THE INTERIOR OF T3N, R39E, W.M., WAS ORIGINALLY SURVEYED BY FRANK W. CAMPBELL, DURING MAY, 1884, UNDER G.L.O. CONTRACT NUMBER 498. SOME OF THE EXTERIOR LINES OF SECTIONS 10 AND 11, WERE SURVEYED BY P.L.S. 644, IN 1980 AND FILED AS SURVEY NUMBER 4-81. SECTION 3 WAS SURVEYED BY P.L.S. 933, IN 1982 AND FILED AS SURVEY NUMBER 37-82. THE EXTERIORS OF SECTION 10 AND PART OF THE INTERIORS WERE SURVEYED BY P.L.S. 991, IN 1983 AND FILED AS SURVEY NUMBER 17-83. THE CORNER TO SECTIONS 2, 3, 9 & 10 WAS MOVED AFTER THE SURVEY AND THE BEARINGS AND DISTANCES ARE TO THIS POSITION. THE CORNER TO SECTIONS 1, 2, 11 & 12 WAS INCORRECTLY MARKED IN 1980, BUT CHANGED IN 1981, BY ME. MONUMENTATION FORMS FOR THE STANDARD INDEX FILE NUMBERS F-15, F-18, F-19, G-21, J-19 & J-21 FILED WITH THE UNION COUNTY SURVEYOR.

RECORD BEARING & DISTANCES FROM RECORD SURVEYS

- ① S89°56'11"E, 2562.94' (4-81) SURVEY NUMBER
- ② N89°59'47"E, 1314.055' (4-81)
- ③ N89°59'47"E, 1314.055' (4-81)
- ④ N0°32'16"E, 1306.40' (4-81) (17-83)
- ⑤ N0°32'16"E, 1306.40' (4-81) (17-83)
- ⑥ N0°32'16"E, 2612.80' (4-81) (17-83)
- ⑦ S89°29'52"E, 2640.73' (4-81) AND N89°29'52"W, 2640.73' (37-82) (17-83)
- ⑧ N1°06'41"E, 2615.63' (17-83)
- ⑨ N1°06'41"E, 2608.31' (17-83)
- ⑩ N89°33'20"W, 2676.91' (17-83)
- ⑪ N89°33'20"W, 2666.92' (17-83)
- ⑫ S89°27'33"E, 2693.03' (17-83)
- ⑬ S89°45'00"E, 5268.78' (4-81)

I, Barry B. Barbour, a registered land surveyor in the State of Oregon, hereby certify that this plat and the notes hereon, or attached, are a correct representation of a survey I performed during October 1984 for BOISE CASCADE CORPORATION, in accordance with the Statutes of the State of Oregon.

Barry B. Barbour Barry B. Barbour
Registered Land Surveyor
Oregon License 1051

REGISTERED PROFESSIONAL LAND SURVEYOR

Barry B. Barbour
O.R.L.S. # 1051
OCT. 17, 1975
BARRY B. BARBOUR
1051

UNION COUNTY SURVEYOR

Date Received 12-14-84
Date Filed 12-21-84
By G. LANGTIZ, DEPUTY
File No. 53-84

SECTIONS 10 & 11, T3N, R39E, W.M. UNION COUNTY, OREGON		
FOR: BOISE CASCADE CORPORATION		
SCALE 1" = 1000'	Barry B. Barbour Professional Land Surveyor	SHEET NO 1 of 1
DATE NOV, 1984	P.O. Box 4811 Boise, Idaho 83704	