
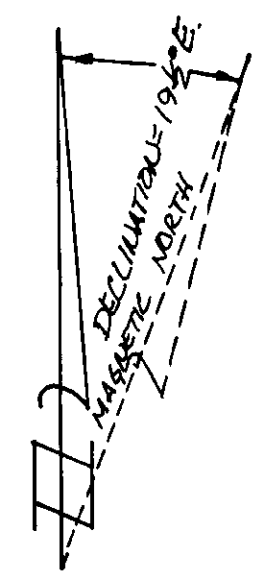


PLAT OF SURVEY OF THE NORTH LINE OF SECTION 19 TOGETHER WITH SECTIONS 20 AND 29, TOWNSHIP 5 SOUTH, RANGE 35 EAST, WILLAMETTE MERIDIAN, UNION COUNTY, OREGON. SURVEY FOR THE UNITED STATES FOREST SERVICE, WALLOWA-WHITMAN NATIONAL FOREST, LA GRANDE RANGER DISTRICT. SURVEY PERFORMED UNDER CONTRACT NO. 53-04M3-4-3009 BY: SUTTON SURVEYING, P.O. BOX 237, ELGIN, OR. 97821

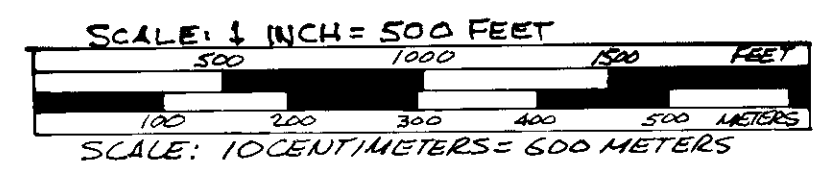

- LEGEND**
- ⊙ ~ CORNER SET BY SINGLE PROPORTIONING
 - ⊙ ~ CORNER SET FROM ORIGINAL EVIDENCE
 - ⊙ ~ CORNER SET BY INTERSECTION
 - ~ CORNER MONUMENT FOUND (ALL BY L.S.#381-1969)
 - ~ 1 1/2" X 30" ALUMINUM CAPPED ALUMINUM PIPE SET
 - CH ~ DISTANCE IN CHAINS FROM ORIGINAL SURVEY
 - FT ~ DISTANCE IN FEET
 - M ~ DISTANCE IN METERS
 - N ~ NORTH
 - S ~ SOUTH
 - E ~ EAST
 - W ~ WEST

TTT ~ USFS BOUNDARY POSTED WITH #133 STEEL FENCE POSTS
 GLO ~ GENERAL LAND OFFICE
 ACAP ~ ALUMINUM CAPPED ALUMINUM PIPE
 T ~ TOWNSHIP
 R ~ RANGE
 FND ~ FOUND
 BC ~ BRASS CAP
 I.P. ~ IRON PIPE
 BCIP ~ BRASS CAPPED IRON PIPE
 BLM ~ BUREAU OF LAND MANAGEMENT
 PVT. ~ PRIVATE OWNERSHIP
 USFS ~ UNITED STATES FOREST SERVICE ADMINISTERED PUBLIC LANDS

I, D. E. SCOTT, OREGON REGISTERED SURVEYOR NO. 1844, DO HEREBY CERTIFY THAT THIS PLAT IS A TRUE REPRESENTATION OF THE SURVEY I MADE OF SECTIONS 29 AND 30 AT THE REQUEST OF THE UNITED STATES FOREST SERVICE UNDER CONTRACT NO. 53-04M3-4-3009 DURING THE MONTHS OF OCTOBER AND NOVEMBER OF 1984.

REGISTERED PROFESSIONAL LAND SURVEYOR
David E. Scott
 OREGON
 DAVID E. SCOTT
 1844

NARRATIVE:

LOCATION:
 SOUTHWEST OF STARKEY, OREGON ON USFS ROAD NO. 51 ABOUT 13 MILES, THE NORTH BOUNDARY OF THE TONY VEY RANCH.

PROCEDURES:

RESEARCH CONSISTED OF INFORMATION FROM ORIGINAL G.L.O. SURVEY RECORDS AND COPIES OF CORNER CARDS AND CERTIFICATES ON FILE WITH THE LA GRANDE RANGER DISTRICT AND THE UNION COUNTY SURVEYORS OFFICE. D. E. SCOTT, L.S. 1844, WITH THE ASSISTANCE OF JEFF SHEETS PERFORMED THE FIELD WORK WITH A TOP CON GTS-10D. TRAVERSE CLOSURES MET OR EXCEEDED U.S.F.S. CONTRACT REQUIREMENTS. CORNERS SHOWN AS FOUND OR SET FROM ORIGINAL EVIDENCE WERE USED AS CONTROL FOR ESTABLISHING THE EXTERIOR BOUNDARIES OF SECTIONS 20 AND 29 AND THE NORTH LINE OF SECTION 19 FOR POSTING THE USFS. PROPERTY BOUNDARY, ALSO FOR SUBDIVIDING SECTIONS 20 AND 29. NO. 133 STEEL FENCE POSTS WERE USED TO POST THE USFS PROPERTY BOUNDARY AT 200-400 FT. INTERVALS. CORNER CARDS FOR CORNERS INDICATED AS SET ON THE ADJOINING MAP ARE ON FILE WITH THE OFFICE OF THE LA GRANDE RANGER DISTRICT OF THE USFS. CERTIFICATES FOR THOSE CORNERS ARE ON FILE WITH THE UNION COUNTY SURVEYORS OFFICE. A DETAILED DESCRIPTION OF THE CORNER MONUMENT AND ACCESSORIES FOR EACH CORNER FOUND OR SET IS FOUND ON THOSE CERTIFICATES (USFS FORM NO. RC-1100-S7 9/71). CORNERS SHOWN AS ⊙ ON THE ADJOINING MAP WERE SET BY SINGLE PROPORTIONATE MEASUREMENT SINCE NO ORIGINAL EVIDENCE WAS RECOVERED FROM THE ORIGINAL G.L.O. SURVEY. CORNERS SHOWN AS ⊙ ON THE ADJOINING MAP WERE SET FROM ORIGINAL EVIDENCE. BEARINGS FOR THIS SURVEY ARE BASED ON A SOLAR OBSERVATION TAKEN 300 FEET EAST OF THE SECTION CORNER COMMON TO SECTIONS 17, 18, 19 AND 20. THE SUBDIVISION OF T.S.S., R.35E WAS BY RUFUS S. MOORE UNDER CONTRACT NO. 451 DATED AUGUST 1882.

LAND OWNERSHIP BY ALIQUOT PARTS:

- SECTION 19-- PRIVATE
- SECTION 20-- NW 1/4, SW 1/4 of NE 1/4, NW 1/4 of SW 1/4 - PRIVATE.
NE 1/4 EXCEPT THE SW 1/4 of NE 1/4, SW 1/4 EXCEPT THE NW 1/4 OF THE SW 1/4, SE 1/4 - USA (ADMINISTERED BY THE U.S.F.S.)
- SECTION 29 -- SOUTH HALF - PRIVATE
NORTH HALF - USA (ADMINISTERED BY THE USFS)
- SECTION 30-- PRIVATE

UNION COUNTY SURVEYOR
 Date Received 1-23-85
 Date Filed 2-5-85
 By G. LANGRISH, DEPUTY
 File No. 2-85