


NARRATIVE:
 The purpose of this survey is to stake the corners and set fence posts on points between on the following described parcels:
 #1 The SW 1/4 of the SE 1/4 of the NE 1/4 and the SE 1/4 of the SW 1/4 of the NE 1/4 of Sec. 36, T4N, R38E, W.M.
 #2 The NE 1/4 of the SW 1/4 of the NE 1/4 and the NW 1/4 of the SE 1/4 of the NE 1/4 of said Sec. 36.
 #3 The SE 1/4 of the SE 1/4 of the NE 1/4 of said Sec. 36.
 The bearings & the survey are based on Dave Krumbein's survey for the U.S.F.S. in 1979 in which he subdivided the section

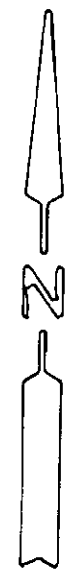

- SCALE: 1" = 400'
- 2" Iron Pipe Fnd (with B.C.) set by Krumbein in 1979 sur for U.S.F.S.
 - 5/8" x 30" Iron Rod Set with Alum. Tag # 951 & steel fence post
- (000) of record 1979 Krumbein Survey

DATE Parcels #1 & #3 surveyed 8/16/85
 Parcel #2 surveyed & Map revised 8/22/85
 ON 12/17/85 This map (duplicate information) was drawn to conform to County Surveyor Map. size standards.

REGISTERED
 PROFESSIONAL
 LAND SURVEYOR

G. Dennis Edwards

OREGON
 JULY 18, 1971
 G. DENNIS EDWARDS
 951

**UNION COUNTY
 SURVEYOR**

Date Received 12-18-85
 Date Filed 12-23-85
 By GLANGLITZ, DEPUTY
 File No. 33-85

SURVEY FOR BOB MAWHIN, STAN SMITH, & WAYNE TRUMBULL
 IN The NE 1/4 Sec. 36, T4N, R38E, W.M. UNION Co., OREGON
 Job # 50508046

EDWARDS SURVEYING
 567-3336
 P.O. Box 763
 HERMISTON, OREGON