


Record of Survey

Made by R.R. Neal County Surveyor Nov. 12 to 24 1917

Scale 1" to 1000 ft.

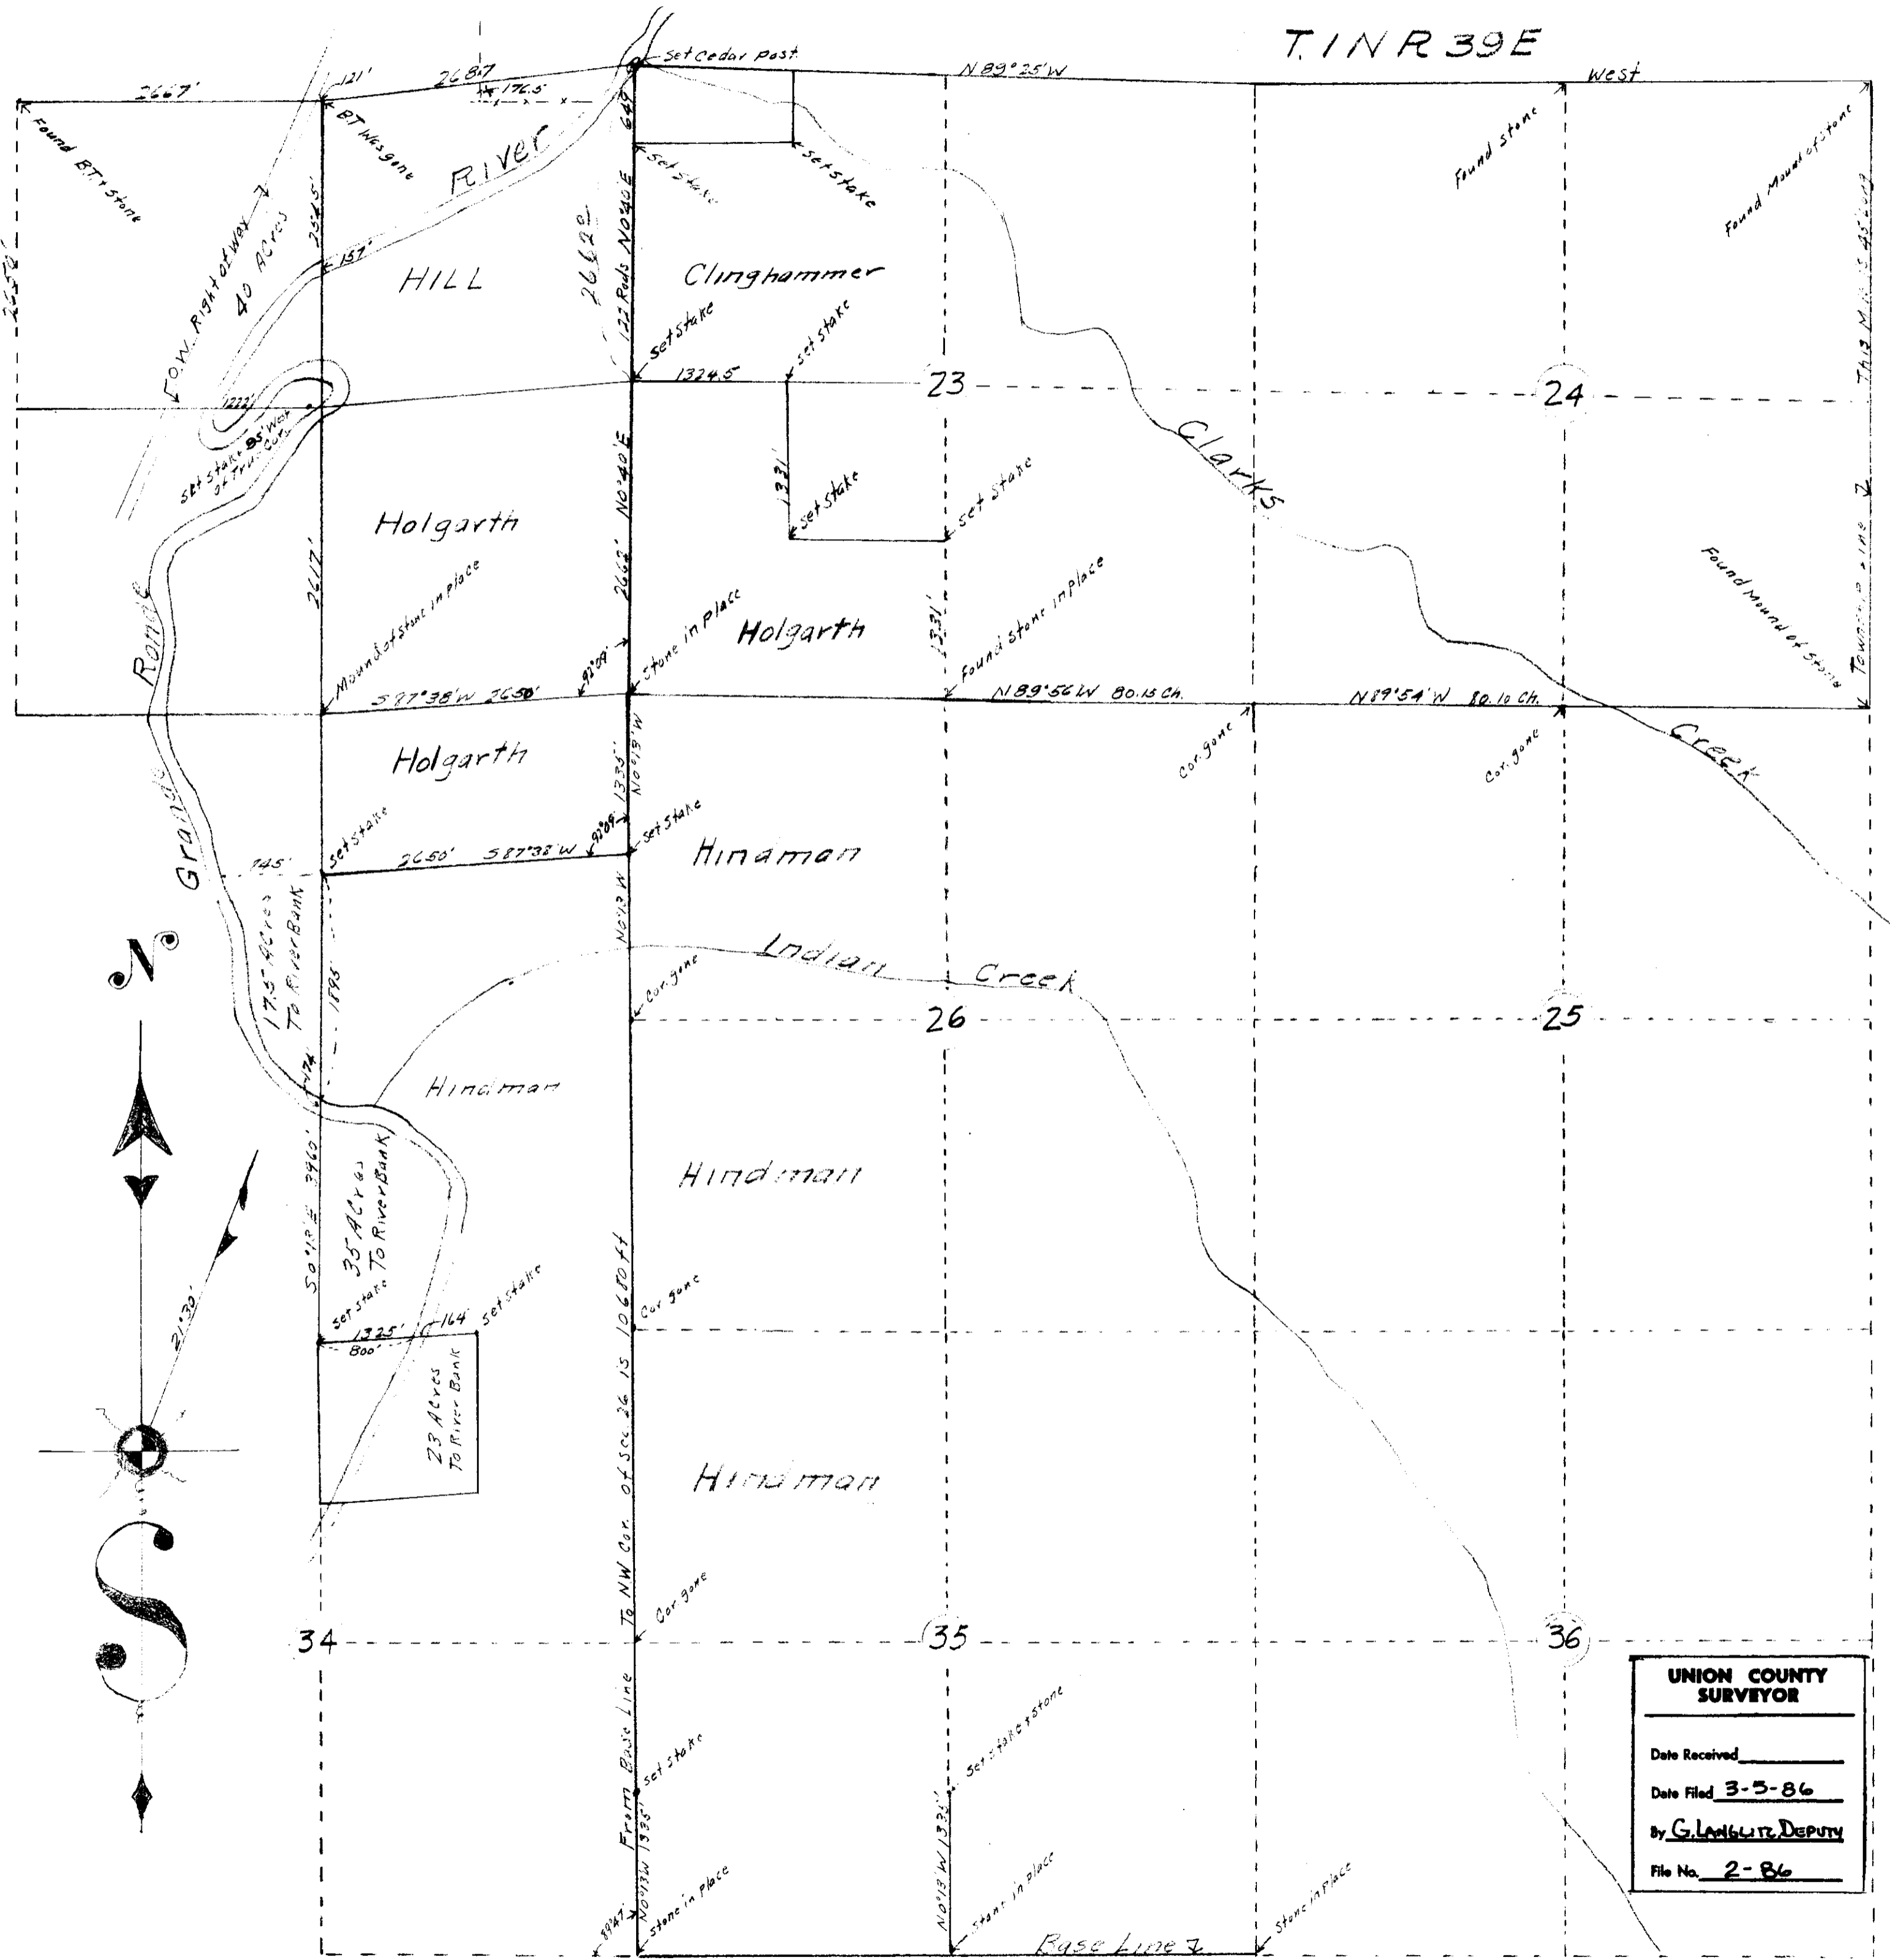

UNION COUNTY SURVEYOR

Date Received _____

Date Filed 3-5-86

By G. LANGRIZ, DEPUTY

File No. 2-86