
PORTLAND PRECISION INSTRUMENT

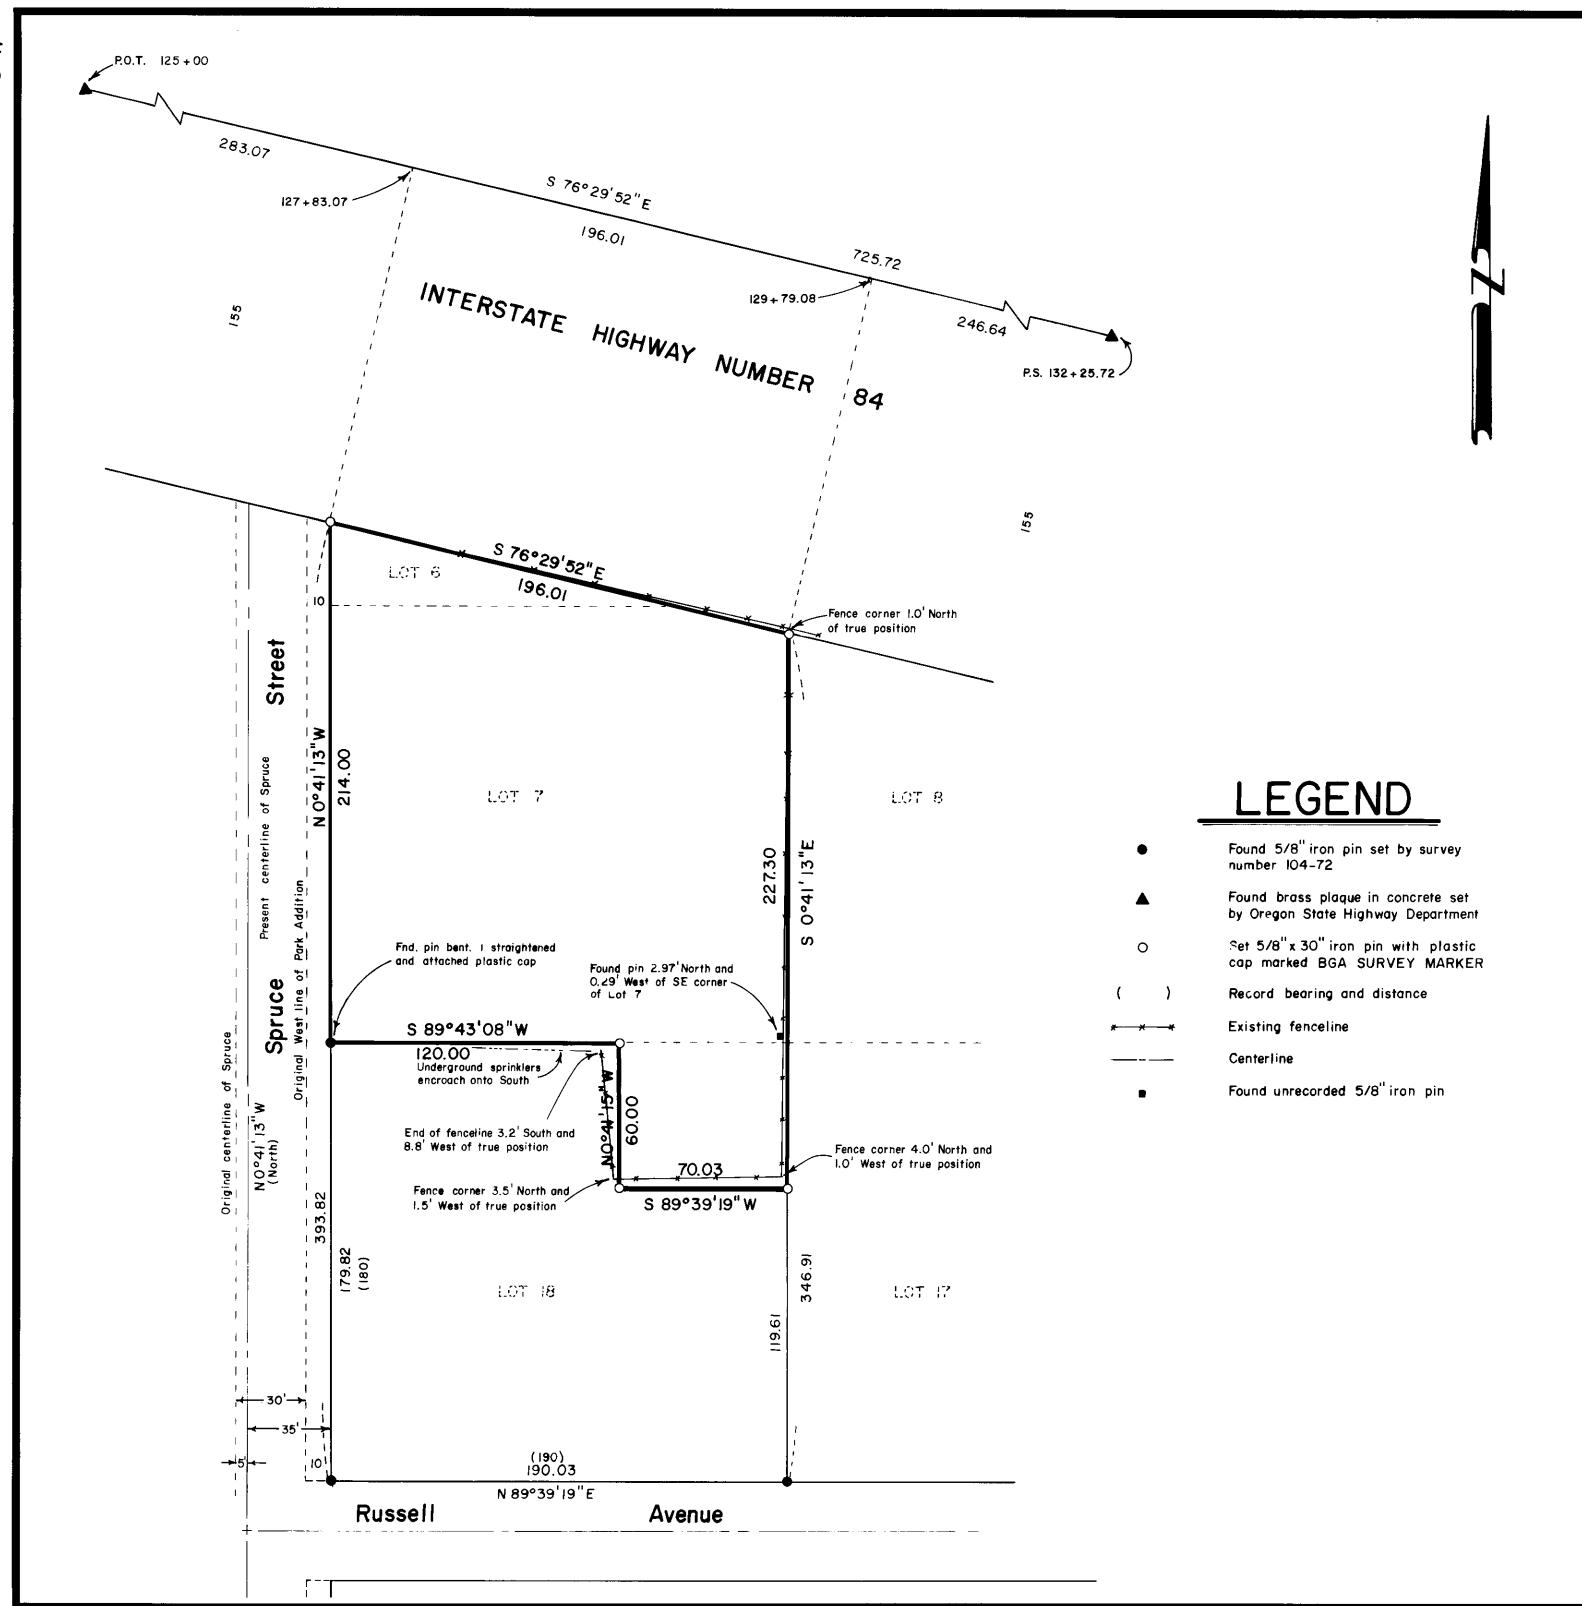

BASIS OF BEARING

The forward bearing as published by the U.S.C. and G.S. from College to Valley, dated 1946

REFERENCE MATERIAL

Survey Number 104-72 O.S.H.D. map number 8B-36-3


NARRATIVE

This survey was ordered by George Butler. I establish the South line of this property by retracement of survey number 104-72 which established the South line of the Butler property. I establish the North line by tying the O.S.H.D. monuments at E.B. station 125+00 (P.O.T.) and E.B. station 132+25.72 (P.S.). I then intersect the South line of the O.S.H.D. right of way and the projected West line of survey number 104-72. The East line was done in the same manner. I find no other problems with this survey.

PROFESSIONAL LAND SURVEYOR

Avgry T. Blockman

OREGON AULY 13, 1973 GREGORY T, BLACKMAN 991 4-25-86 4-30-86 G.LANGLITZ DEPUTY

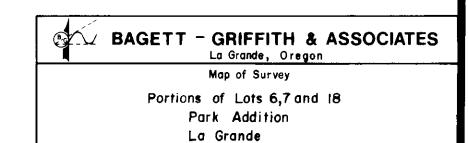

UNION COUNTY, OREGON		
SURVEYED FOR	George Butler	
SURVEYED BY	G. T. B,	4/86
 Scale: 1"= 40'	Drawn by: R.G.R.	4/86