

BASIS OF BEARING

The range line between the S.E. corner & the N.E. corner of sect. 24 as recorded on map of survey no. 57-79, being N 0° 22' 03\" W.

Scale: 1" = 500'



1 Meter = 3.2808333 Feet

HISTORY OF SURVEY

The original survey was made by Rufus S. Moore under contract no. 451, dated June 12, 1882.

There was remonumentation only in 1970 by Voelz.

There was remonumentation only in 1975 by the B.L.M.

In 1979, I subdivided section 24, T 3 S, R 33 E, recorded on survey 57-79.

NATIONAL FOREST LANDS

Section 23

South 1/2
N E 1/4
N W 1/4 of the N W 1/4

Section 22

South 1/2

SURVEYORS STATEMENT

I, Duane I. Griffith, Registered Land Surveyor in the State of Oregon, hereby certify that this plat and the notes hereon, or attached, are a true and correct representation of the survey I made in April, 1986, at the request of the USDA, Forest Service, in accordance with the statutes of the State of Oregon, and with the articles of my contract.


This survey was accomplished by a closed traverse. The entire area has been extensively logged, which has destroyed several G.L.O. corners. The topo call, in the G.L.O. notes, to Meadow Cr. on the west line of section 23 is too rough to be used for the location of the N.W. corner of section 23. I found no unusual conditions in this survey.

Duane I. Griffith
 Duane I. Griffith, OPLS 644
 Baggett, Griffith and Associates
 2006 Adams Ave.
 LaGrande, Oregon

LEGEND

- Found standard B.L.M. brass cap
- Found brass cap set by me in 1979— survey no. 57-79.
- Found brass cap set in 1970, by Voelz.
- ⊙ Found evidence of original corner; set 2 1/2" x 30" aluminum monument.
- Set 2-1/2" x 30" aluminum monument at proportionate position.
- () G.L.O. Record bearing & distance.
- < > Survey 57-79 record bearing & distance.
- Posted line.
- N F National Forest Lands
- P Privately owned lands

UNITED STATES DEPARTMENT OF AGRICULTURE
 FOREST SERVICE
 4-33-86
 5-1-86
 G. LANGRISH, DEPUTY
 14-86

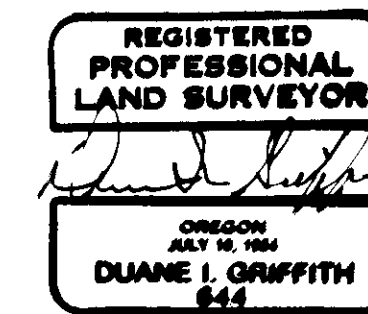

BAGETT - GRIFFITH & ASSOCIATES
 LaGrande, Oregon
 Map of Survey
 Section 22 & 23
 T 3 S, R 33 1/2 E, W.M.
 UNION COUNTY, OREGON

SURVEYED FOR	Wallowa Whitman Nat'l Forest
SURVEYED BY	dig - gtb - rgr
Scale: 1" = 500'	Drawn by: dig