
Survey Number 61

Survey Number 62 Survey Number 75-78

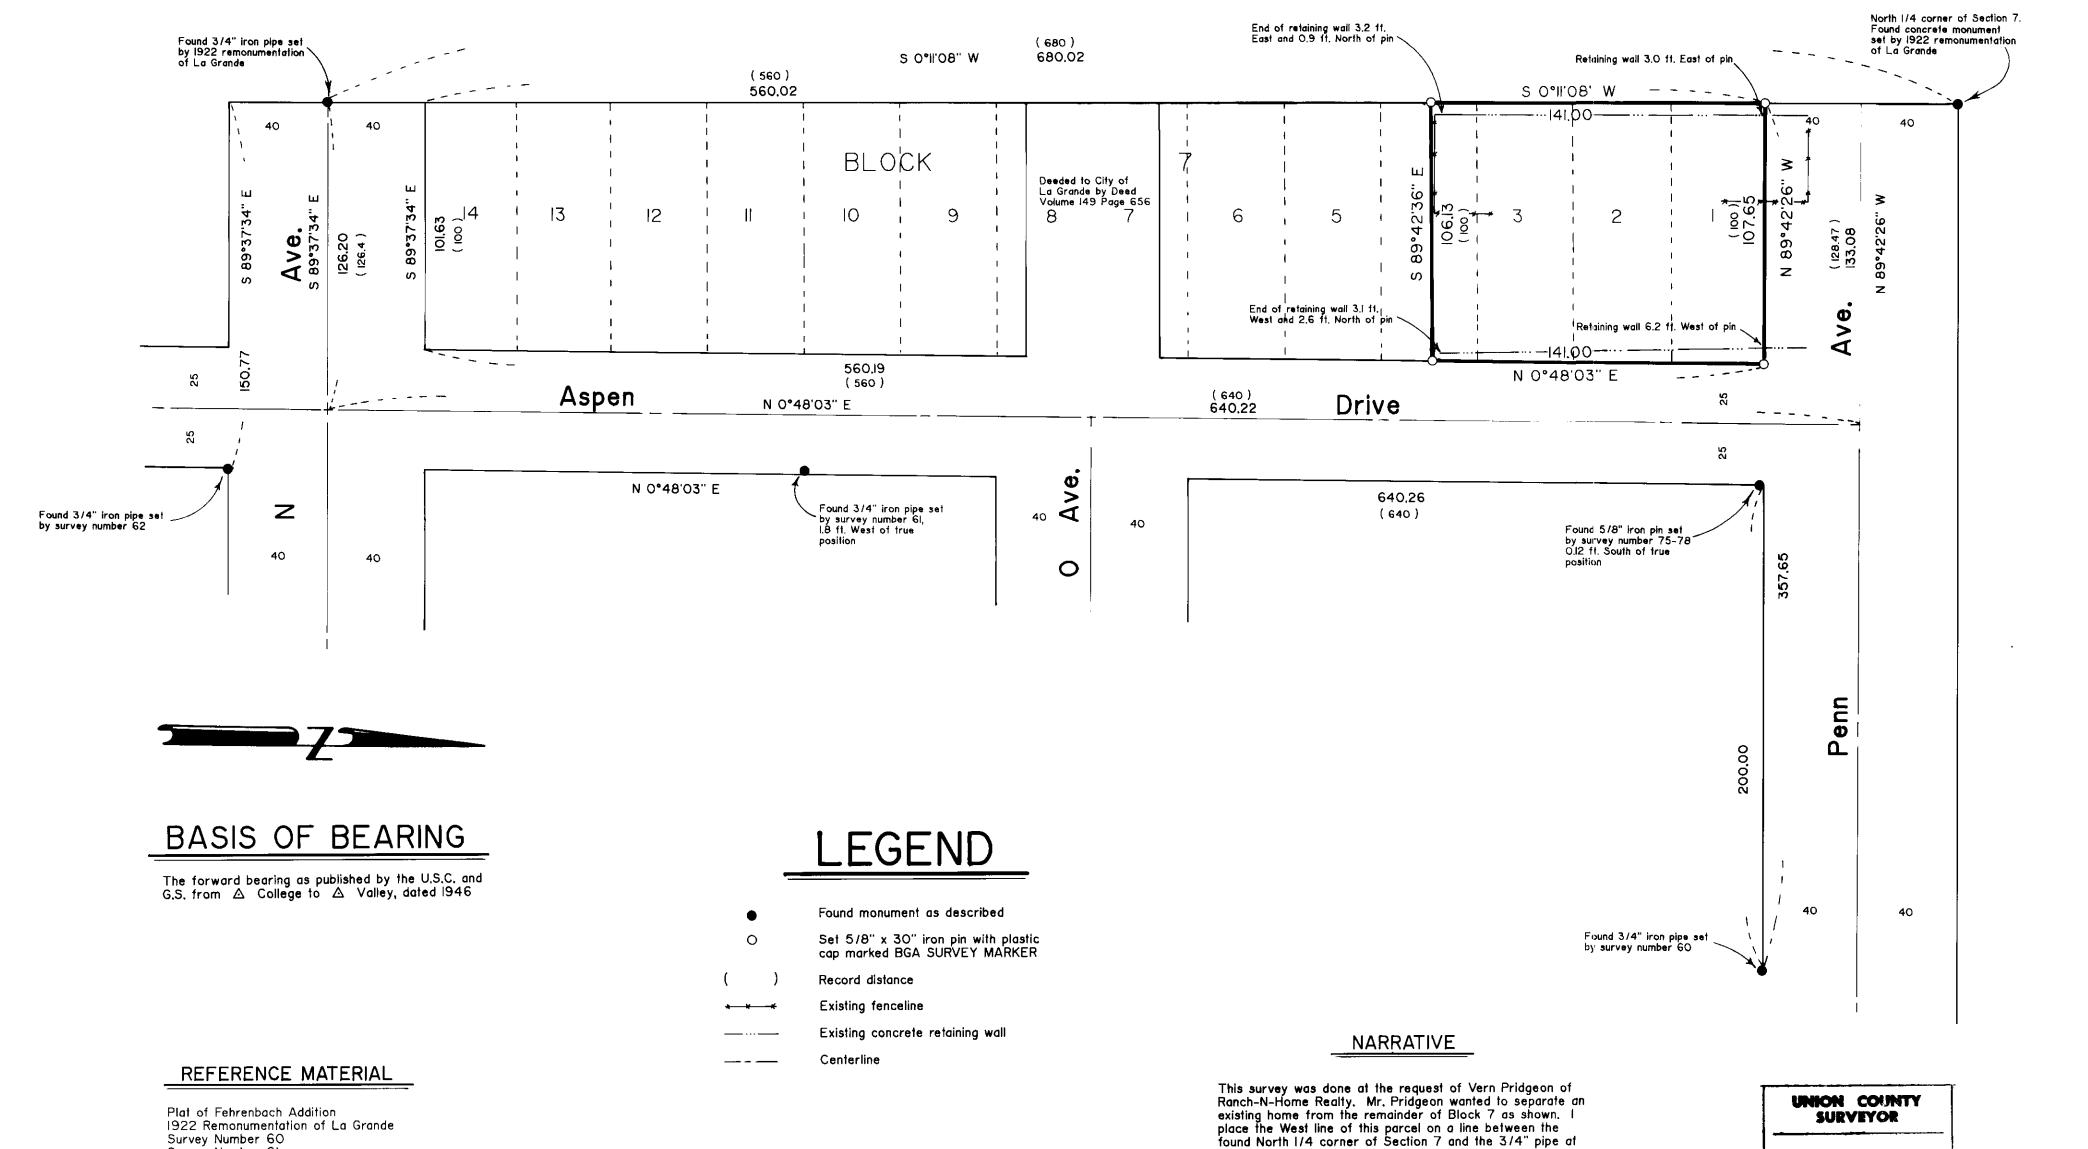

REGISTERED PROFESSIONAL LAND SURVEYOR

Cick G Robinson

OREGON JULY 17, 1998 RICK G. ROBINSON 2219

place the West line of this parcel on a line between the found North 1/4 corner of Section 7 and the 3/4" pipe at N Avenue as per the original plat and the 1922 remonumentation. The North line of this parcel was located by coming 80 feet South, along the previously established line, to establish the Northwest corner of the parcel, and driving a line to the 3/4" pipe set by survey number 60. I located Aspen Drive by driving a line from the 3/4" pipe found at the Southeast corner of the intersection of Aspen Drive and N Avenue, set by survey number 62, to a point 200 feet Westerly from the found 3/4" pipe along the Southerly line of Penn Avenue. This is the method used by survey number 75-78, which I fit harmoniously as shown. This creates an eyess at the North end of Block 7 as

This creates an exess at the North end of Block 7 as

shown. I find no other unusual conditions on this survey.

## Date Received 6/8/87 Date Filed 6-8-87

By G. LAWGLITZ, DEPUTY File No. /3-87

BAGETT - GRIFFITH & ASSOCIATES La Grande, Oregon
Map of Survey
Lots I, 2, 3 and a portion of Lot 4,
Block 7
Fehrenbach Addition
La Grande
UNION COUNTY. OREGON

SURVEYED FOR Ranch-N-Home Realty SURVEYED BY R.G.R. 6-87	 				
SURVEYED BY R.G.R. 6-87	SURVEYED FOR	Ranch-N-Home Realty			
	SURVEYED BY	R,G,R.	6-87		
Scale: I" = 40' Drawn by: R.G.R. 6-87	Scale:  " = 40'	Drawn by: R.G.R.	6-87		