


78-82

RECORD of SURVEY
BOISE-CASCADE'S ACALA GINNING SURVEY
T5S. R38 & 39 E WM
UNION COUNTY OREGON
Scale 1" = 1000' Date 9-25-87

Basis of Bearing is from a Solar Observation.

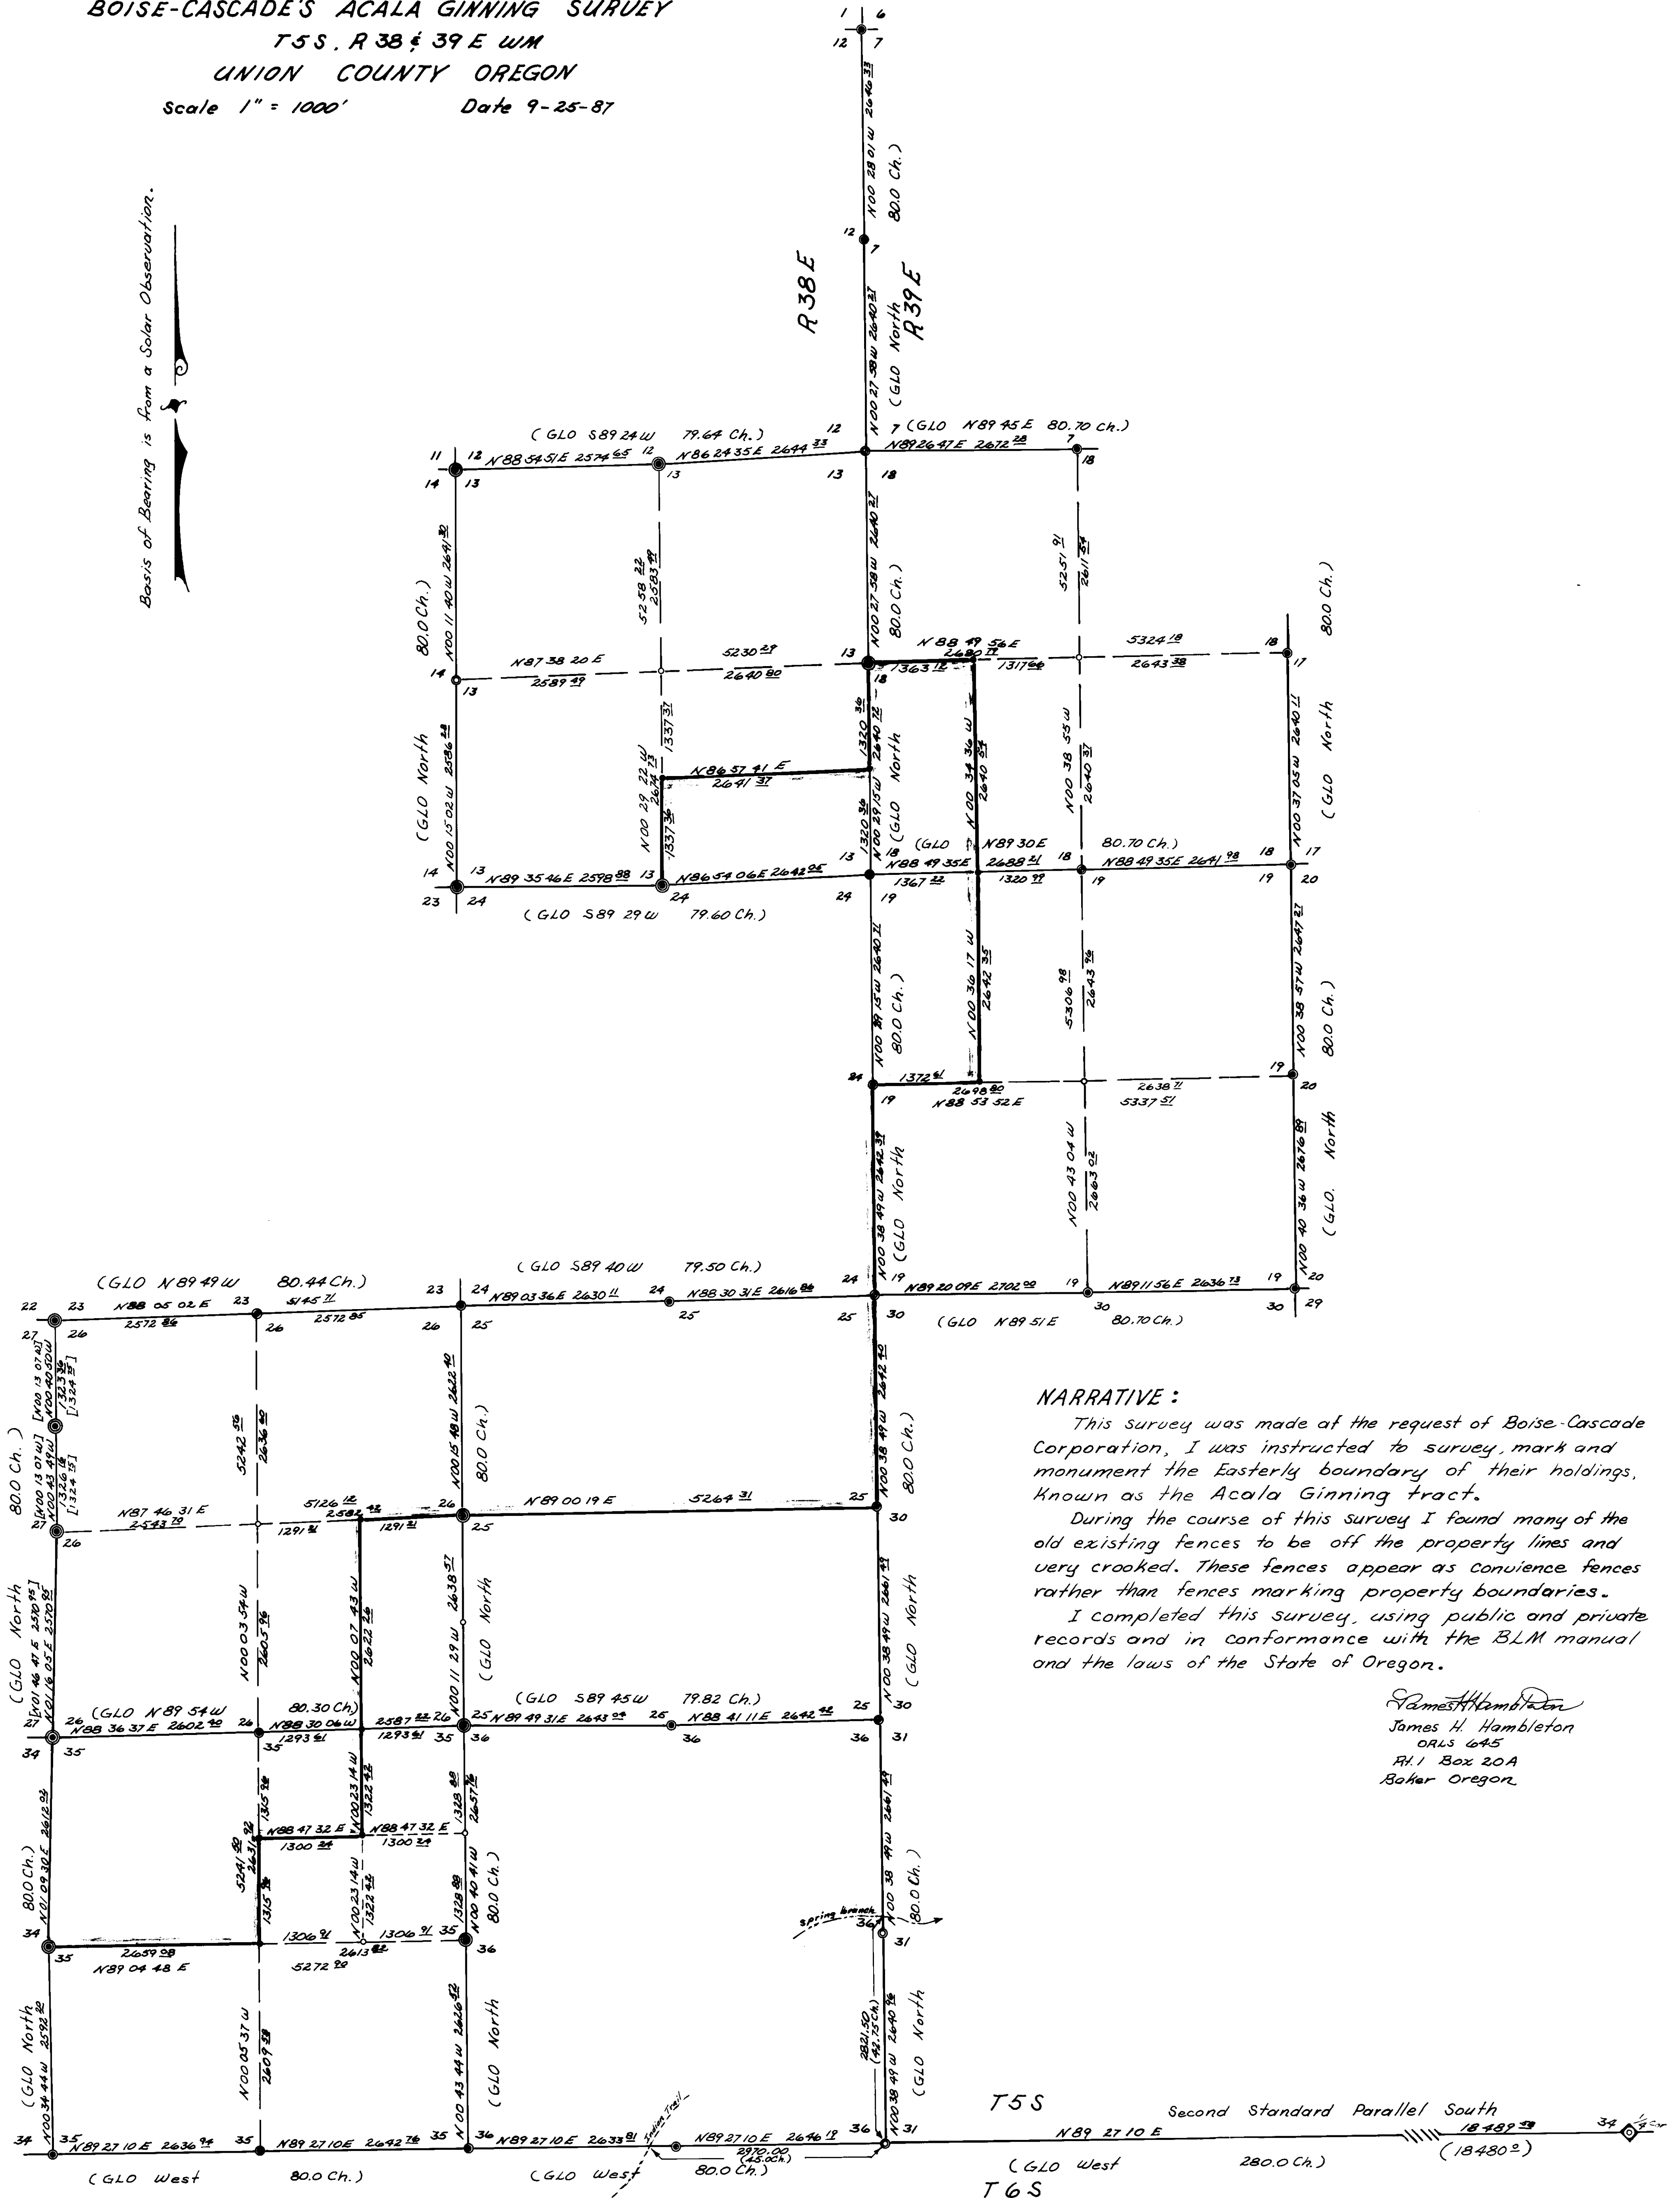

NARRATIVE :

This survey was made at the request of Boise-Cascade Corporation, I was instructed to survey, mark and monument the Easterly boundary of their holdings, known as the Acala Ginning tract.

During the course of this survey I found many of the old existing fences to be off the property lines and very crooked. These fences appear as convenience fences rather than fences marking property boundaries.

I completed this survey, using public and private records and in conformance with the BLM manual and the laws of the State of Oregon.

James H. Hambleton
James H. Hambleton
ORAS 645
P.O. Box 20A
Baker Oregon

LEGEND :

- Found brass cap monument of record.
- Found Original GLO corner, monumented this survey. Set Alum. Cap on 2" x 30" pipe with magnet in cap.
- Restored Original GLO corner using GLO topographic calls and adjacent corners. Set Alum. Cap on 2" x 30" pipe with magnet in cap by proportionate measurements.
- Set Alum. Cap on 2" x 30" pipe with magnet in cap by proportionate measurements.
- ◇ Found GLO corner, did not monument this survey.
- Set Alum. Cap on 2" x 30" pipe with magnet in cap, this survey.

— Property Line surveyed and marked.

- [] Record survey bearing & distance.
- () G.L.O. bearing & distance.

REFERENCE MATERIAL :

- 1 - GLO Notes, Contract No. 102, dated July 20, 1863
Deputy Surveyor Timothy W. Davenport.
- 2 - GLO Notes, Contract No. 103, dated Sept. 3, 1863
Deputy Surveyor D. P. Thompson.
- 3 - GLO Notes, Contract No. 338, dated May 7, 1881
Deputy Surveyor W. B. Barr.
- 4 - Union County Record Survey No. 48-84, dated 11-13-84
surveyed by Gary L. Langlitz.

NOTE :

For monumentation information see Record of Corner Monumentation sheet filed seperatly.

| | |
|------------------------------|---------------------|
| UNION COUNTY SURVEYOR | |
| Date Received | 9-22-87 |
| Date Filed | 11-2-87 |
| By | G. LANGLITZ, Deputy |
| File No. | 28-87 |

James H. Hambleton
9-25-87