15-88

LEGEND

● Found 5/8" iron pin as per plat of Grande Ronde Medical Center Subdivision

○ Set 5/8" x 30" iron pin with plastic cap marked BGA SURVEY MARKER

Found remains of old fenceline

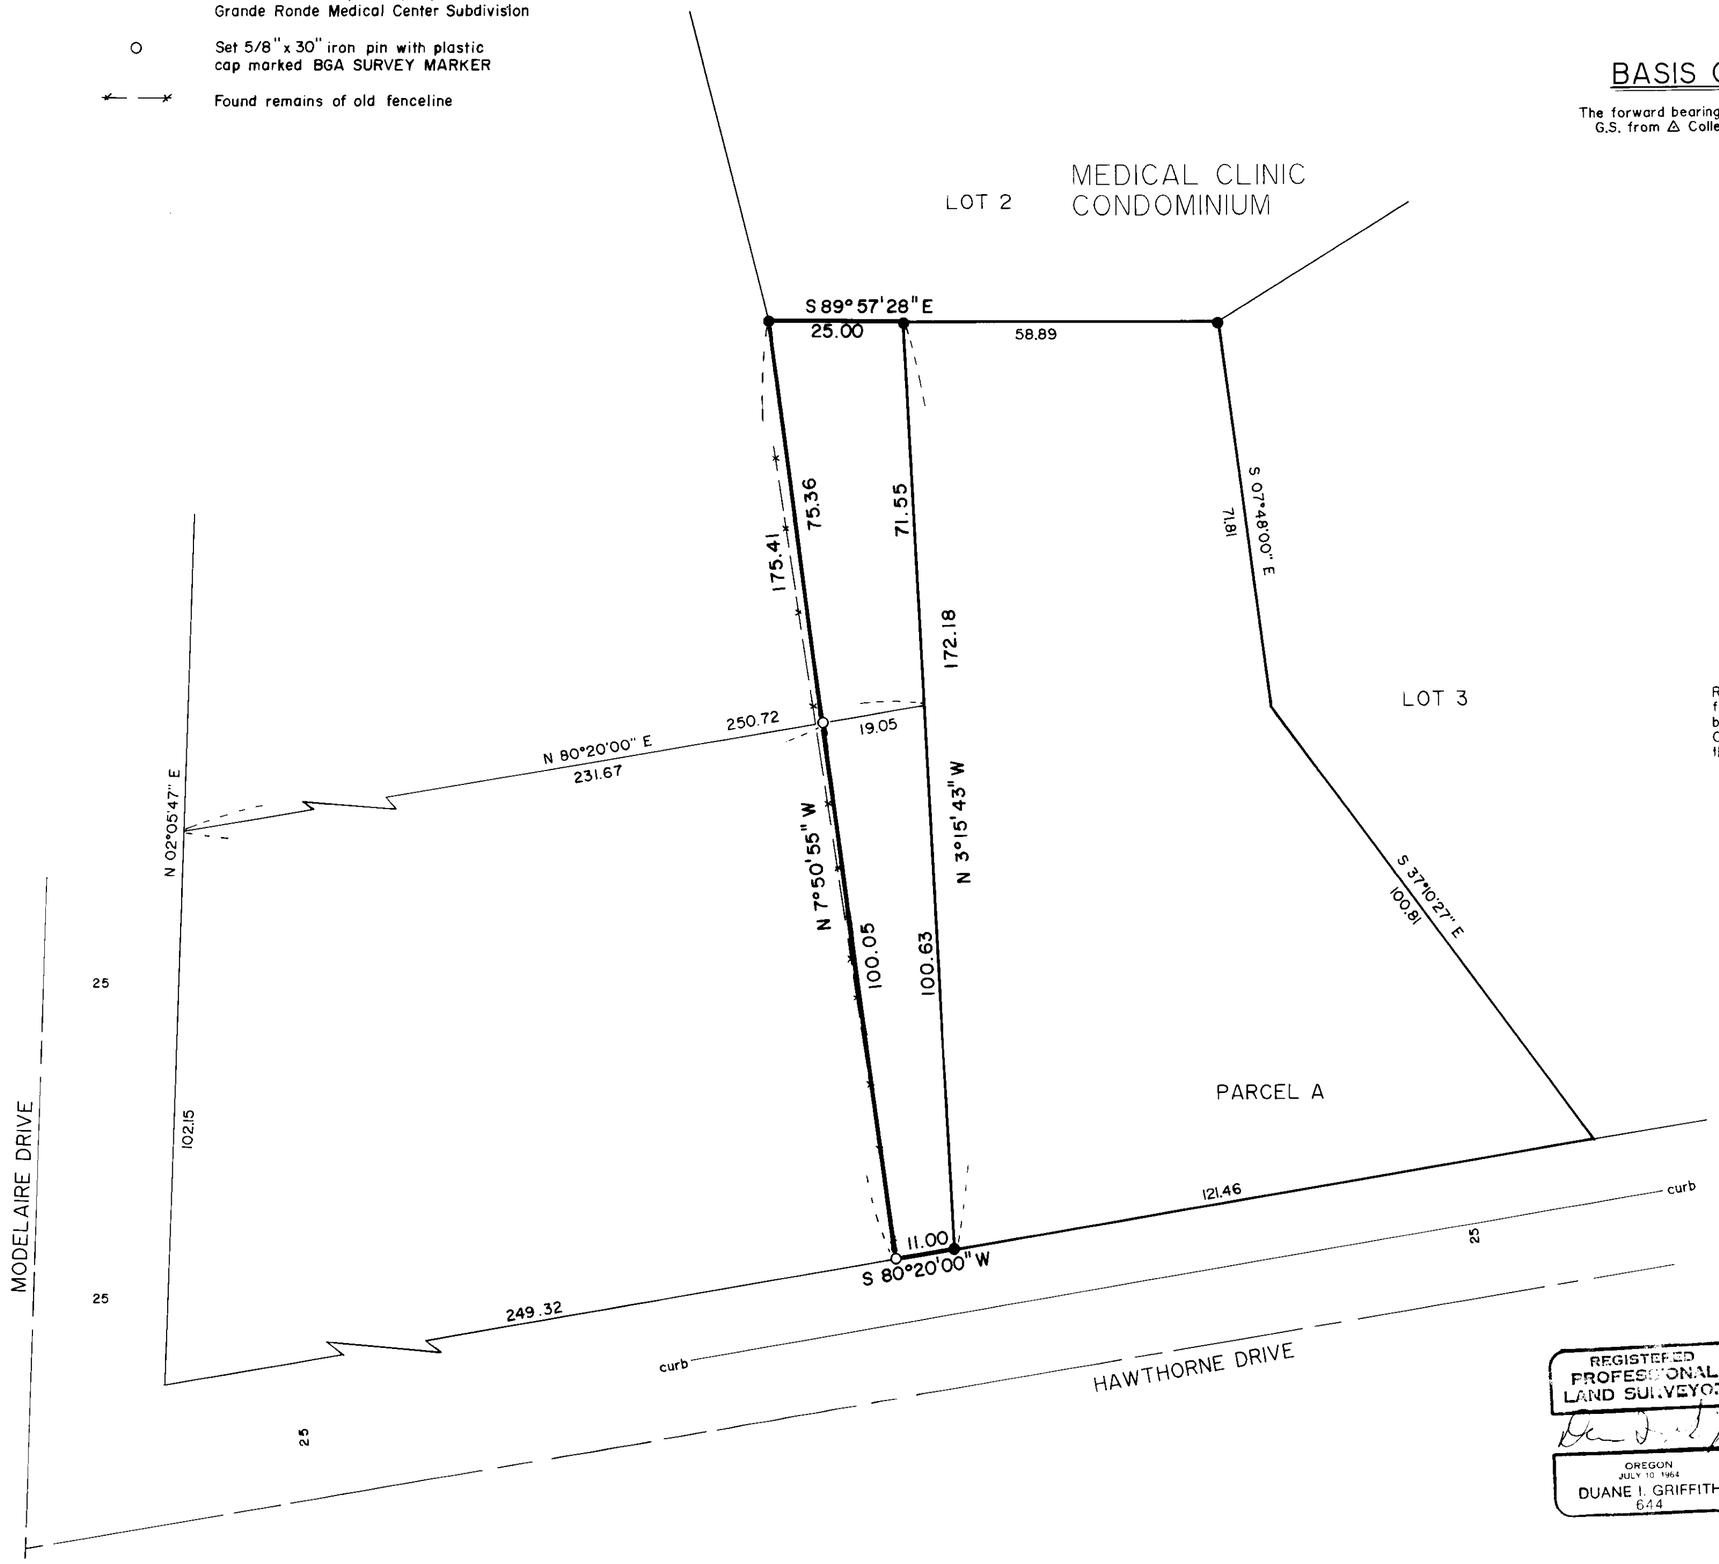

BASIS OF BEARING

The forward bearing as published by the U.S.C. and G.S. from △ College to △ Valley, dated 1946.

REFERENCE MATERIAL

Union County Deed Records Microfilm nos:
121122
121123
120268

Plat of Grande Ronde Medical Center Subdivision

NARRATIVE

This survey was done at the request of the Grande Ronde Hospital to adjust the west boundary of parcel A to fit more closely to the remains of the old fence line. I base my survey on the plat of Grande Ronde Medical Center Subdivision. I found no unsual conditions concerning this survey.

UNION COUNTY SURVEYOR

Date Received 5-11-88
Date Filed 5-16-88
By G. LANGLITZ, DEPUTY
File No. 15-88

REGISTERED PROFESSIONAL LAND SURVEYOR
OREGON JULY 10 1964
DUANE I. GRIFFITH 644

BAGETT - GRIFFITH & ASSOCIATES
LaGrande, Oregon

Map of Survey

A parcel of land in the northwest quarter of the southeast quarter of section 7, Township 3 South, Range 38 East, Willamette Meridian.

UNION COUNTY, OREGON

SURVEYED FOR	Grande Ronde Hospital	
SURVEYED BY	DIG	4-18-88
Scale: 1" = 20'	Drawn by: JPP	4-25-88

15-88