
S AVENUE

from reference monuments.

Position determined

Survey no. 79-80

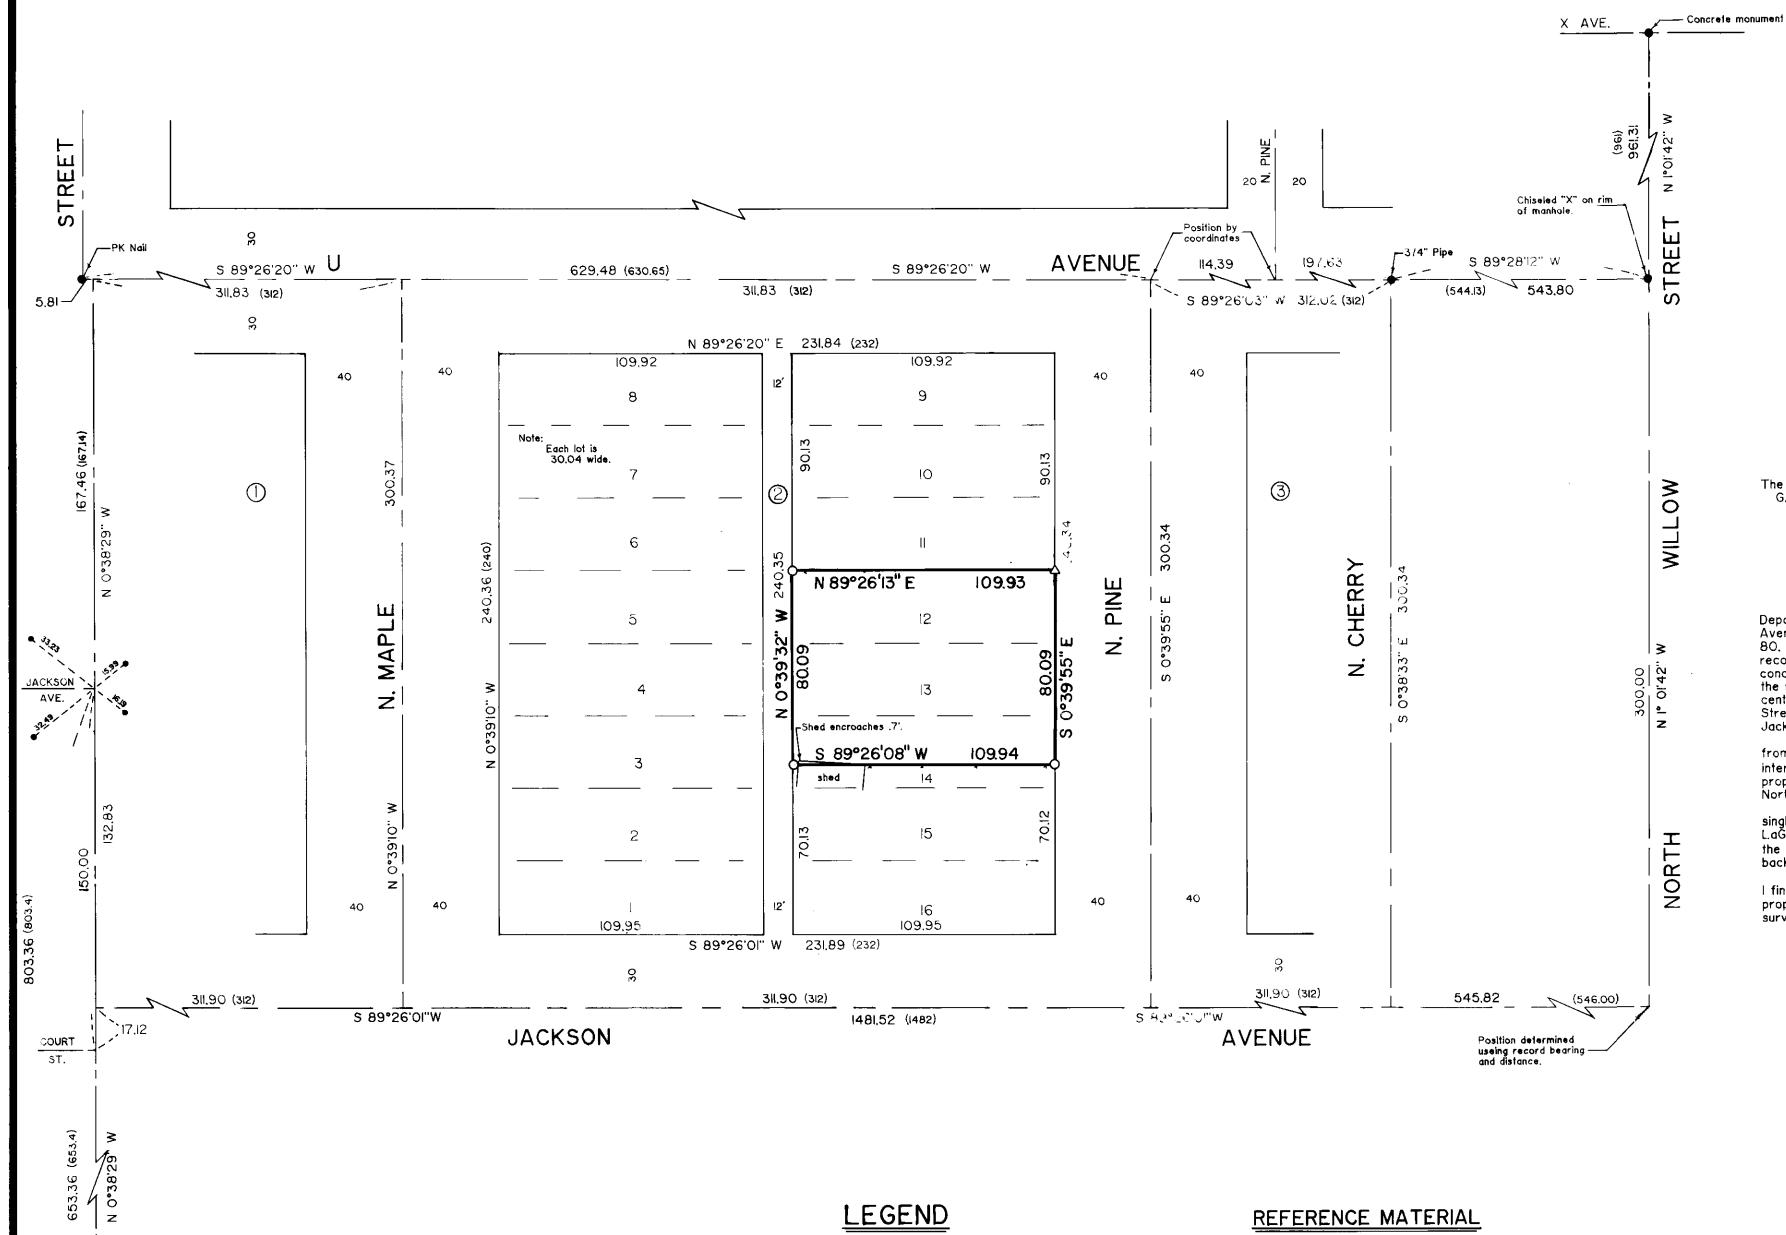

Set 5/8" × 30" iron pin with plastic cup marked BGA SURVEY MARKER.

Set 50d spike with plastic cap marked

BGA SURVEY MARKER, in root crown of

29" Chinese Elm tree at corner position.

Record distance

Found monument as noted.

0

Δ

( )

## BASIS OF BEARING

The forward bearing as published by the U.S.C. and G.S. from  $\Delta$  College to  $\Delta$  Valley, dated 1946.

## NARRATIVE

This survey was ordered by Lynn Greer of the Department of Veterans Affairs. The centerline of U Avenue was established by survey numbers 67-78 and 57-80. I established the centerline of Jackson and Willow at record distance on the projected bearing from the concrete monument at Willow and X Avenue and the X's on the manhole rim at U Avenue and Willow. Spruce Street centerline was established from S Avenue to Jackson Street west by survey no. 79-80. I proportion Spruce and Jackson Street east on this established line.

I then project the centerline of Spruce, as established from S Avenue to Jackson Street west, northerly to the intersection of the centerline of U Avenue. I then proportion the intersections of Jackson and Maple, Pine, and North Cherry on a single proportion.

The intersection of U Avenue and Pine is placed by single proportion. There were references by the City of LaGrande to the 3/4" pipe at this intersection. I find that the reference to the baseball backstop to be void as the backstop has been rebuilt and the ties are not harmonious.

I proportion the lots in Block 2 in the standard manner.
I find that an existing shed encroaches onto the surveyed property by .7 of a foot. I find no other problems with this

## UPHON COUNTY SURVEYOR

Data Roceived 6.20.88

Date Filled 6-27-88

BY G. LANGUTZ DOWN

File No. 17-88



Gregory T. Blackman

Survey no. 67-80

Survey no. 57-80

Survey no. 79-80

Plat of 1922 remonumentation of LaGrande.

REGISTERED PROFESSIONAL LAND SURVEYOR

OREGON GREGORY T. BLACKMAN 991

## BAGETT - GRIFFITH & ASSOCIATES LaGrande, Oregon

MAP OF SURVEY Lots 12, 13, and a portion of lot 14. Block 2 Acme Addition LaGrande, OR

UNION COUNTY, OREGON

SURVEYED FOR Department of Veterans Affairs SURVEYED BY GTB 6-10-88 Drawn by: Jpp Scale: |" = 40" 6-10-88