



BASIS OF BEARING

The forward bearing as published by the U.S.C. and G.S. from \triangle College to \triangle Valley, dated 1946.

LEGEND

- Set 5/8" × 30" iron pin with plastic cap marked BGA SURVEY MARKER.
- Found 5/8" iron pin,
- Found 1/2" iron pipe,
- Found 2 1/2" brass cap.
- () Record information from survey no. 2-82.
- Record information from survey no. 21-77.

NARRATIVE

This survey was ordered by Maggie Dean executive director of Northeast Oregon Housing Authority. The south and east lines of this parcel were established by survey no. 2-82. The Housing Authority purchased one acre of property from the neighbor to the west. We ran the west line parallel to the east line and maintained the bearing of the line on the north as established by survey no. 2-82 and 21-77. Both northeast and northwest monuments were set as ten foot reference pins, as the pins would fall so close to the maintained road that I believed they would be destroyed by road maintenance. I find no other problem with this survey.


REFERENCE MATERIAL

Union County Survey no. 18-77 21-77 2-82

Union County Deed Records Microfilm no, 104123 104204



Date Received 12-8-88 Date Filed 12-9-88 Ey G. LANGLITZ DEPUTY File No. 43-88

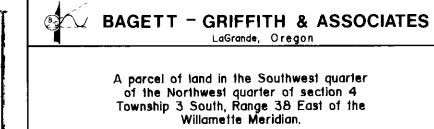

REGISTERED PROFESSIONAL

	UNION COUNTY, OREGON		
	SURVEYED FOR	Northeast Oregon Housing Authority	
	SURVEYED BY	GTB	11-30-88
	Scale: " = 50"	Drawn by: JPP	12-88