117340

17-89

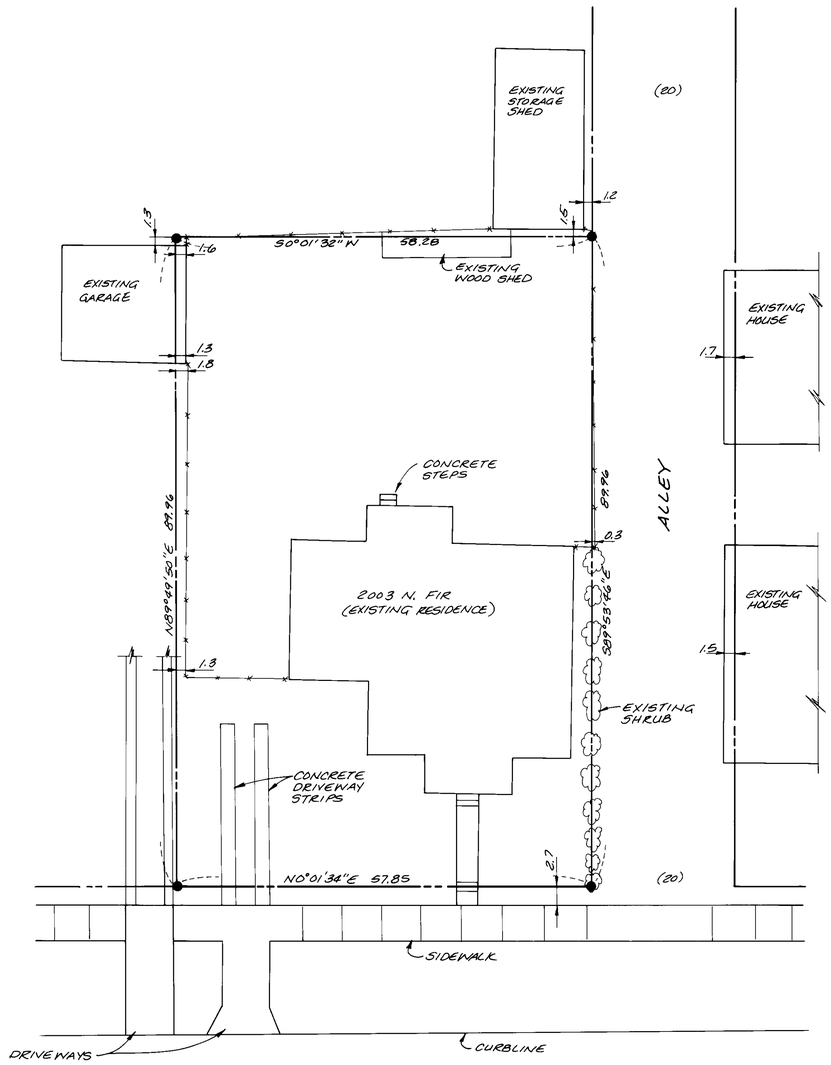

DETAIL

1"=10'

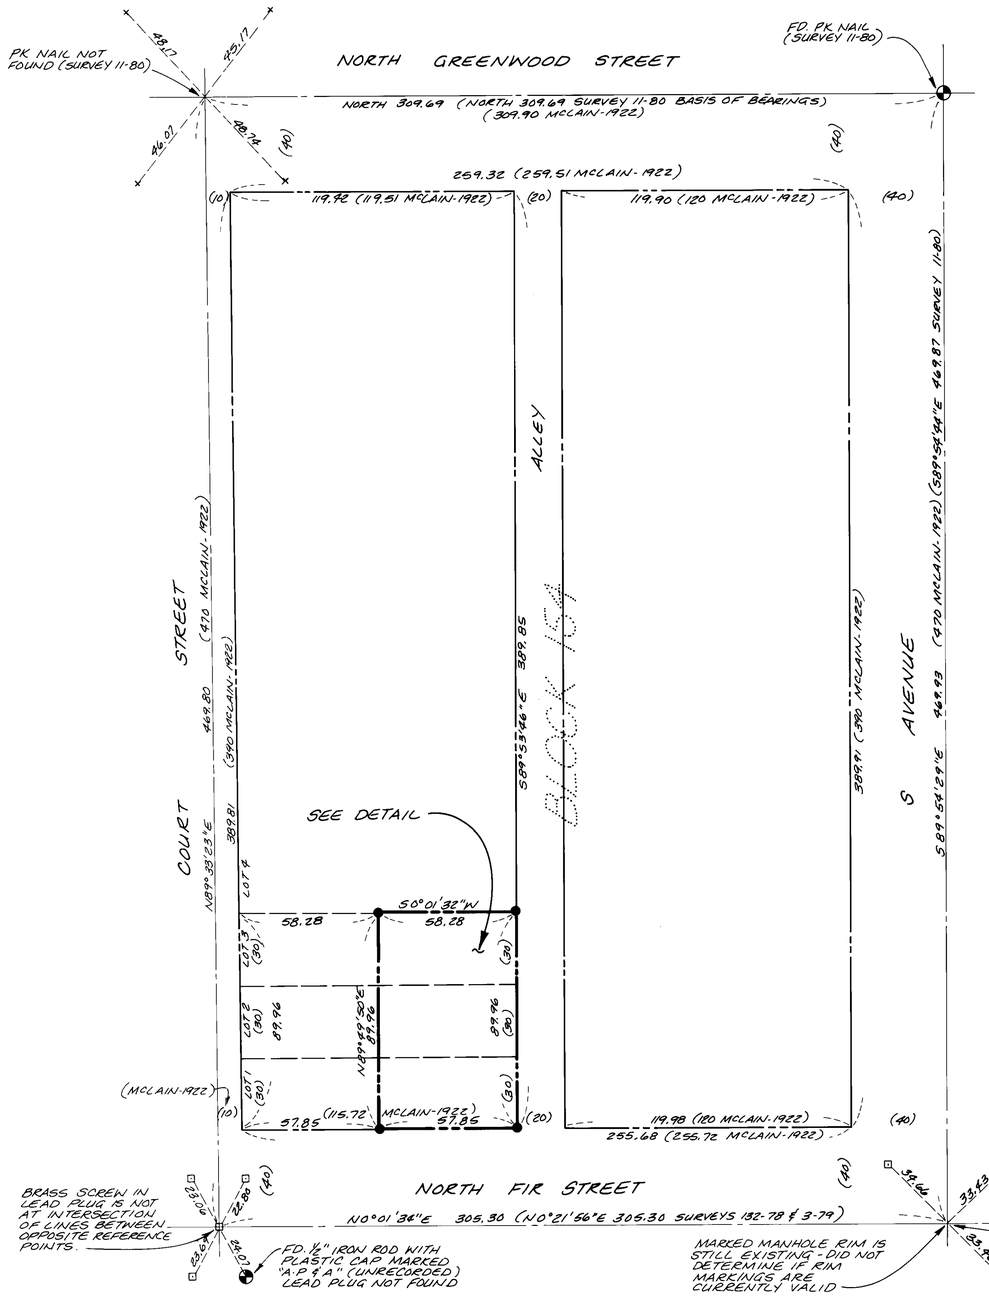

SCALE : 1"= 30'

BASIS OF BEARINGS

NORTH AS SHOWN ALONG THE CENTERLINE OF NORTH GREENWOOD STREET (SURVEY 11-80)

LEGEND

- ◓ FOUND MONUMENT AS DESCRIBED
- × FOUND CHISELED "X" ON SIDEWALK AS DESCRIBED ON SURVEY 11-80
- ⊡ FOUND BRASS SCREW IN LEAD PLUG (McLAIN-1922)
- ● SET 5/8" x 30" IRON ROD (CONCRETE REINFORCING ROD) WITH YELLOW PLASTIC CAP MARKED "A.P.& A."
- ( ) DIMENSION FROM THE SUPPLEMENTAL PLAT OF CHAPLIN'S ADDITION TO LAGRANDE, OR AS NOTED
- EXISTING FENCE

REFERENCE MATERIAL

UNION CO. DEED MICROFILM 123966

SUPPLEMENTAL PLAT OF CHAPLIN'S ADDITION TO LAGRANDE, OREGON, PLAT CABINET A-12

UNION COUNTY SURVEYS:
CITY OF LAGRANDE RESURVEY, McLAIN-1922
SURVEYS 132-78, 3-79, 11-80

NARRATIVE

THIS SURVEY WAS PERFORMED AT THE REQUEST OF MIKE AND SUE DAUGHERTY. EXISTING SURVEY MONUMENTS AND IMPROVEMENTS ON AND AROUND THE PARCEL SURVEYED WERE FOUND AS NOTED. THE PROPORTIONAL BLOCK AND LOT DIMENSIONS SHOWN ARE BASED ON THE DIMENSIONS SHOWN ON THE ORIGINAL DRAWING OF THE SUPPLEMENTAL PLAT OF CHAPLIN'S ADDITION AND ON THE CITY OF LAGRANDE RESURVEY BY MCLAIN IN 1922.

UNION COUNTY SURVEYOR
Date Received 8-21-89
Date Filed 8-22-89
By: G. LANGLITZ, DEPUTY
File No. 17-89

REGISTERED PROFESSIONAL LAND SURVEYOR
OREGON
JULY 22, 1977
GARY L. LANGLITZ
1099

SOUTH 1/2 OF LOTS 1, 2, 3, BLOCK 159, SUPPLEMENTAL PLAT OF CHAPLIN'S ADDITION TO LAGRANDE UNION COUNTY, OREGON

FOR: MIKE & SUE DAUGHERTY 96 OAK ST. LAGRANDE, OR

SCALE: AS SHOWN
DATE: AUG. 1989
JOB NO. 2705-50

anderson perry & associates, inc.
engineering · surveying · materials testing
LA GRANDE, OR. WALLA WALLA, WA. LEWISTON, ID.

SHEET NO. 1/1

17-89