

WILLIAM R. WELLS

PENDLETON, OREGON 97801


PHONE: (503) 276-6362

P.O. BOX 1696

S35 S36

ALSO BEING CORNER 3,


TRACT 061405

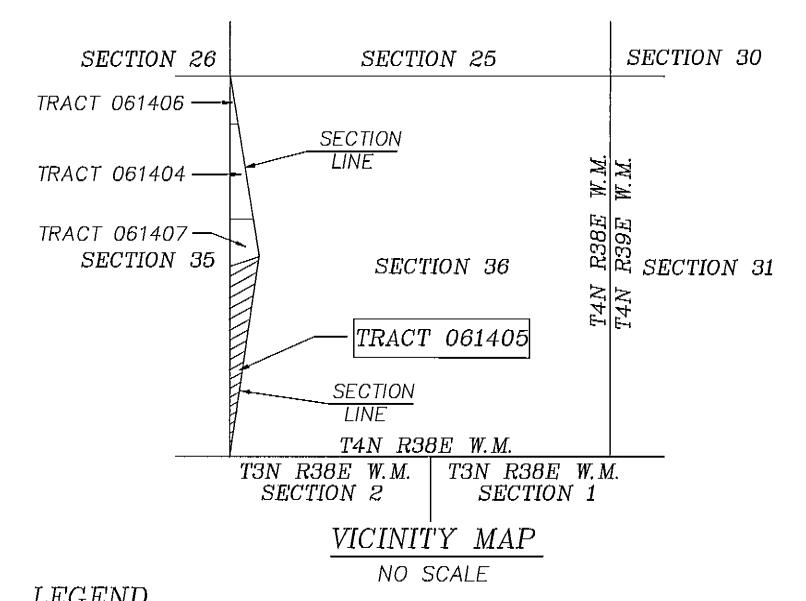

## LEGEND

- FOUND 2 1/2" BRASS CAP ON 2 1/2" GALV. IRON PIPE. SEE CO. SURVEY RECORD NO. 5-83-R AND 51-88-R.
- FOUND 2 1/2" ALUM. CAP ON 2 1/2" ALUM. PIPE. SEE CO. SURVEY RECORD NO. 144-88-R.
- FOUND 5/8" IRON PIN WITH 1 1/2" YELLOW PLASTIC CAP MARKED "W.R. WELLS, PLS 1106". SEE CO. SURVEY RECORD NO. 34-87.
- FOUND 2 1/2" BRASS CAP ON 2 1/2" GALV. IRON PIPE SET BY LS 933. SEE CO. SURVEY RECORD 71-79 AND 3-83-R. THIS MONUMENT WAS REPLACED BY A 2 1/2" BY 30" ALUM. PIPE WITH 2/1/2" ALUM. CAP. SEE CORNER RECORD FILED SEPARATELY.
- (XOX)R1 GLO RECORD BY DEPUTY SURVEYOR FRANK W. CAMPBELL, CONTRACT NO. 468, DATED APRIL 12, 1883.
- (XOX)R2 RECORD BY LS 1106, CO. SURVEY RECORD NO. 34-87.
- RECORD BY LS 933, CO. SURVEY RECORD NO. 71-79. (XOX)R3

BOUNDARY POSTED WITH 6 FOOT STEEL OR WOOD FENCE POSTS WITH SIGNS 54-2 ATTACHED.

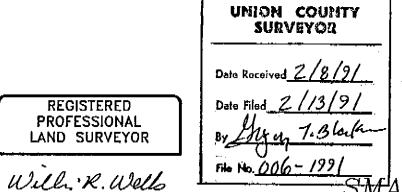

OREGON

JULY 22, 1977 WILLIAM R. WELLS 1106

RECORD OF SURVEY IN THE UMATILLA NATIONAL FOREST

SMALL TRACTS ACT TRACT NO. 061405 LOCATED IN SECTION 35, T4N, R38E, W.M., UNION COUNTY, OREGON

\STAGROTE.DWG