


Al Westenskow
 1810 W 4th St.
 La Grande, Oregon

Date, Feb. 4, 1971

Scale 1"=100'

Unrecorded

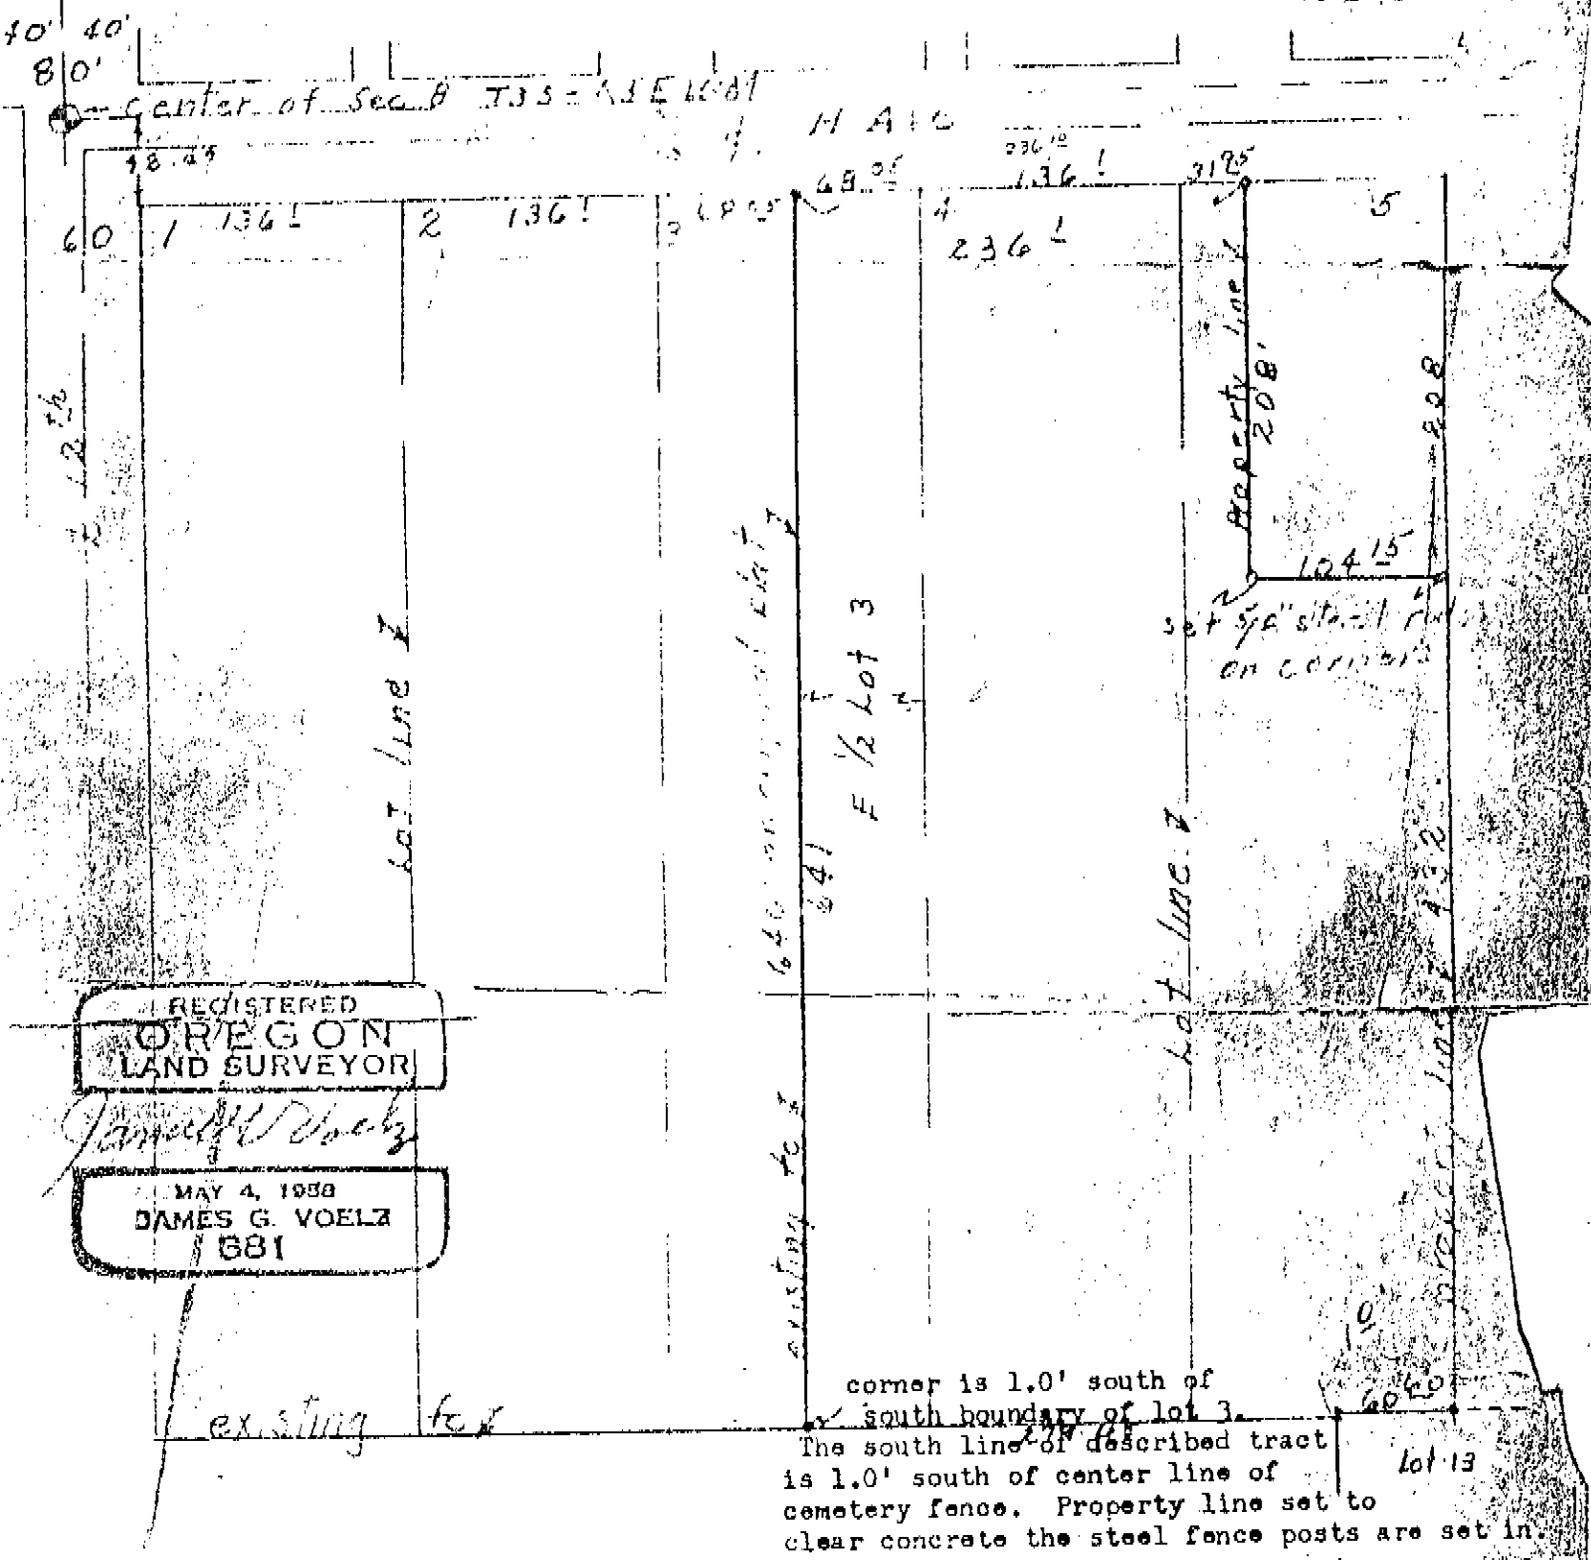

REGISTERED
 OREGON
 LAND SURVEYOR

James G. Voelz

MAY 4, 1958
 JAMES G. VOELZ
 681

Legal description:
 Beginning at a point on the north line of lot 3 and 68.05 feet east of north west corner of lot 3 of Homesite Acres to La Grande, Union County, Oregon; thence south on the center line of lot 3 said addition a distance of 641 feet to the north boundary of land owned by La Grande Cemetery Maintenance District, a municipal corporation, as provided in property line agreement dated April 10, 1968, recorded in deed book 157, page 40, Union County, Oregon; thence east parallel to and one foot south of lots 3, 4 and 5 of said addition a distance of 279.65 feet; thence north 1.0 ft. to south boundary of lot 5 said addition; thence east a distance of 60.60 feet to southeast corner of lot 5 said addition; thence north on east boundary of said addition 432 feet to a point which is 208 feet south of northeast corner said lot 5; thence west 104.15 feet; thence north 208 feet to north line of said lot 5; thence west on the north boundary of lots 5, 4 and 3 a distance of 236.1 feet to point of beginning.

Situate in NW 3/4 Sec. 8, Township 3 South, Ra. 38 East of the Willamette Meridian, Union County, Oregon, and containing 4.081 Acres more or less.

UR 1 015016-1991-0015
 UR#1