
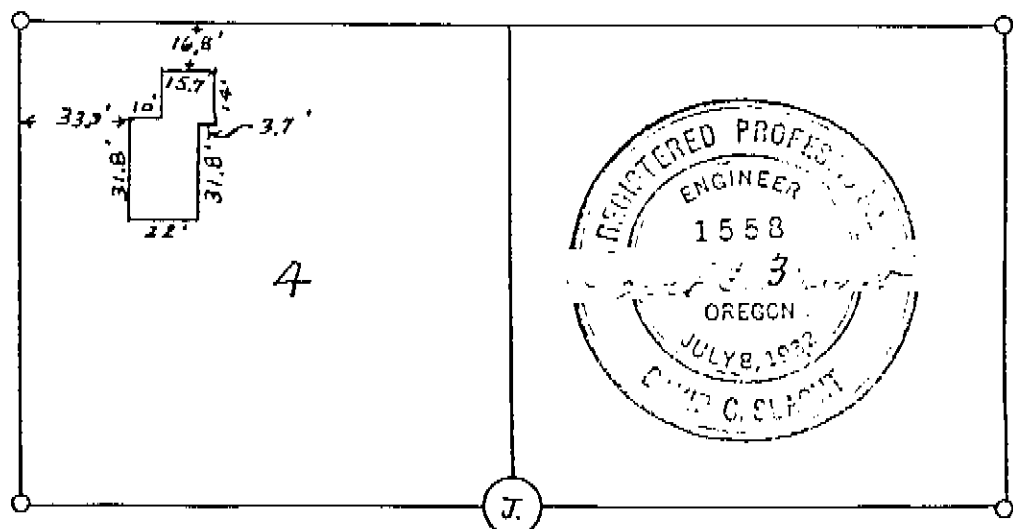


UR-40

Sheet 1 of 2

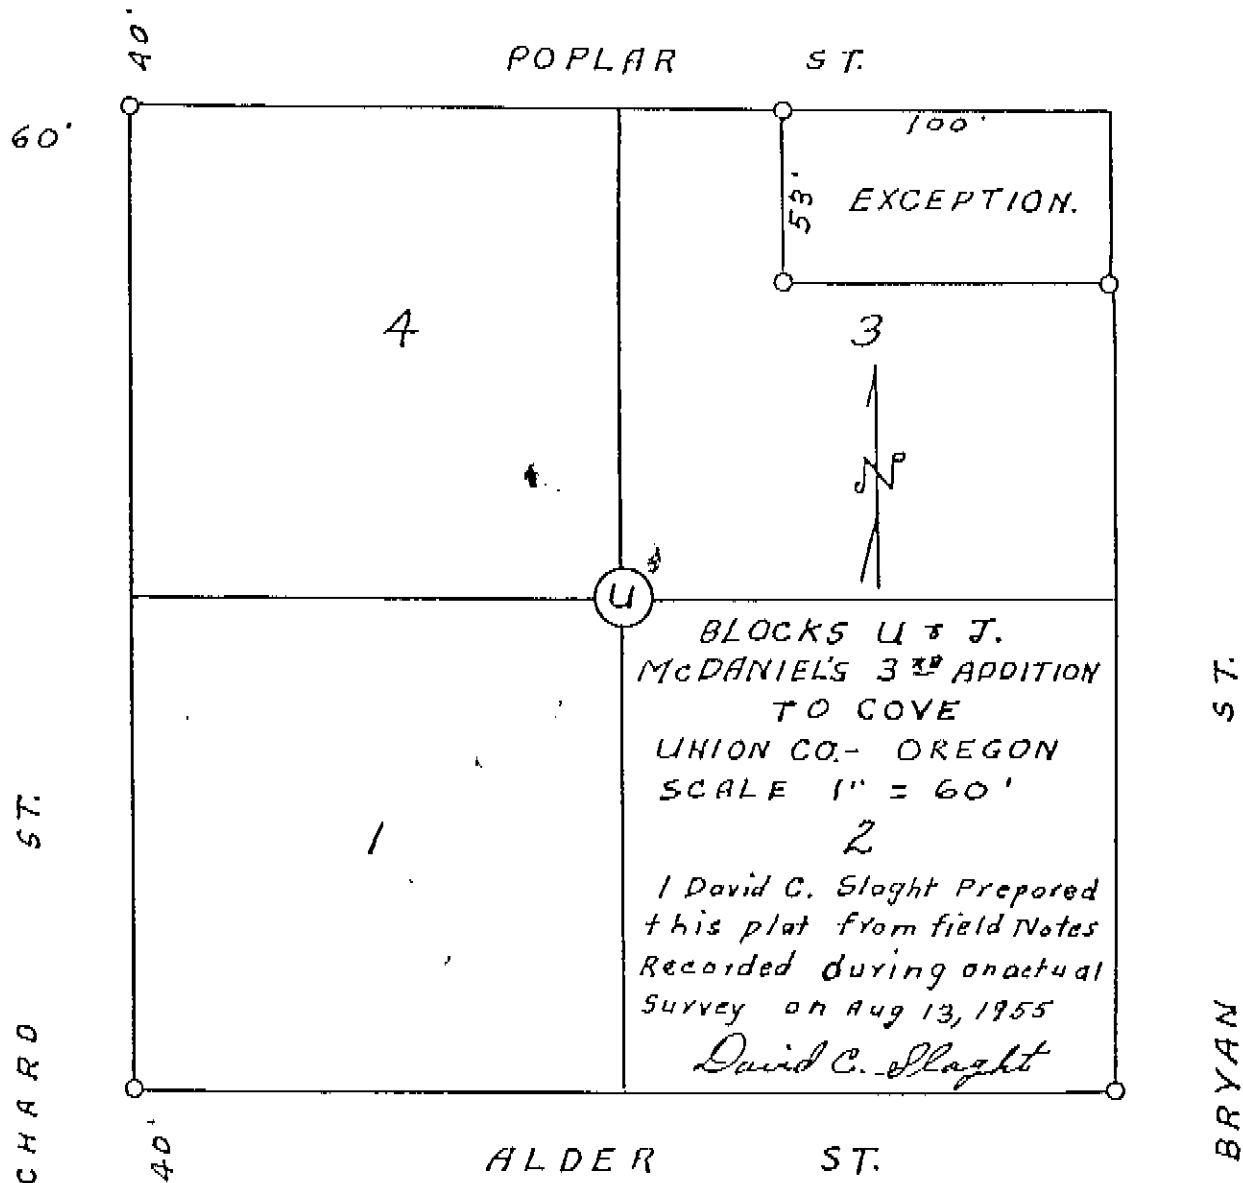

018-1991