
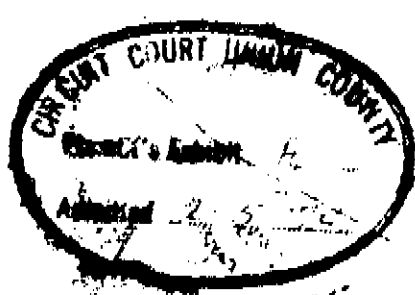
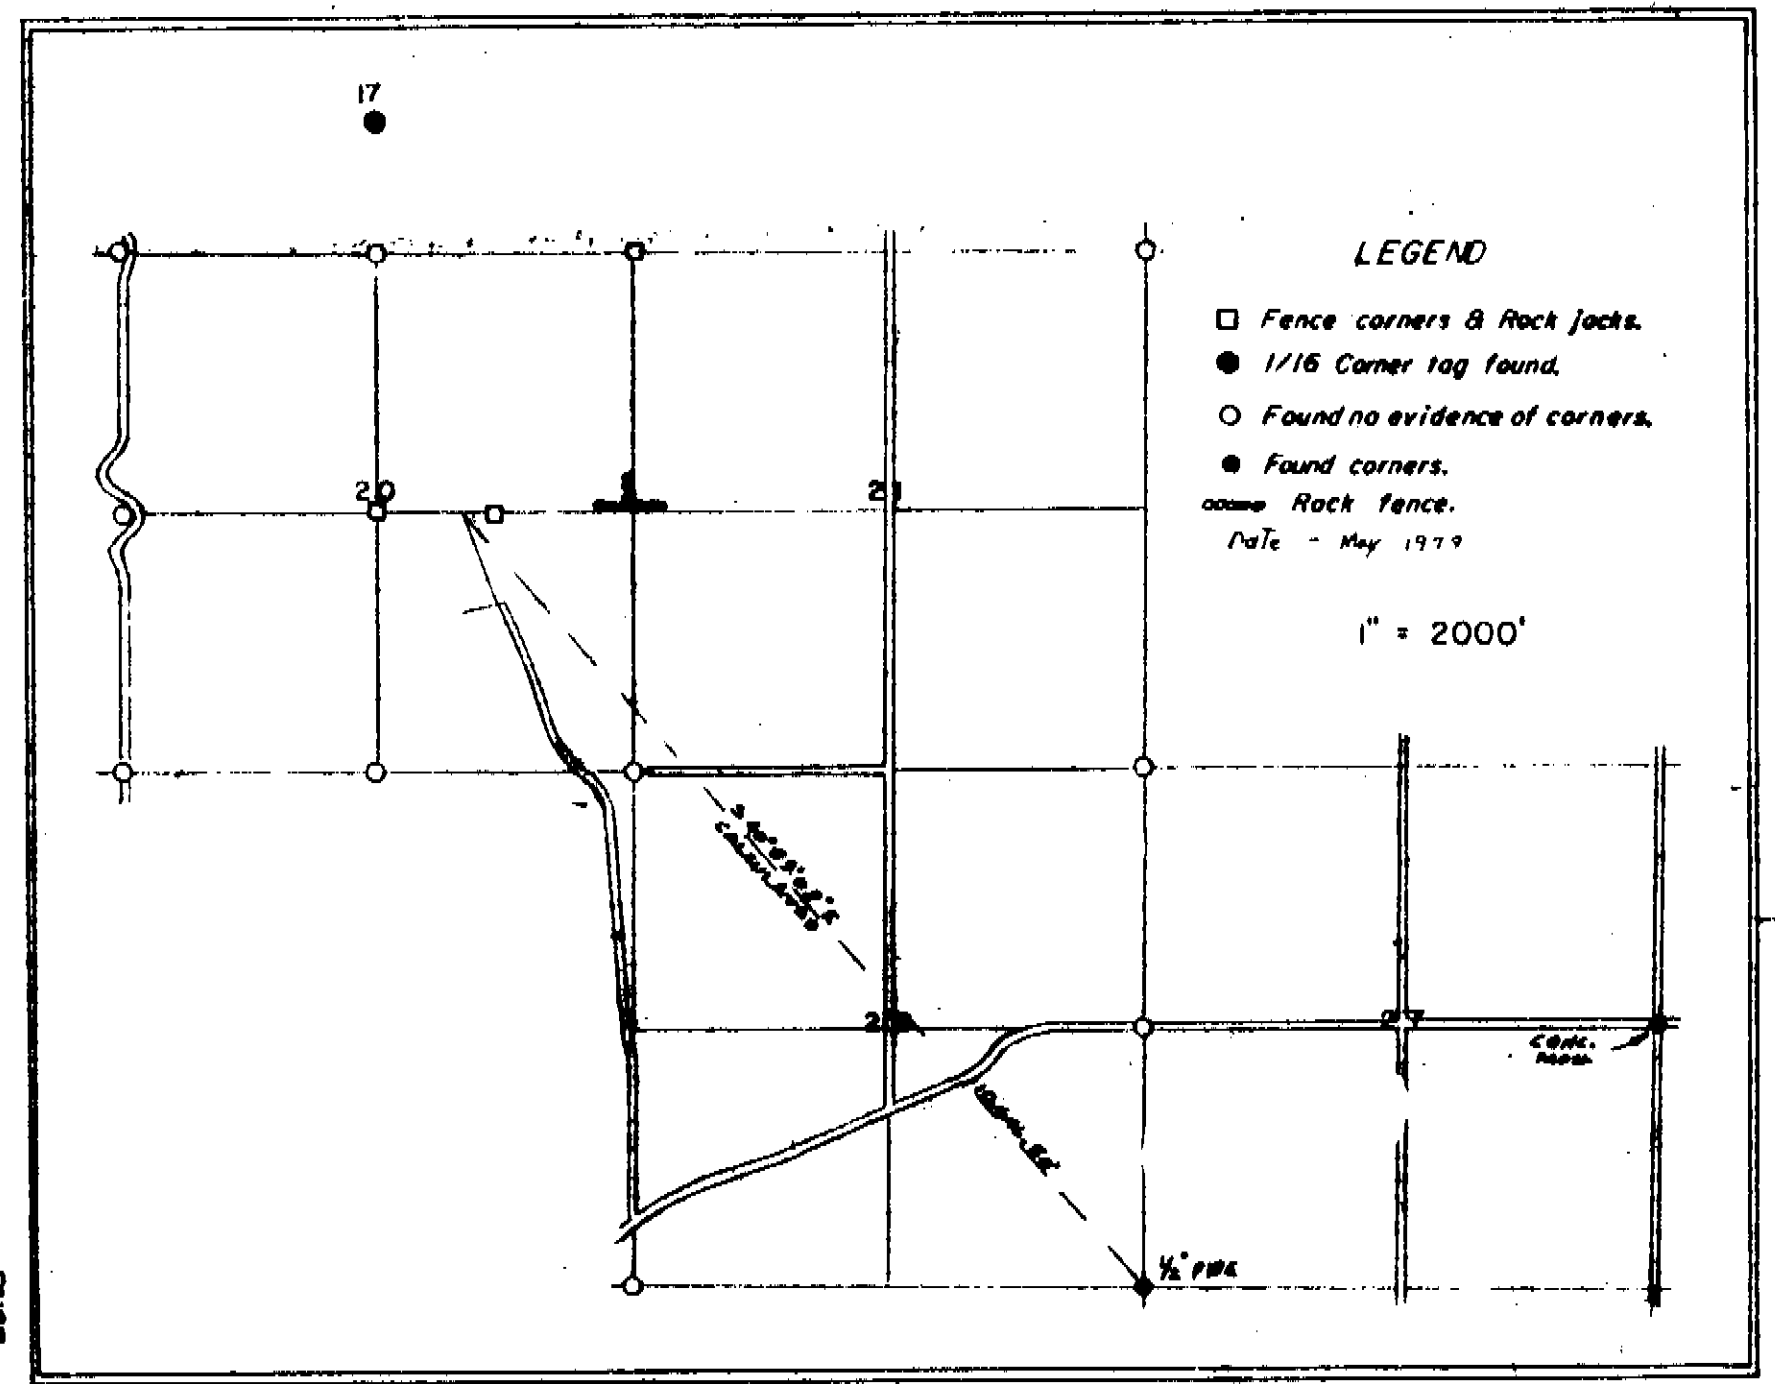


**MONTE CARNES**


**LEGEND**

1" = 100'

- Set 5/8" x 30" Steel Rods.
- Fence Posts & Rock Jacks.
- Found no evidence of corners.
- o-o-o Rock fence.
- - - Fences.
- Basis of Bearings - Polar observations.

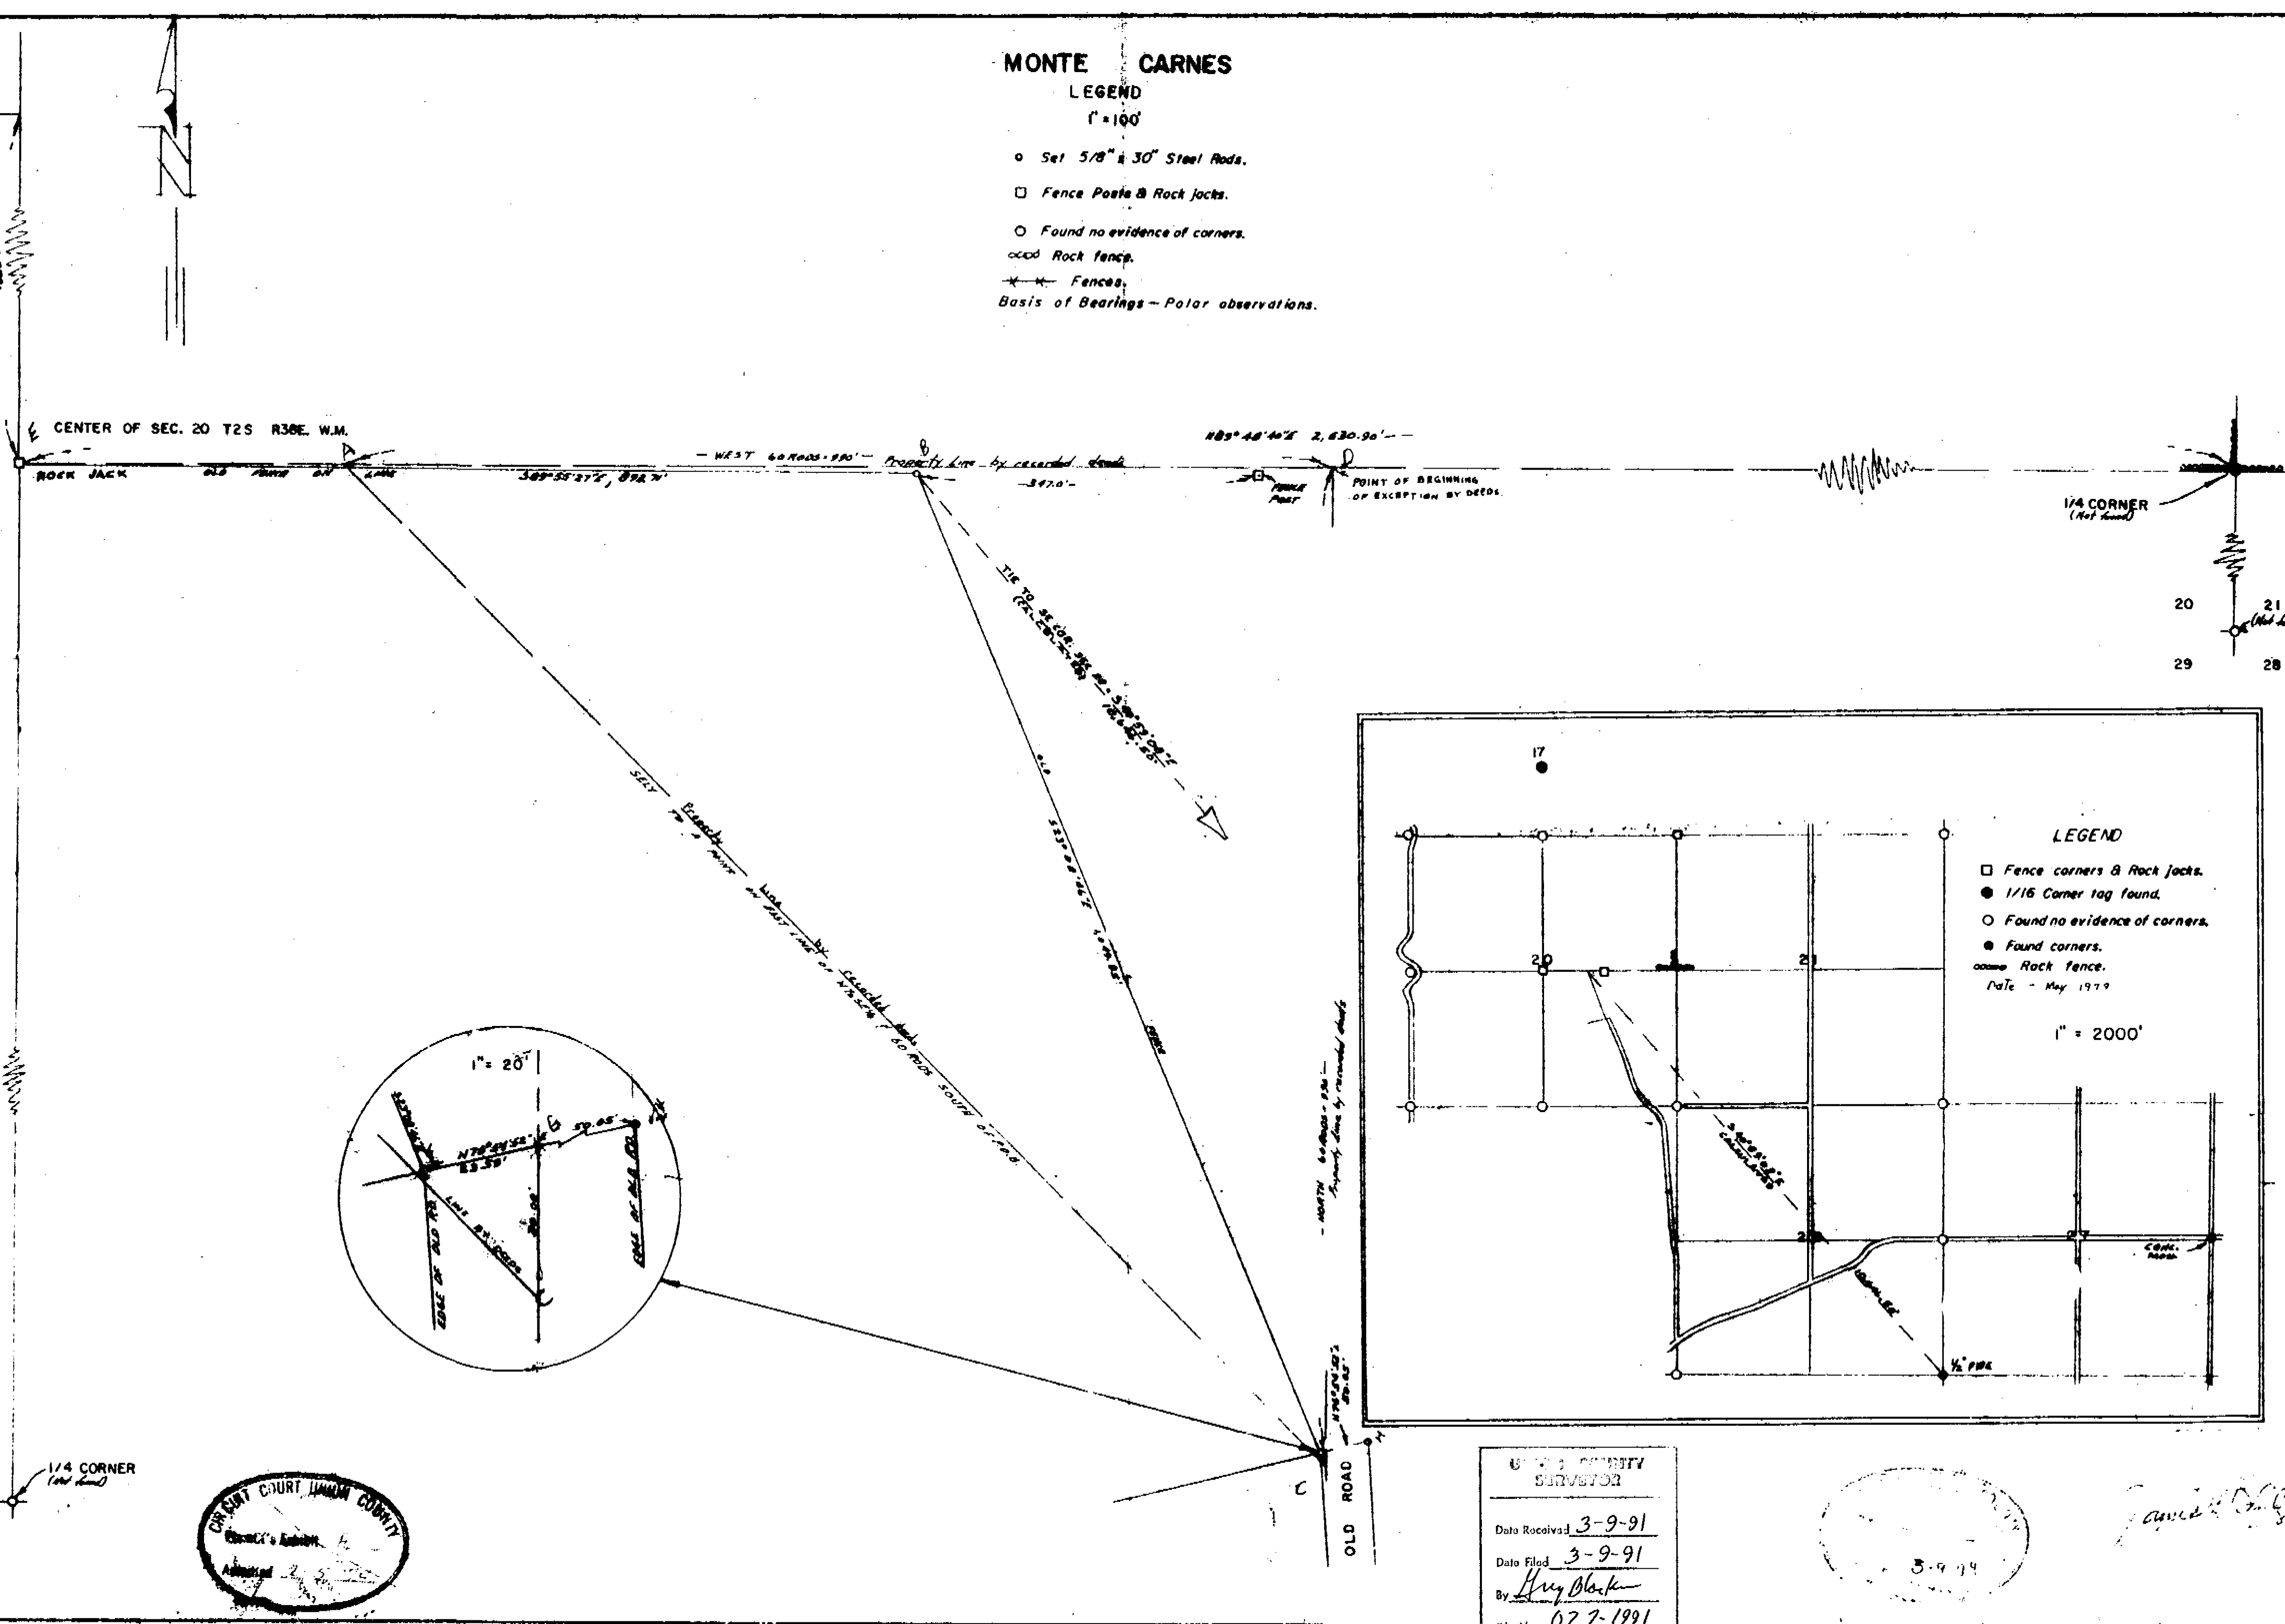

 Date Received 3-9-91  
 Date Filed 3-9-91  
 By *Greg Black*  
 File No. 027-1991

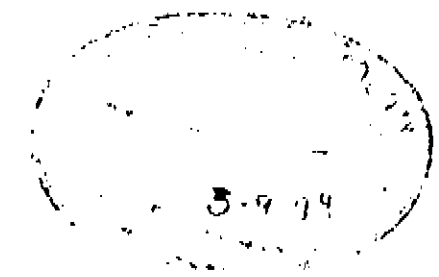

*James R. G...*

MAP of SURVEY 27-1991