

MAP SHOWING

JEFFERSON AVENUE

SURVEY AND FOUNDATION LOCATION ON
 LOTS 14, 15, & 16, BLOCK 11, "GRANDY'S
 SECOND ADDITION," TO LA GRANDE, UNION
 COUNTY, OREGON.

FOR: CENTRAL ORE. TAVERNS. INC.
 BEND, OREGON

BY: RICHARD W. BURTON
 BEND, OREGON

REGISTERED
 OREGON
 LAND SURVEYOR



Richard W. Burton

JULY 12, 1966
 RICHARD W. BURTON
 842



SCALE: 1" = 10'
 MAY 27, 1971

WALNUT STREET
 N 0° 22' 00" E

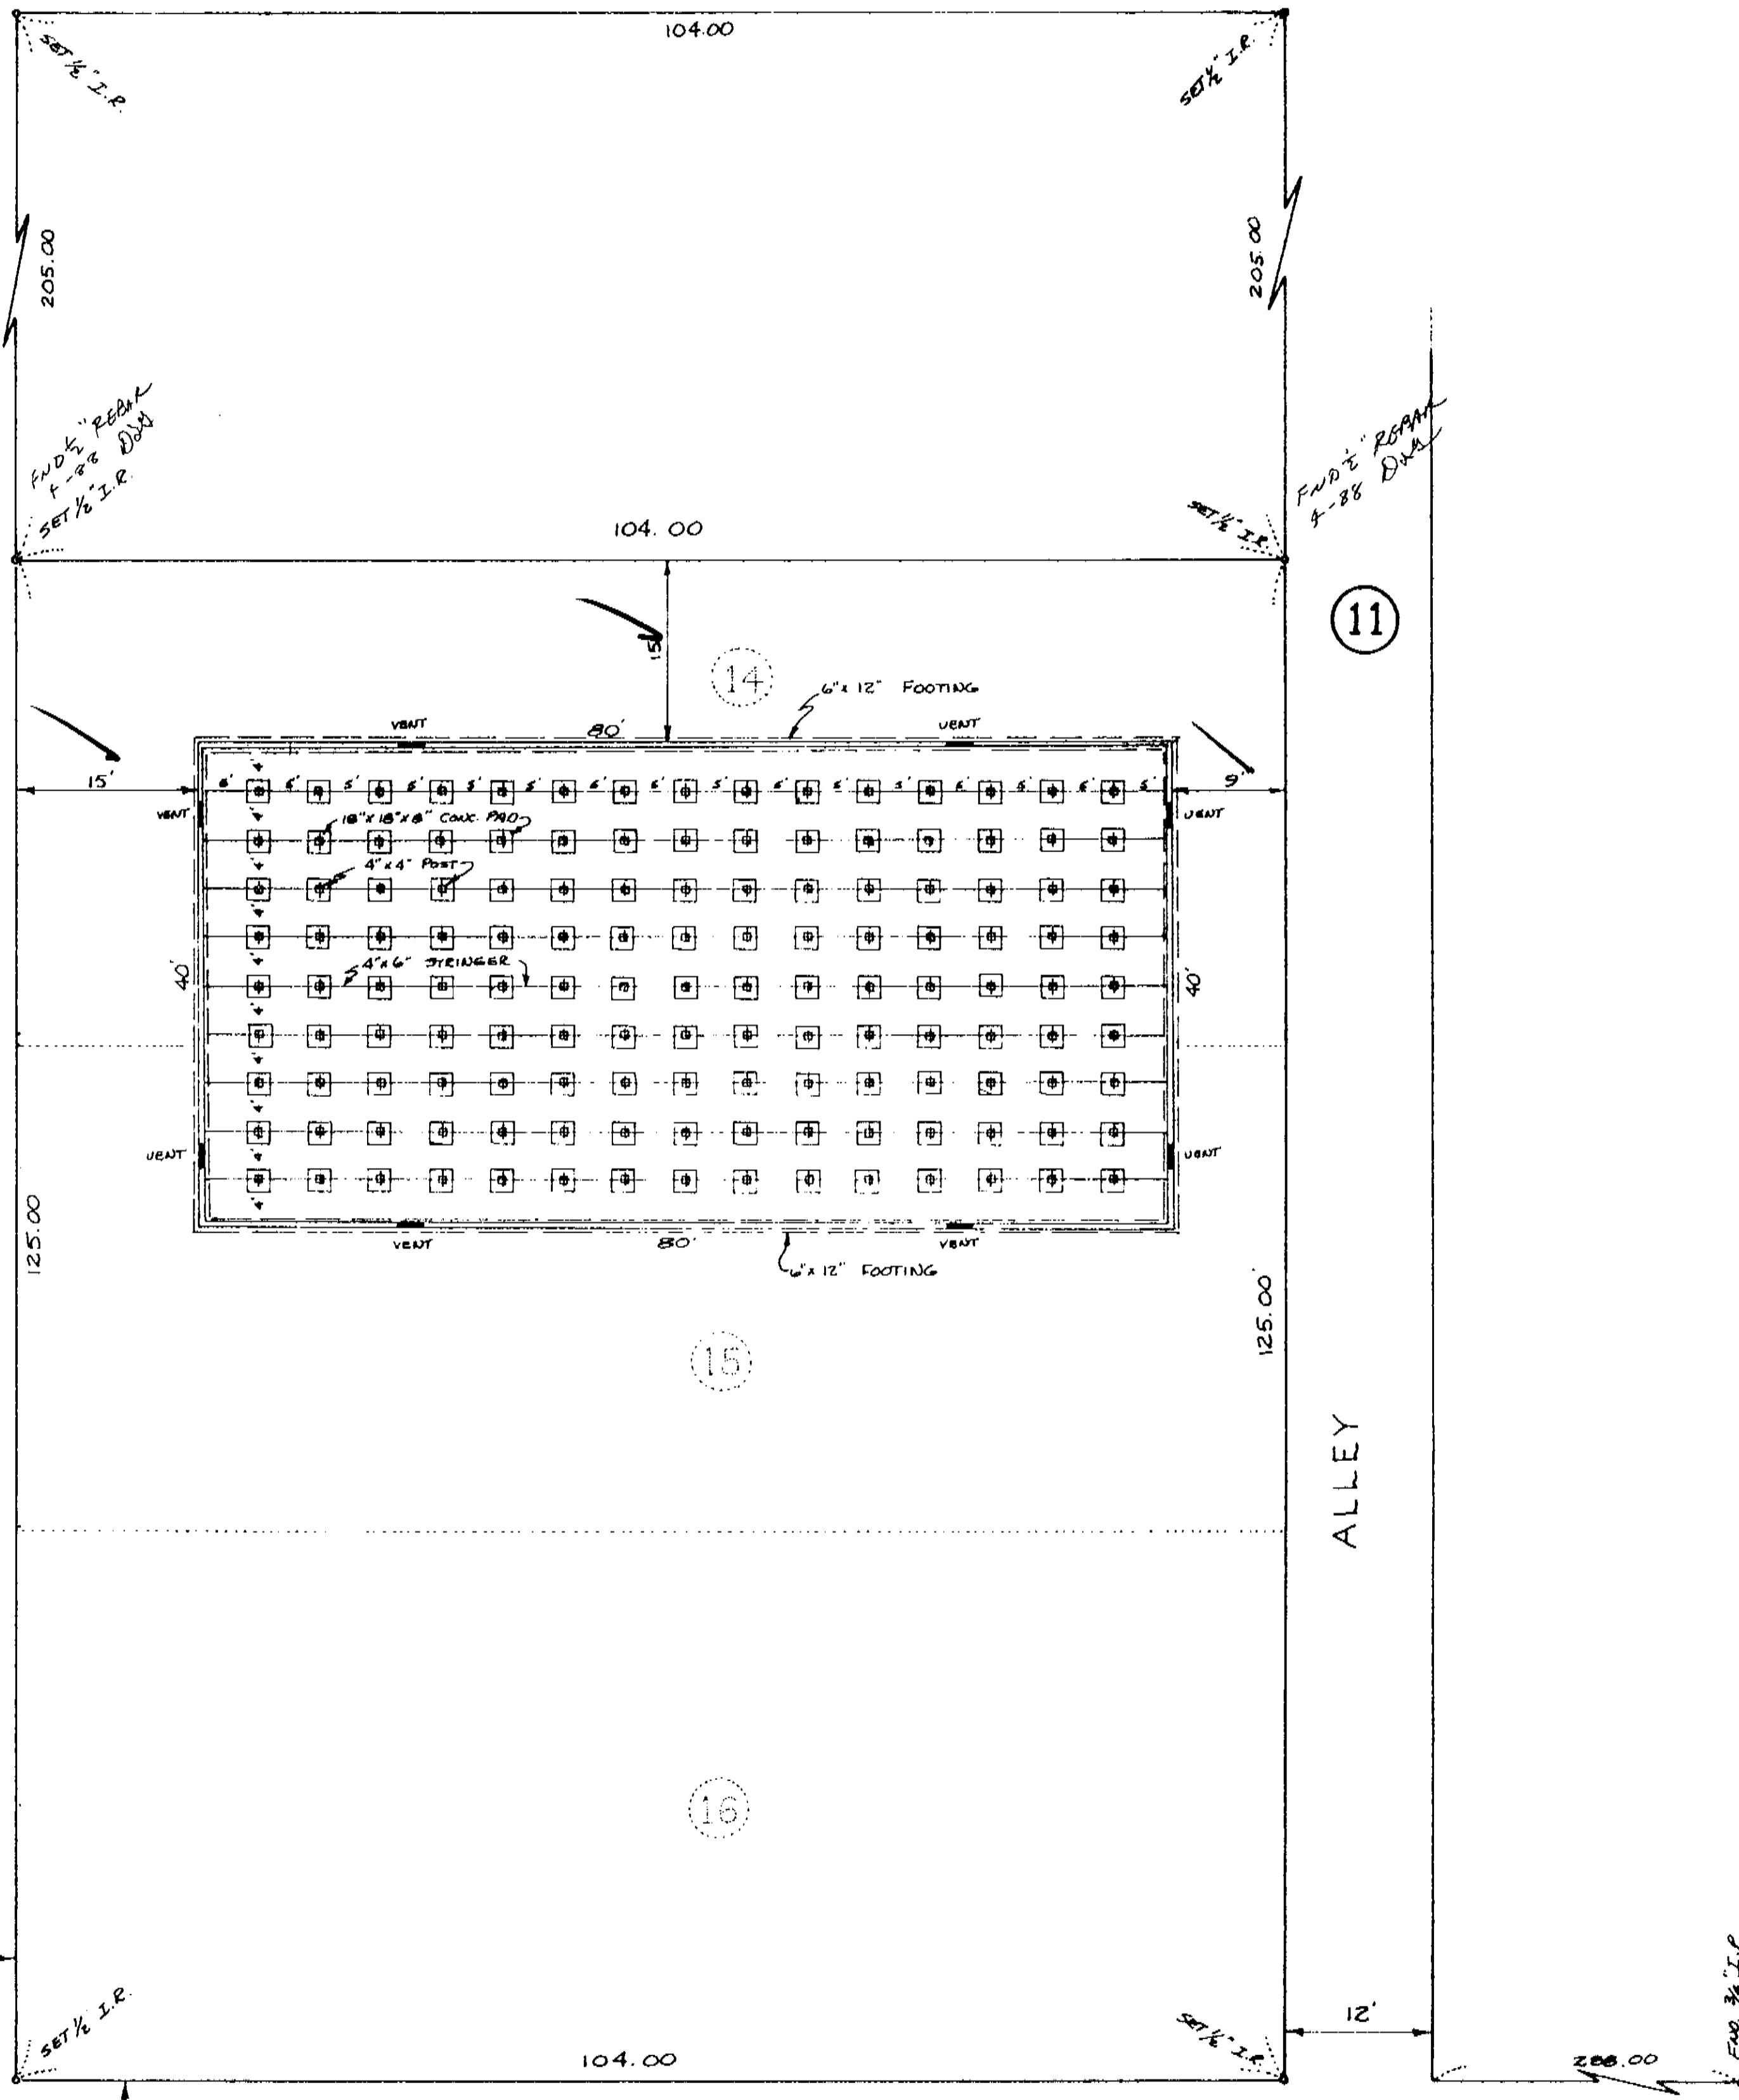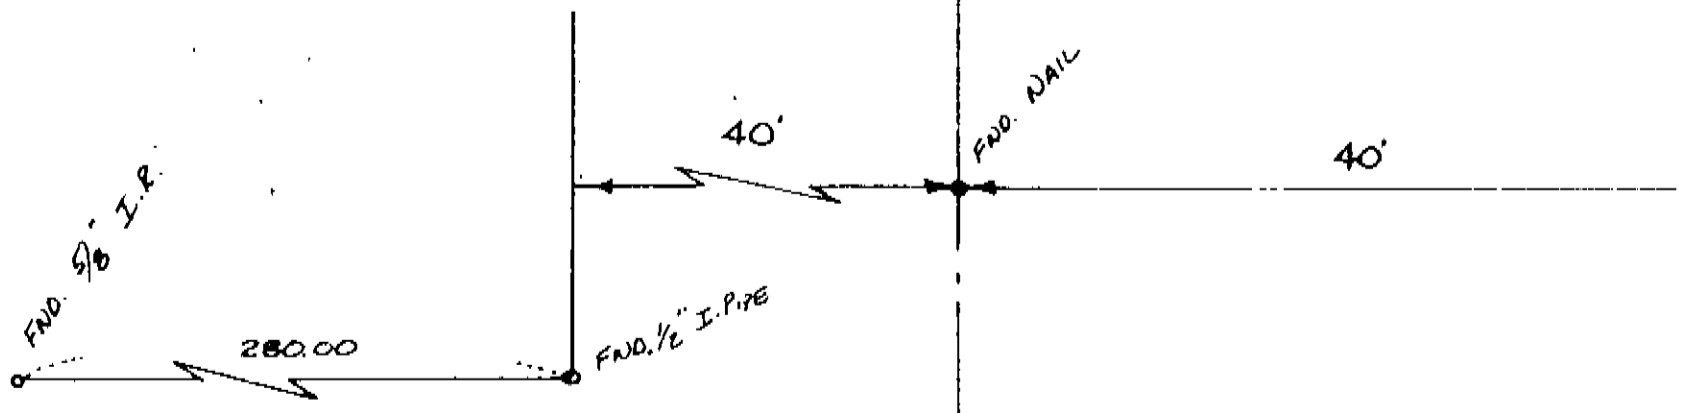

NOTE: THIS SURVEY & BASIS OF
 BEARINGS FOR IT IS FROM
 A PREVIOUS SURVEY BY
 DUANE I. GRIFFITH IN MARCH 1971

S 89° 42' 00" E
 ADAMS AVENUE

UNION COUNTY
 SURVEYOR
 Date Received: 3-9-91
 Date Filed: 3-9-91
 By: *Ray Black*
 File No. 030-1991

MAP OF SURVEY 30-1991