

NARRATIVE

This survey was performed for Farmers Home Administration for the purpose of identifying conservation easement boundaries on the Myron & Miles property and preparing legal description of these lands.

The survey consisted of locating and/or reestablishing the original land survey corner monuments for the 4 sections shown herein, subdividing these sections into their aliquot parts and monumenting the Miles property corners.

The easement boundaries had been previously marked by others using temporary stakes and flagging. These marks were monumented as shown, and survey traverse was completed around the perimeter.

An additional map of survey is filed describing in more detail the corner monuments found and the manner by which missing corner markers were reestablished.

Additional GLO corner data is attached herein as part of this narrative.

LEGEND

- Set 2 1/2" brass cap on 1/4" iron pipe w/ stone mound
- Set 3/8" x 30" rebar w/ plastic cap marked "HANLEY ENRG ALS 1206"
- ⊙ Found 3/4" iron pipe
- Existing fence line

T.6S., R.39E., W.M.


HANLEY ENGINEERING
2043 MAIN STREET
BAKER, OREGON

MAP OF SURVEY
LEGAL BOUNDARY SITE SURVEY
FOR CONSERVATION EASEMENT
T.6S., R.39E., W.M., SECTIONS 23, 24, 25, 26

REGISTERED PROFESSIONAL LAND SURVEYOR
James D. Hanley
OREGON
SEPTEMBER 23, 1971
JAMES D. HANLEY
1206

FARMERS HOME ADMINISTRATION
PURCHASE ORDER NO: 60-0496--9-CO101
MARCH-MAY, 1989

UNION COUNTY SURVEYOR
Data Received 12/18/91
Date Filed 12/20/91
By Bryan T. Black
File No. 066-1991

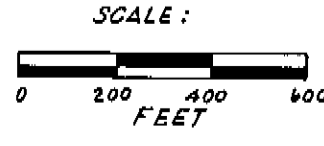

Survey Number 066 - 1991