


T 5 S R 41 E

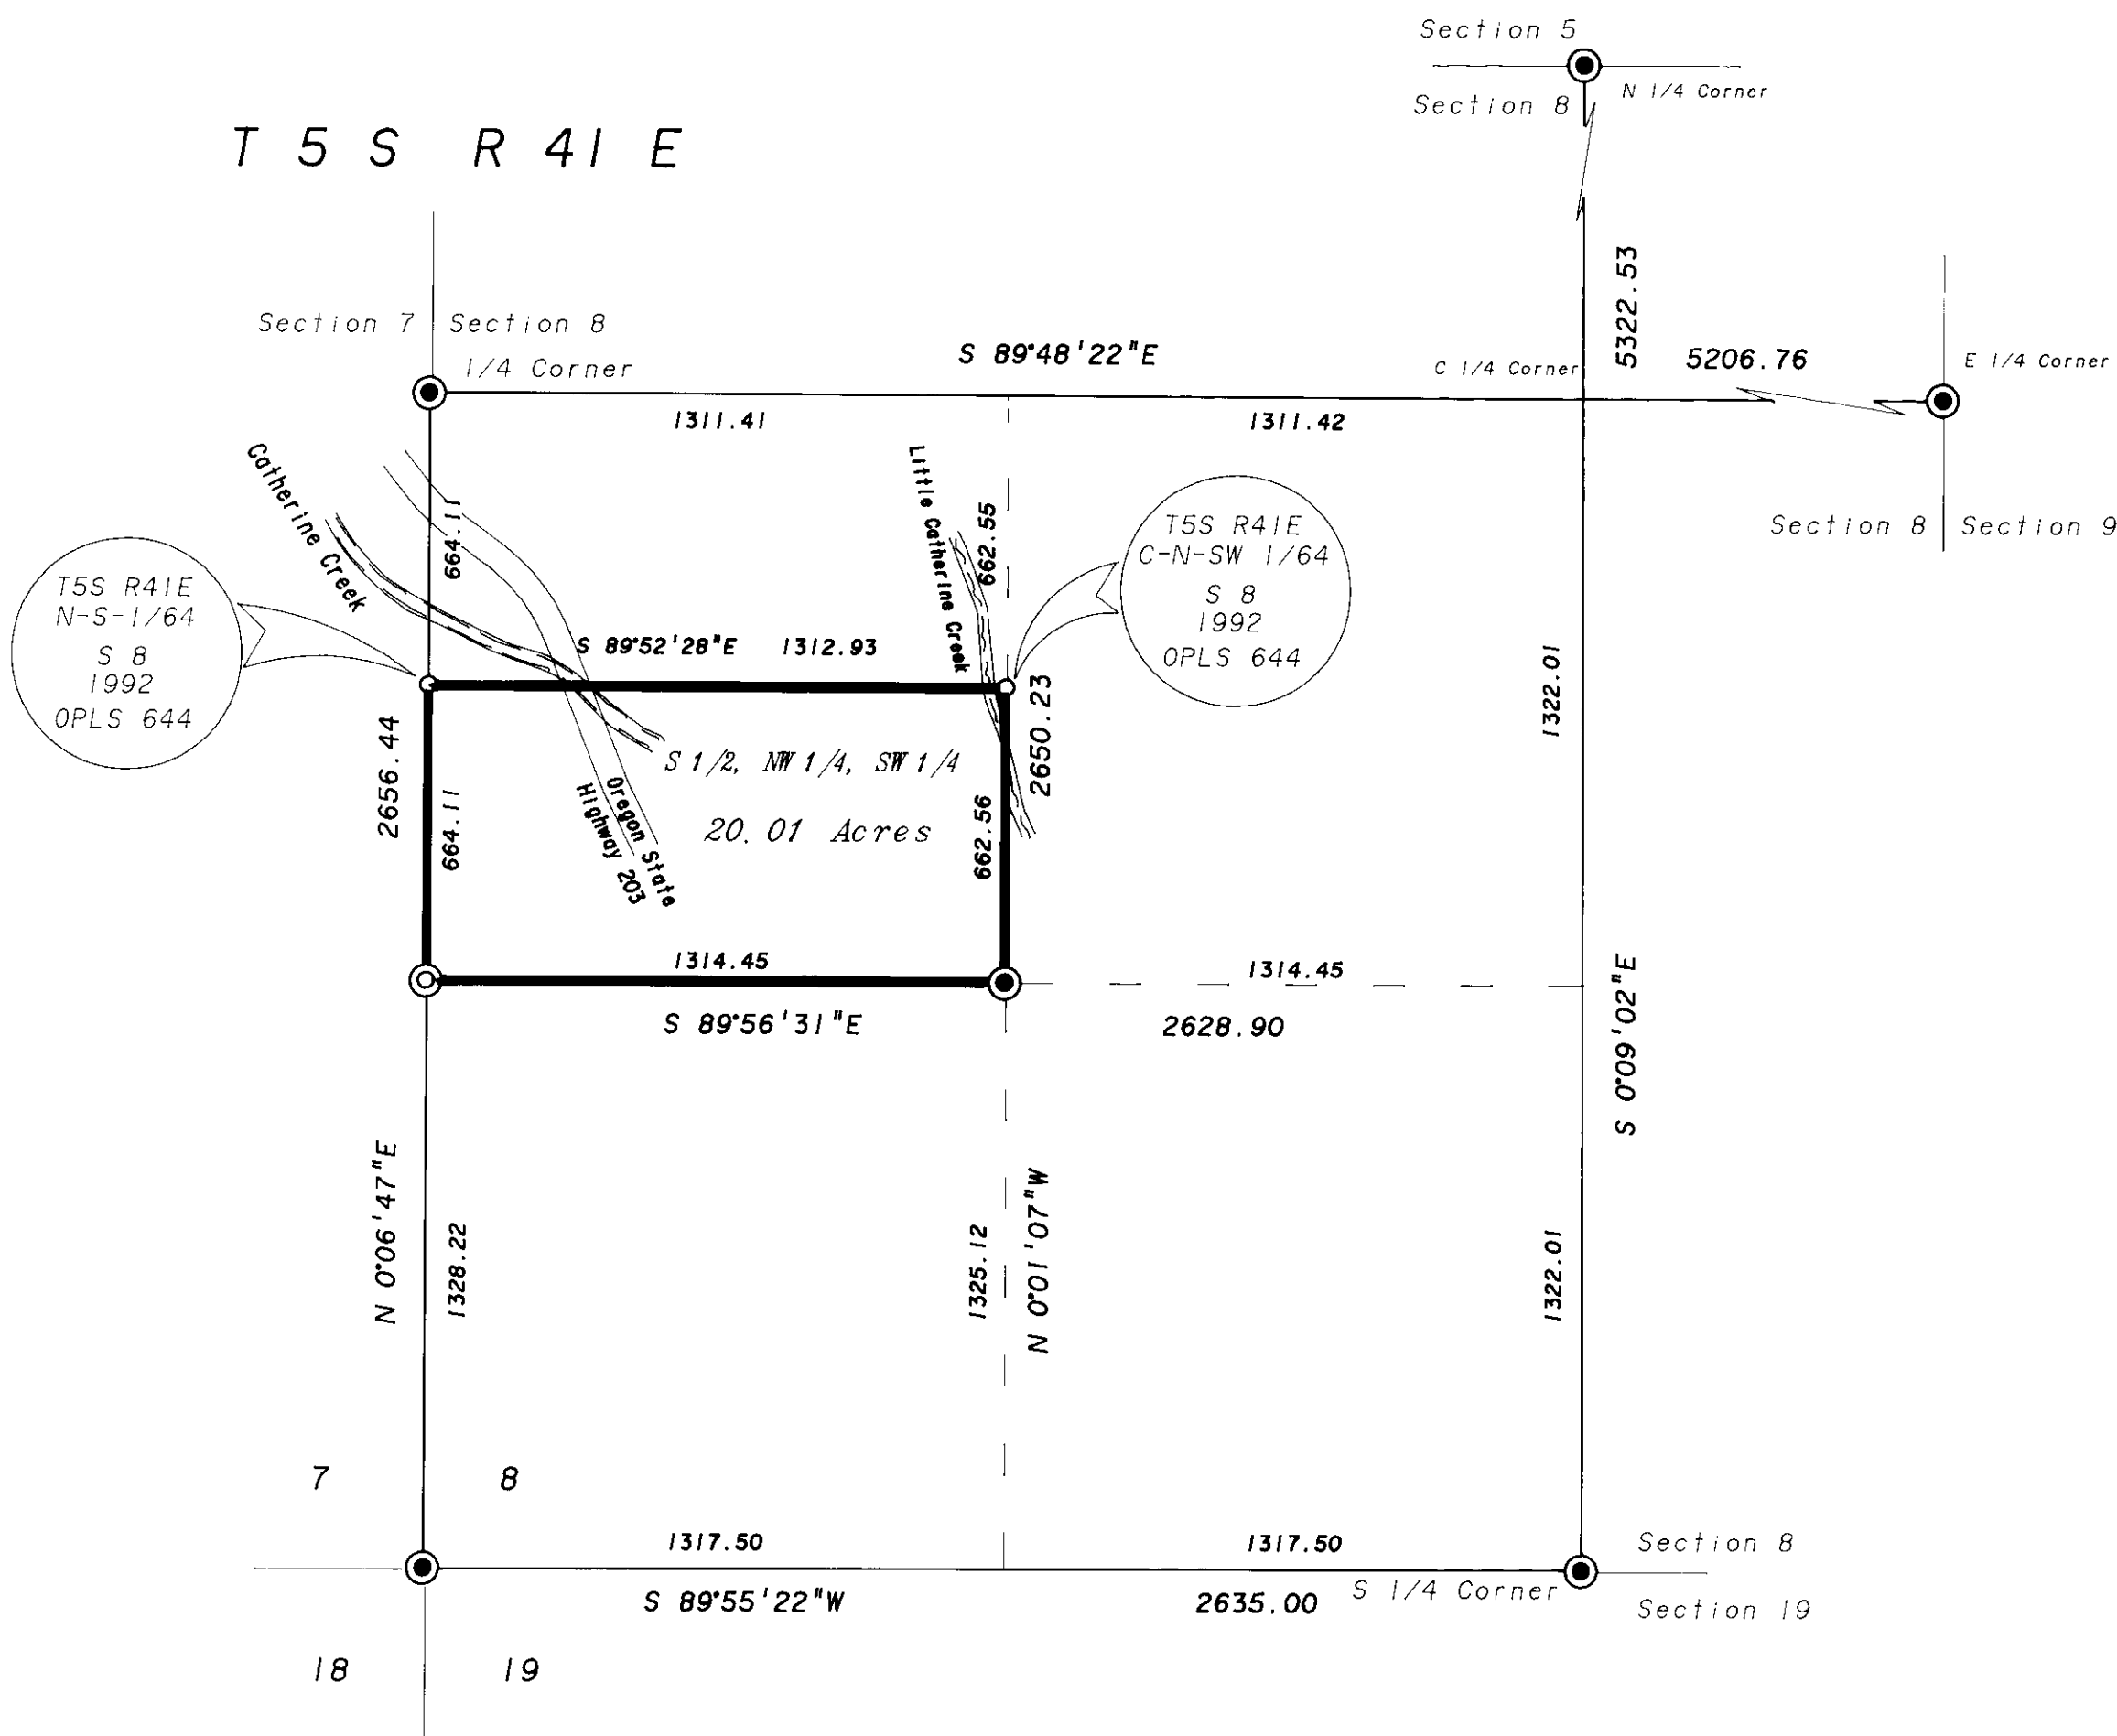

**BASIS OF BEARING**

Map of Survey Number 38-1992.  
Solar observations taken at a point 2100 feet,  
South and 750 feet East of the South 1/4 corner  
of Section 8. The hour angle method was used.

**NARRATIVE**

This survey was made at the request of Dale Perkins to locate the N 1/2 of the NW 1/4 of the SW 1/4 of Section 8, Township 5 South, Range 41 East of the Willamette Meridian. I based the survey on Map of Survey Number 038-1991 as filed in the Office of the Union County Surveyor. I made said survey in the spring of 1991 for Boise Cascade Corporation. I find no unusual conditions in this survey.

REGISTERED  
PROFESSIONAL  
LAND SURVEYOR  
*Duane J. Griffith*  
OREGON  
JULY 10, 1964  
DUANE J. GRIFFITH  
644

**REFERENCE MATERIAL**

Map of Survey Number 038-1991  
An agreement between Boise Cascade Corporation and Dale & Judy Perkins, copy of said document furnished by Dale Perkins.

**LEGEND**

- Found monument as recorded, Survey 038-1991.
- ⊙ Set 2-1/2" X 30" aluminum pipe with cap, see monumentation records filed separately.
- Set 5/8" X 30" rebar with 2" aluminum cap, marked as shown.


UNION COUNTY  
SURVEYOR  
6/17/92  
6/22/92  
*Judy Black*  
File No. 019-1992

BAGETT-GRIFFITH & ASSOCIATES  
LaGrande, Oregon  
Map of Survey  
To locate the S 1/2 of the  
NW 1/4 of the SW 1/4 of  
Section 8, T 5 S, R 41 E, WM  
UNION COUNTY, OREGON  
SURVEYED FOR Dale Perkins  
SURVEYED BY dig June 1992  
Scale: 1" = 400' Drawn by: Lucy June 1992

CERTIFIED RECORD OF LAND CORNER MONUMENTATION

History of original corner establishment:

NA

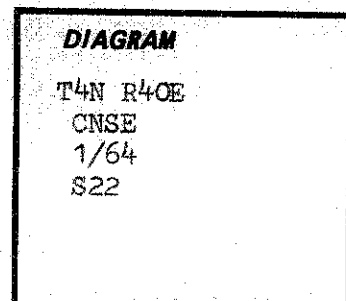

Description of corner evidence found:

NA

Description of monument and accessories established to perpetuate the original location of this corner:

Set 2 1/2" X 30" Alum. pipe and cap with a magnet  
Marked: 15" Larch N46 1/4 W 33.7' scribed CNSE 1/64 S22 BT  
12" Wh. Fir N24 1/2 E 45.4' " "

Stamped: T4N R4OE  
CNSE  
1/64  
S22  
1991  
LS 896

**UNION COUNTY SURVEYOR**  
Date Received 1-21-92  
Date Filed 1-22-92  
By [Signature]  
Narrative Drawer  
File No. 1/19

**REGISTERED PROFESSIONAL LAND SURVEYOR**

[Signature]

**OREGON**  
JULY 11, 1999  
**LARRY D. BISHOP**  
896


Office of..... County of.....  
State of....., I hereby certify that the within instrument was filed in this office  
for record on the..... day of....., 19.....

..... by .....  
(COUNTY OFFICIAL) (DEPUTY)

CERTIFIED RECORD OF LAND CORNER MONUMENTATION

History of original corner establishment:

NA

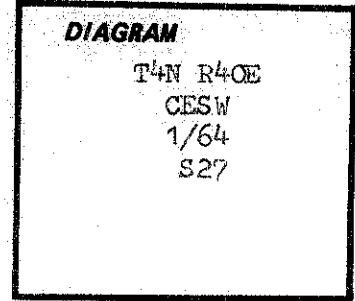

Description of corner evidence found:

NA

Description of monument and accessories | established to perpetuate the original location of this corner:

Set 2 1/2" X 30" Alum. pipe and cap with a magnet

Stamped:

T4N R4OE  
CESW  
1/64  
S27  
1991  
LS 896

Marked: 7" Spruce N80 1/2 E 8.8' scribed CESW1/16S27BT  
7" " S12E 27.0' " XBT

**UNION COUNTY SURVEYOR**


---

Date Received 1-21-92


Date Filed 1-22-92

By [Signature]  
Narrative Drawer

File No. 1/17

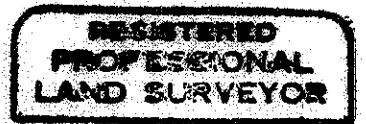

[Signature]

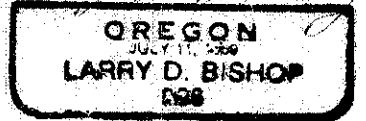


Office of..... County of.....  
State of....., I hereby certify that the within instrument was filed in this office  
for record on the..... day of....., 19....

..... by .....  
(COUNTY OFFICIAL) (DEPUTY)

CERTIFIED RECORD OF LAND CORNER MONUMENTATION

History of original corner establishment:

NA

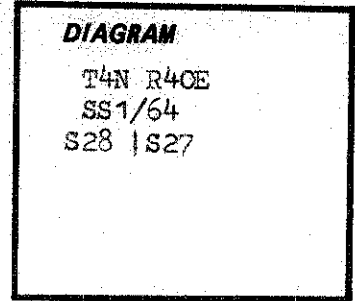

Description of corner evidence found:



NA

Description of monument and accessories I established to perpetuate the original location of this corner:

Set 2 1/2" X 30" Alum. pipe and cap with a magnet  
Marked: 10" Larch S47W 9.4' scribed SS1/64S28BT  
10" Larch S73E 4.0' scribed SS1/64S27BT

Stamped: T4N R4OE  
SS1/64  
S28 | S27  
1991  
LS 896

**UNION COUNTY SURVEYOR**  
Date Received 1-21-92  
Date Filed 1-22-92  
By [Signature]  
Narrative Drawer  
File No. 1/19

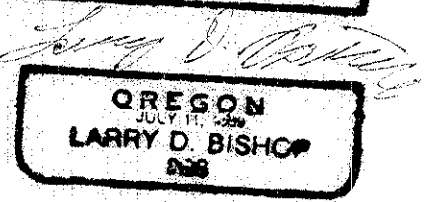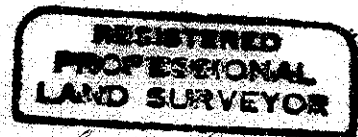


Office of..... County of.....  
State of..... I hereby certify that the within instrument was filed in this office  
for record on the..... day of....., 19.....

..... by .....  
(COUNTY OFFICIAL) (DEPUTY)

CERTIFIED RECORD OF LAND CORNER MONUMENTATION

History of original corner establishment:

NA

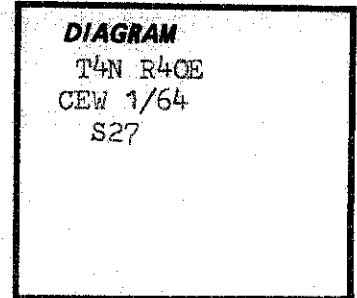

Description of corner evidence found:

NA

Description of monument and accessories I established to perpetuate the original location of this corner:



Set 2 1/2" X 30" Alum. pipe and cap with a magnet

Stamped:

T4N R4OE  
CEW 1/64  
S27  
1991  
LS 896

Marked: 22" Wh. Fir S77 1/2 E 24.4' scribed CEW1/64S27BT  
12" " " S10 1/4 E 42.7' " " "

UNION COUNTY SURVEYOR  
Date Received 1-21-92  
Date Filed 1-22-92  
By *Megan F. Blaw*  
Narrative Drawer  
File No. 1/19

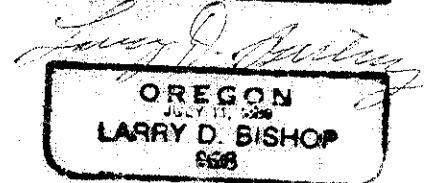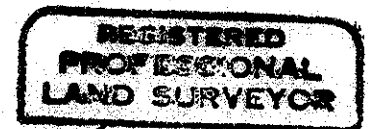

Office of..... County of.....  
State of....., I hereby certify that the within instrument was filed in this office  
for record on the..... day of....., 19.....

..... by .....


(COUNTY OFFICIAL)

(DEPUTY)

CERTIFIED RECORD OF LAND CORNER MONUMENTATION

History of original corner establishment:

NA

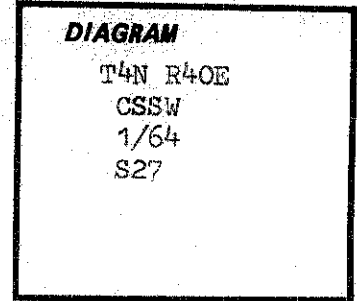

Description of corner evidence found:

NA

Description of monument and accessories | established to perpetuate the original location of this corner:

Set 2 1/2" X 30" Alum. pipe and cap with a magnet

Marked: 8" Spruce N85 1/2 E 25.8' scribed CSSW 1/64 S27 BT  
7" Wh. Fir S25E 6.9' " " "

Stamped: T4N R4OE  
CSSW  
1/64  
S27  
1991  
LS 896

**UNION COUNTY SURVEYOR**  
Date Received 1-21-92  
Date Filed 1-22-92  
By [Signature]  
Karlative Drawer  
File No. 1/19

**REGISTERED PROFESSIONAL LAND SURVEYOR**

*[Signature]*

**OREGON**  
JULY 11, 1959  
**LARRY D. BISHOP**  
808

Office of..... County of.....  
State of....., I hereby certify that the within instrument was filed in this office  
for record on the..... day of....., 19.....


..... by  
(COUNTY OFFICIAL)

(DEPUTY)

CERTIFIED RECORD OF LAND CORNER MONUMENTATION

History of original corner establishment:

NA

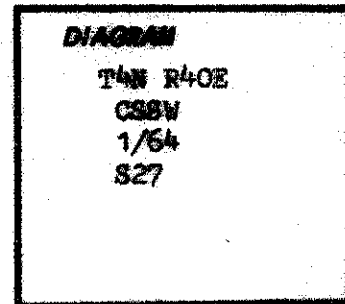

Description of corner evidence found:

NA

Description of monument and accessories | established to perpetuate the original location of this corner:

Set 2 1/2" X 30" Alum. pipe and cap with a magnet

Marked: 8" Spruce N85 1/2 E 25.8' scribed CSSW 1/64 S27 BT  
7" Wh. Fir S25 E 6.9' " " "

Stamped:

T4W R40E  
CSSW  
1/64  
S27  
1991  
LS 896

UNION COUNTY  
SURVEYOR


---

Date Received 1-21-92

Date Filed 1-23-92

By [Signature]  
Narrative Drawer

File No. 1/19

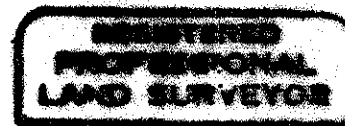

[Signature]  
LARRY D. BISHOP  
LS

Office of..... County of.....


State of....., I hereby certify that the within instrument was filed in this office for record on the..... day of....., 19.....

..... by .....  
(COUNTY OFFICIAL) (DEPUTY)

CERTIFIED RECORD OF LAND CORNER MONUMENTATION

History of original corner establishment:

NA

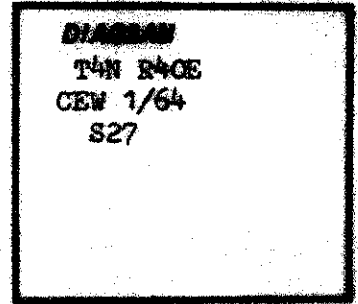

Description of corner evidence found:

NA

Description of monument and accessories I established to perpetuate the original location of this corner:

Set 2 1/2" X 30" Alum. pipe and cap with a magnet

Stamped:

TAN RACE  
CEW 1/64  
S27  
1991  
LS 896

Marked: 22" Wh. Fir S77°E 24.4' scribed CEW1/64S27BT  
12" " " S10°E 42.7' " "

**UNION COUNTY SURVEYOR**


---

Date Received 1-21-92

Date Filed 1-22-92

By Mary F. Blaw  
Narrative Drawer

File No. 1/19

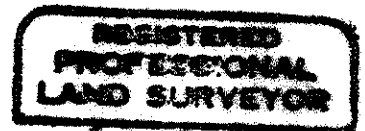

*Larry D. Bishop*  
**OREGON**  
JULY 11, 1989  
**LARRY D. BISHOP**  
698

Office of..... County of.....  
State of....., I hereby certify that the within instrument was filed in this office  
for record on the..... day of....., 19.....

(COUNTY OFFICIAL)


(DEPUTY)



CERTIFIED RECORD OF LAND CORNER MONUMENTATION

History of original corner establishment:

NA

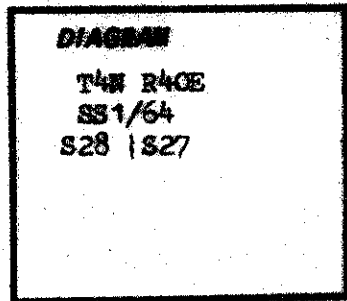

Description of corner evidence found:

NA

Description of monument and accessories | established to perpetuate the original location of this corner:

Set 2 1/2" X 30" Alum. pipe and cap with a magnet  
Marked: 10" Larch S47W 9.4' scribed SS1/64S28BT  
10" Larch S73E 4.0' scribed SS1/64S27BT

Stamped:

T4N R4GE  
SS1/64  
S28 | S27  
1991  
LS 886

UNION COUNTY  
SURVEYOR  
Date Received 1-21-92  
Date Filed 1-22-92  
By [Signature]  
Narrative Drawer  
File No. 1/19

REGISTERED  
PROFESSIONAL  
LAND SURVEYOR

[Signature]

OREGON  
JULY 11, 1985  
LARRY D. BISHOP  
208

Office of..... County of.....  
State of....., I hereby certify that the within instrument was filed in this office  
for record on the..... day of....., 19.....

(COUNTY OFFICIAL)


by

(DEPUTY)

CERTIFIED RECORD OF LAND CORNER MONUMENTATION

History of original corner establishment:

NA

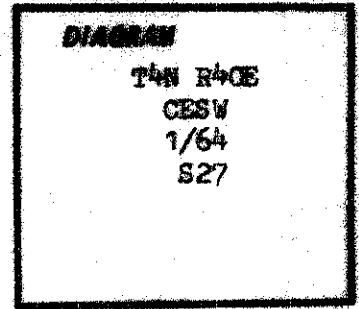

Description of corner evidence found:

NA

Description of monument and accessories established to perpetuate the original location of this corner:

Set 2 1/2" X 30' Alum. pipe and cap with a magnet

Marked: 7" Spruce N80 1/2 E 8.8' scribed CESW1/16S27BT  
7" " S12E 27.0' " XBT

Stamped:

T4N R4OE  
CESW  
1/64  
S27  
1991  
LS 896

UNION COUNTY SURVEYOR  
Date Received 1-21-92  
Date Filed 1-22-92  
By *[Signature]*  
Narrative Drawer  
File No. 1/17

REGISTERED PROFESSIONAL LAND SURVEYOR  
*[Signature]*  
OREGON  
JULY 11, 1988  
LARRY D. BISHOP  
R38

Office of..... County of.....  
State of....., I hereby certify that the within instrument was filed in this office  
for record on the..... day of....., 19.....

(COUNTY OFFICIAL)

(DEPUTY)

**CERTIFIED RECORD OF LAND CORNER MONUMENTATION**

History of original corner establishment:

NA

**DIAGRAM**  
T4N R4OE  
CNSE  
1/64  
S22

Description of corner evidence found:

NA

Description of monument and accessories | established to perpetuate the original location of this corner:

Set 2 1/2" X 30" Alum. pipe and cap with a magnet  
Marked: 15" Larch N46 1/4 W 33.7' scribed CNSE 1/64 S22 BT  
12" Wh. Fir N24 1/2 E 45.4' " "

Stamped: T4N R4OE  
CNSE  
1/64  
S22  
1991  
LS 896

**UNION COUNTY  
SURVEYOR**  
Date Received 1-21-92  
Date Filed 1-22-92  
By [Signature]  
Narrative Drawer  
File No. 1/19

**REGISTERED  
PROFESSIONAL  
LAND SURVEYOR**

[Signature]  
**OREGON  
JULY 11, 1929  
LARRY D. BISHOP  
898**

Office of..... County of.....  
State of....., I hereby certify that the within instrument was filed in this office  
for record on the..... day of....., 19.....

..... by .....  
(COUNTY OFFICIAL) (DEPUTY)