

**SURVEY NARRATIVE**

This survey was performed at the request of Mrs. Esther Badgley for the purpose of re-monumenting original G.L.O. corners controlling the location of Section 6, marking with steel fence posts the lines shown and monumenting certain corners of the parcel described in Union County Deed 133-194.

This three phase project initially began in 1986 with the re-monumentation of G.L.O. corners along the North line of Section 6. In 1988 G.L.O. corners along the West and South boundaries of Section 6 were re-monumented. In 1992 the East quarter corner of Section 6 was found and re-monumented, subdivision of the section was completed, interior property corners set and property lines marked with steel fence posts.

Original G.L.O. evidence was recovered for all eight of the corners controlling the location of Section 6. Also located were the East quarter corner and Southeast section corner of Section 1, T. 4 S., R. 37 E.; these junior corners do not affect the location of the range line and are shown for informational purposes only, not re-monumented for this survey.

Monumentation along Glass Hill Road, from Union County Survey No. 013-1991 was recovered as shown and is held as the westerly right of way line of said road.


This survey was performed according to standard survey practices and the current B.L.M. Manual of Surveying Instructions.

**LEGEND**

- Found 5/8" rebar with yellow plastic cap marked "BGA Survey marker" Union County Survey No. 013-1991
- Found original G.L.O. corner as described, not monumented this survey
- ⊙ Found 2 1/2" iron pipe with brass cap set by P.L.S. 381
- ⊙ Set 2 1/2" brass cap on 1 1/4" iron pipe May 7, 1992 unless otherwise noted
- //// Marked line with steel fence posts
- ( ) G.L.O. bearing/distance, Contract No. 388, dated May 7, 1881
- { } G.L.O. bearing/distance, Contract No. 452, dated June 16, 1882
- [ ] Bearing/distance, Union County Survey No. 013-1991

**MAP OF SURVEY**  
IN SECTION 6  
T. 4 S., R. 38 E., W.M.

SURVEYED MAY, 1992  
FOR MRS. ESTHER BADGLEY  
SCALE 1" = 500'

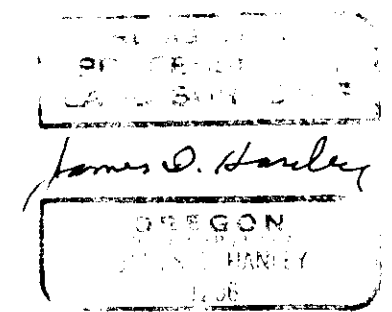

HANLEY ENGINEERING  
P.O. BOX 701  
2043 MAIN STREET  
BAKER CITY, OREGON

<b>UNION COUNTY SURVEYOR</b>	
Date Received	6/10/92
Date Filed	6/20/92
By	<i>Greg Black</i>
File No.	021-1992

BASIS OF BEARING  
ZZG  
Solar Observation taken at the N 1/4 corner Section 5 T. 4 S., R. 38 E.