RECORD OF SURVEY
FOR
FEDERAL HIGHWAY ADMINISTRATION

SITUATED IN THE N.W. 1/4 AND S.W. 1/4 OF SECTION 36
TOWNSHIP 3 SOUTH, RANGE 35 EAST OF THE WILLAMETTE MERIDIAN
UNION COUNTY, OREGON

SCALE: 1" = 100' OCTOBER 15, 1992

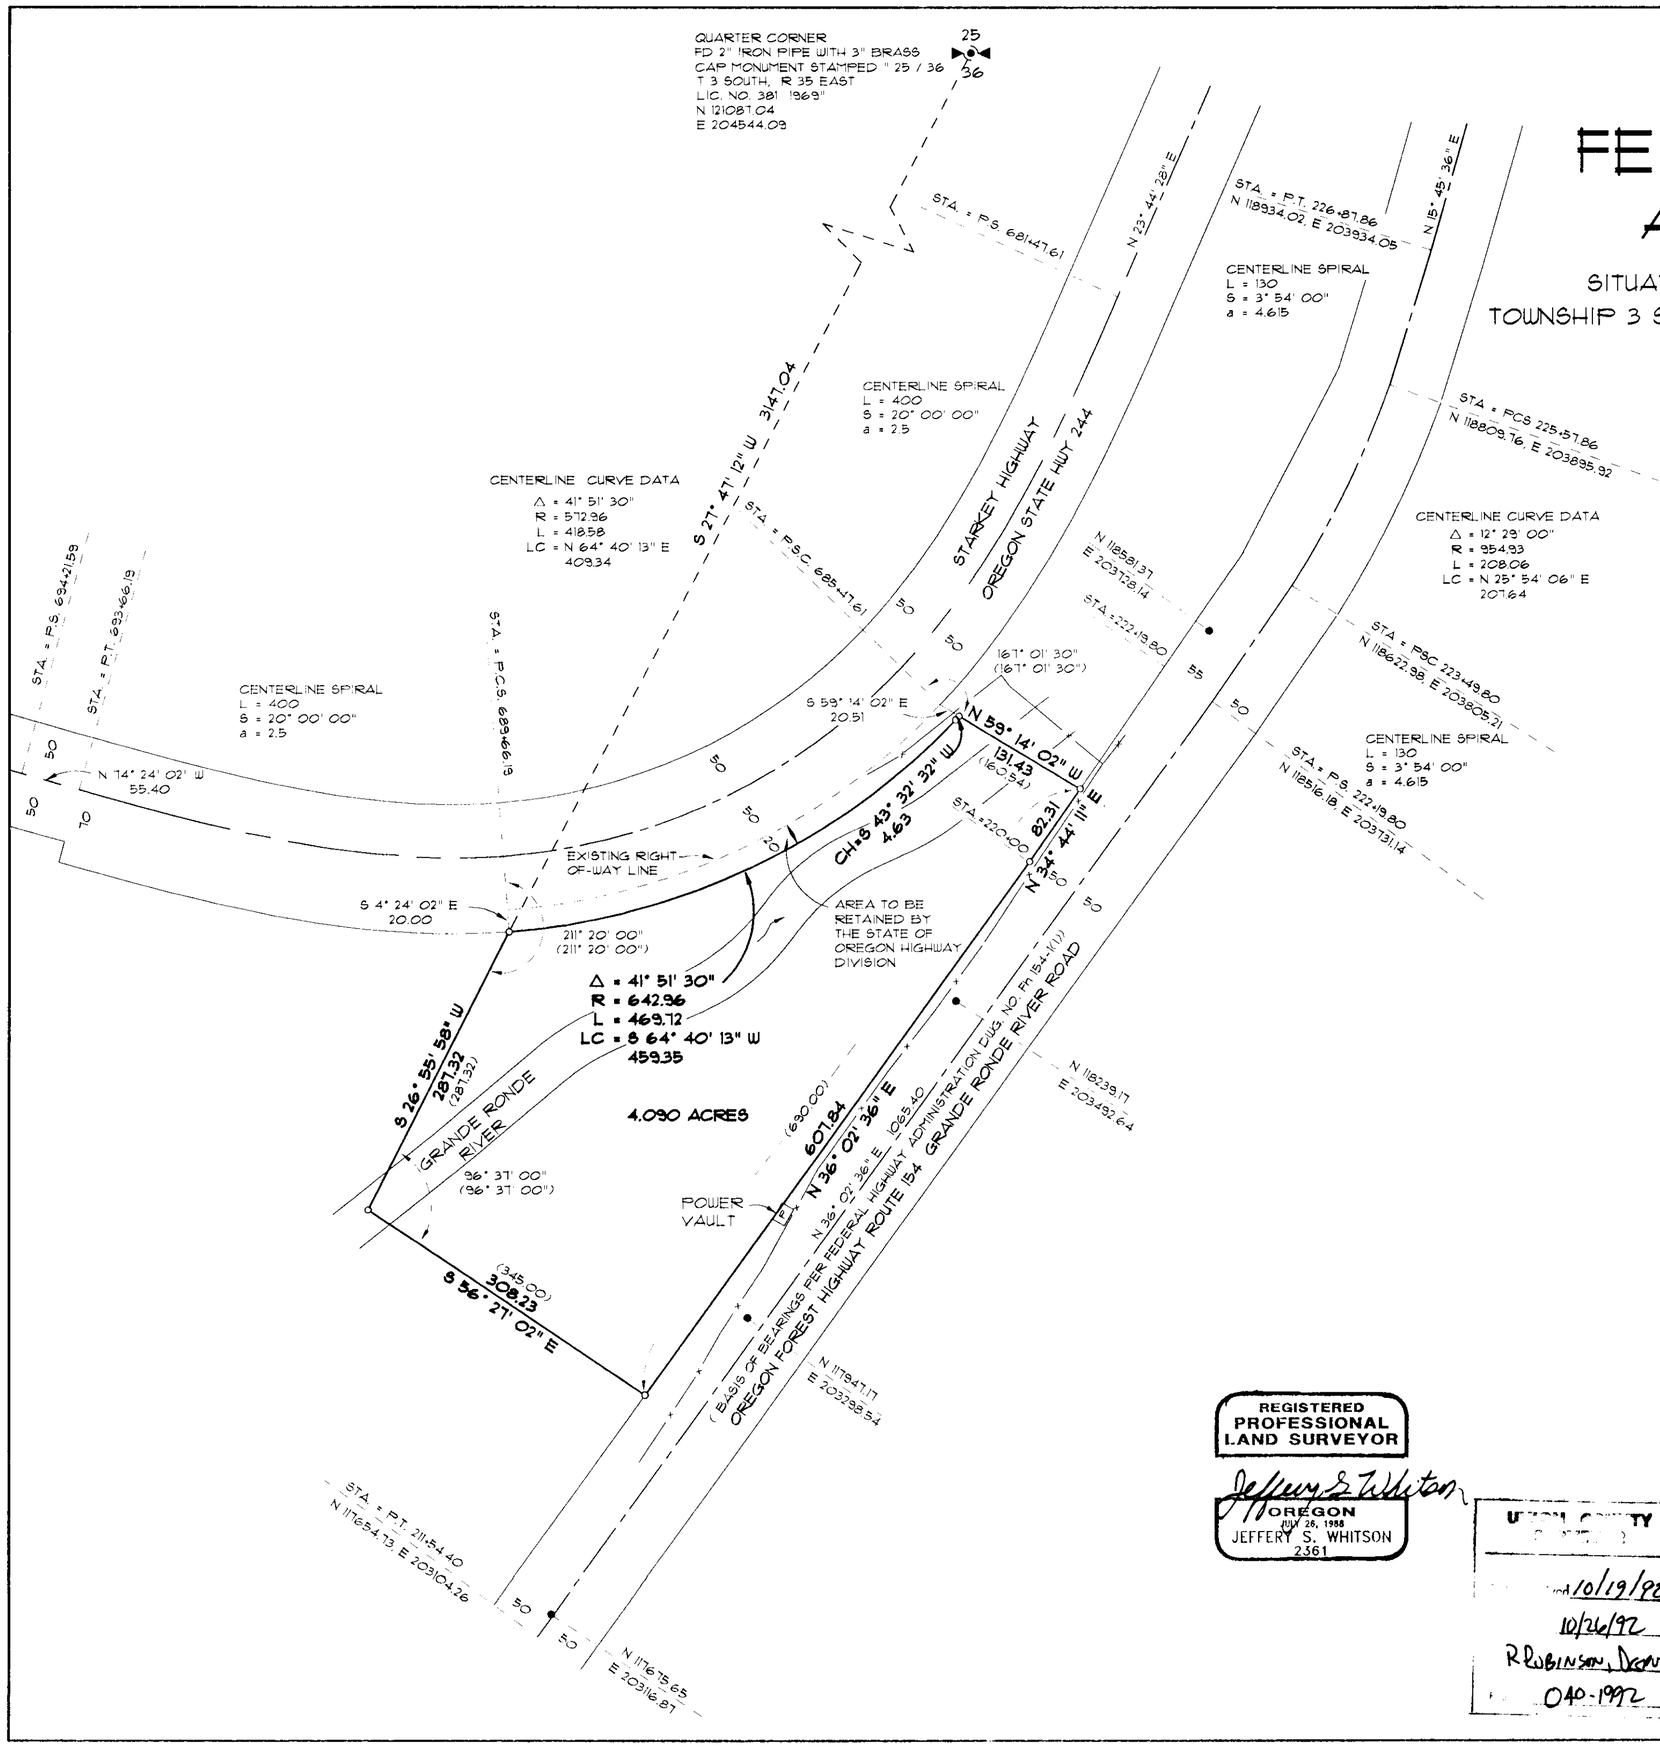

DAVID EVANS AND ASSOCIATES, INC.
2828 S.W. CORBETT AVENUE
PORTLAND, OREGON 97201
(503) 223-6663

NARRATIVE:

THE PURPOSE OF THIS SURVEY IS TO MONUMENT A TRACT OF LAND AS DESCRIBED IN DOCUMENT NO. 8852 IN BOOK 102, PAGE 495 UNION COUNTY DEED RECORDS. BEARINGS ARE BASED ON OREGON FOREST HIGHWAY ROUTE 154 PER THE P-LINE TRAVERSE ESTABLISHED BY FEDERAL HIGHWAY ADMINISTRATION. TO ESTABLISH THE CENTERLINE OF ROUTE 154 I HELD THE COORDINATE VALUES ON THE F.H.A. P-LINE WHICH RELATES TO THE NEW CENTERLINE PER F.H.A. DRAWING NO. FH 154-1(1). DUE TO THE LACK OF ANY EXISTING MONUMENTATION I ESTABLISHED THE CENTERLINE OF OREGON STATE HIGHWAY 244 BY LOCATING THE EXISTING TRAVELED CENTERLINE BETWEEN STATIONS 673+32 AND STATION 700+84 AND THEN BEST FIT THE RECORD CENTERLINE DATA PER O.S.H.D. DRAWING NO. 5B-32-10 TO THE EXISTING TRAVELED CENTERLINE. THE REMAINING SIDELINES OF THE TRACT BETWEEN THE HIGHWAYS WERE ESTABLISHED BY HOLDING RECORD DEED DISTANCES AND ANGLES AS SHOWN.

LEGEND:

- ● FOUND 1/2" IRON ROD WITH YELLOW PLASTIC CAP STAMPED "F.H.W.A. C.P." PER FEDERAL HIGHWAY ADMINISTRATION P-LINE TRAVERSE FOR OREGON FOREST HIGHWAY ROUTE 154.
- o SET 5/8" X 30" IRON ROD WITH YELLOW PLASTIC STAMPED "DEA INC."
- ( ) RECORD DATA PER DEED
- X 4 WIRE FENCE

REFERENCE TABLE:

(1) OREGON STATE HIGHWAY DEPARTMENT DRAWING NO. 5B-32-10 DATED APRIL 1941. (MEADOW BROOK SECTION STARKEY HIGHWAY).

(2) FEDERAL HIGHWAY ADMINISTRATION DRAWING NO. FH 154-1(1) DATED FEBRUARY 2, 1990 (OREGON FOREST HIGHWAY ROUTE 154 GRANDE RONDE RIVER ROAD).

(3) FEDERAL HIGHWAY ADMINISTRATION PRIMARY POINT COORDINATE LIST FOR P-LINE TRAVERSE FOR GRANDE RONDE RIVER ROAD DATED SEPTEMBER 8, 1981

(4) DEED TRANSFERING TITLE FROM JOSEPH AND ORTANCE C. CUNHA TO THE STATE OF OREGON RECORDED JULY 10, 1941 AS DOCUMENT NO. 8852 IN BOOK 102, PAGE 495 UNION COUNTY DEED RECORDS.

REGISTERED PROFESSIONAL LAND SURVEYOR
OREGON
JULY 26, 1988
JEFFERY S. WHITSON
2361

UNION COUNTY
Filed 10/19/92
10/26/92
R Robinson, Deputy
040-1992

040-1992