

T-1-S R-39-E WM

S-89°45' W

20 21

Dick Hibberd

2" pipe offset 21' from E road

center 1320' 424' 544' 228' center  
sec 20 Co. Road sec 21

1/4 cor found

53' 42"

5.12 Ac

3.42 Ac

105'

102'

105'

647A

2.71'

2" pipes


J.L. Westenskow

I certify this map was made from field survey on Sept 8 & 9, 1956 and location of cor. are as shown.

LB. Billings

Clayton C. Wilson

R.H. & NE Sawyer

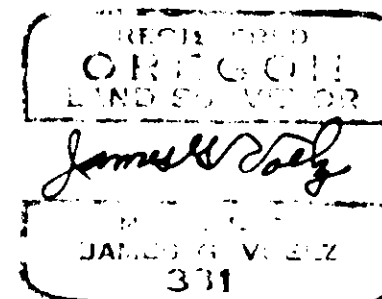

Scale 1"=500'

20 21

S-89°30' W

2/25/93

2/25/93

R. ROBINSON, DEPUTY

009-1993

Survey No. 009-1993