


Map drawing made for City pertaining to clear Rock Pit on Fox Hill.

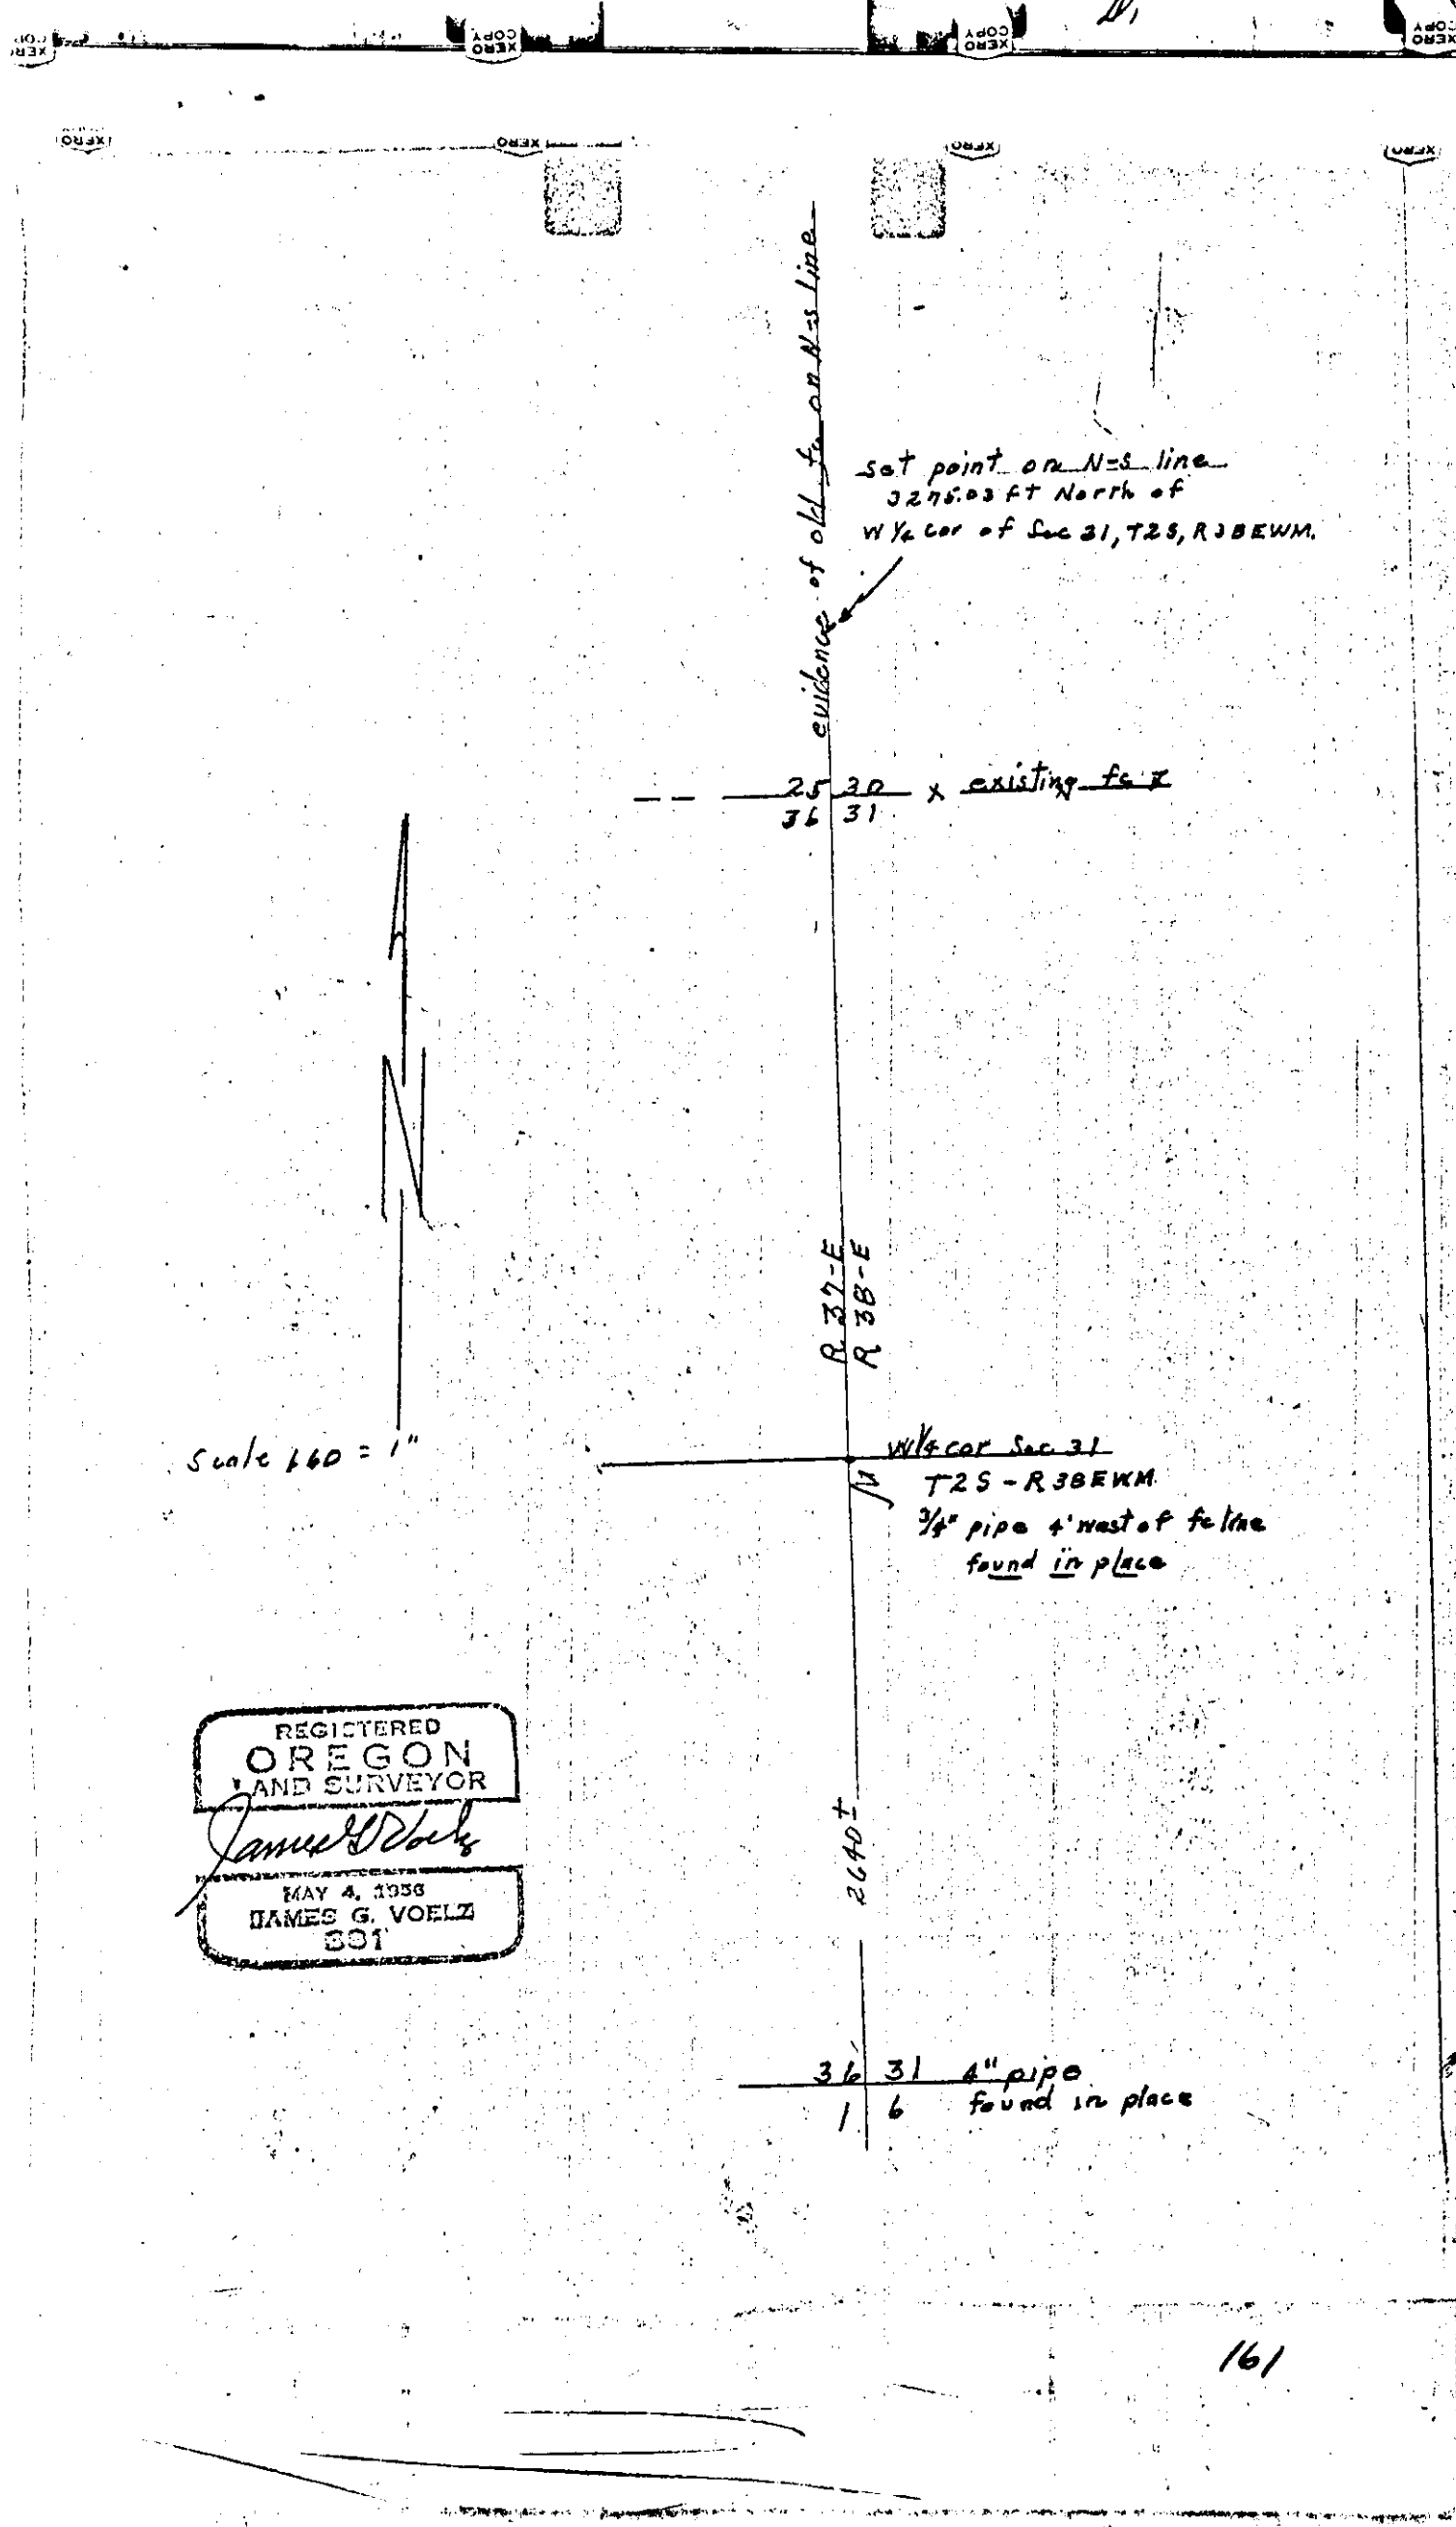

REGISTERED
 OREGON
 LAND SURVEYOR
James G. Voelz
 MAY 4, 1956
 JAMES G. VOELZ
 301

161

Date Entered 2/25/93
 Date Plotted 2/25/93
 R. ROBINSON, DEPUTY
 010-1993