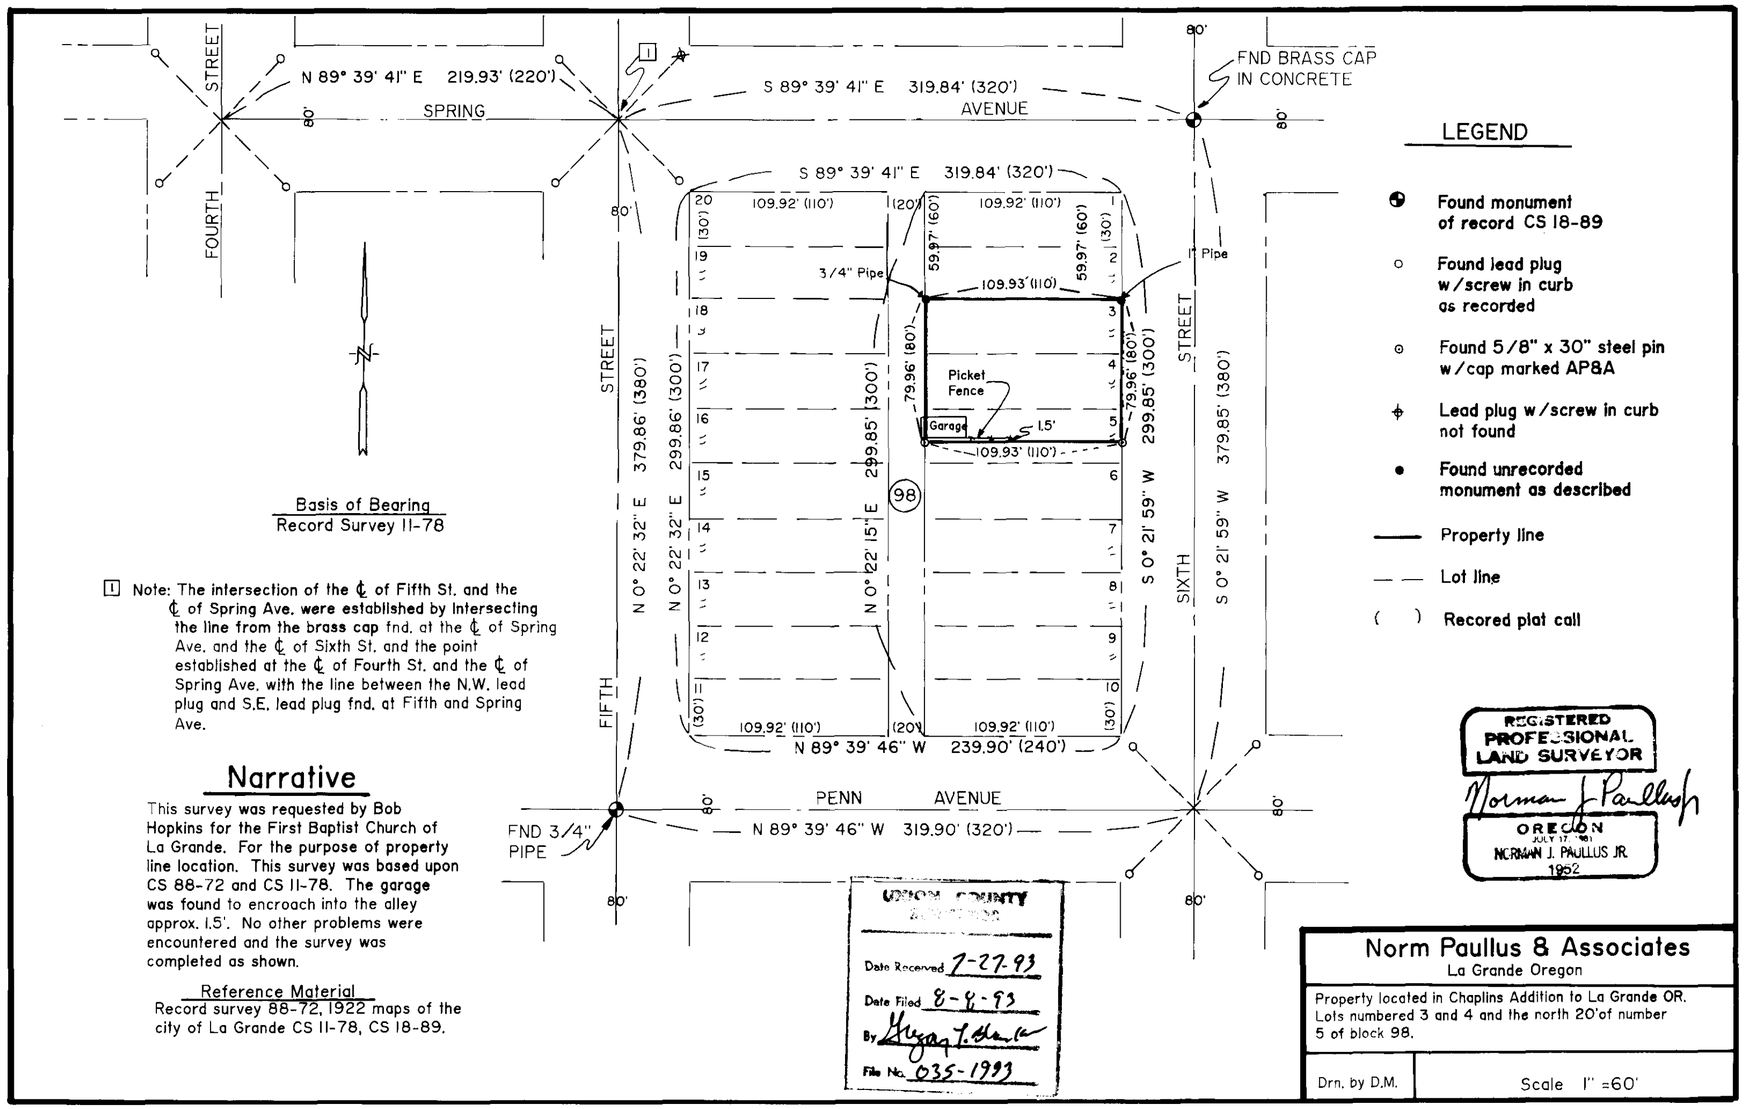

Narrative

This survey was requested by Bob Hopkins for the First Baptist Church of La Grande. For the purpose of property line location. This survey was based upon CS 88-72 and CS 11-78. The garage was found to encroach into the alley approx. 1.5'. No other problems were encountered and the survey was completed as shown.

Reference Material

Record survey 88-72, 1922 maps of the city of La Grande CS 11-78, CS 18-89.

Norm Paullus & Associates
La Grande Oregon

Property located in Chaplins Addition to La Grande OR. Lots numbered 3 and 4 and the north 20'of number 5 of block 98.

Drn. by D.M. | Scale 1" =60'

Survey Number 035-1993