


GRAVEL FLAT CADASTRAL SURVEY WALLOWA-WHITMAN NATIONAL FOREST

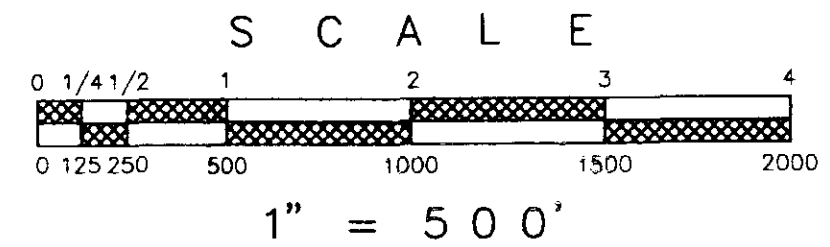

LEGEND

- FOUND G-L-O EVIDENCE, SET A 3" DIAM. U.S.F.S. ALUMINUM CAPPED PIPE, 30" LONG, WITH MAGNET, MARKED PER B-L-M MANUAL, SEE TYPICAL CAP FOR STANDARD MARKINGS
- FOUND MS 938 EVIDENCE, SET A 3" DIAM. U.S.F.S. ALUMINUM CAPPED PIPE, 30" LONG, WITH MAGNET, MARKED PER B-L-M MANUAL, SEE TYPICAL CAP FOR STANDARD MARKINGS
- FOUND 2" DIAM. IRON PIPE WITH BRASS CAP - PLS 1206
- ⊙ SET A 3" DIAM. U.S.F.S. ALUMINUM CAPPED PIPE, 30" LONG, WITH MAGNET, MARKED PER B-L-M MANUAL, SEE TYPICAL CAP FOR STANDARD MARKINGS
- [] RECORD BEARING AND/OR DISTANCE, G-L-O, 1880
- () RECORD BEARING AND/OR DISTANCE, MS 938, 1955
- N.F.S.L. = NATIONAL FOREST SYSTEM LANDS BOUNDARY LINE POSTED TO STANDARD

SURVEY NARRATIVE

BASIS OF BEARING WAS A SOLAR OBSERVATION TAKEN ON 04/03/1992 AT A POINT 6030 FEET NORTH AND 1798 FEET WEST OF THE NE CORNER OF SECTION 21. THE MAGNETIC DECLINATION FOR THIS SURVEY IS 18 1/2' EAST AS DETERMINED FROM A U.S.G.S. TOPO MAP FOR THIS PROJECT AREA.

THIS SURVEY REPRESENTS A RECORD OF THE PARTIAL RETRACEMENT AND/OR SUBDIVISION OF SECTIONS 20 & 21, T 6 S, R 42 E, W.M., BAKER COUNTY, OREGON.

THIS SURVEY WAS PERFORMED AT THE REQUEST OF THE FOREST SUPERVISOR, WALLOWA-WHITMAN NATIONAL FOREST, BAKER CITY, OREGON.

THE PURPOSE OF THIS SURVEY WAS TO DETERMINE THE BOUNDARY LINES BETWEEN THE PRIVATE AND PUBLIC LAND ADMINISTERED BY THE U.S. FOREST SERVICE IN SECTION 20 & 21 AND TO POST TO STANDARD THOSE BOUNDARIES.

THE PROCEDURES USED IN THIS SURVEY WERE IN ACCORDANCE WITH THE CONTRACT SPECIFICATIONS, THE 1973 B-L-M MANUAL AND STATE LAW, RESULTING IN AN ERROR OF CLOSURE OF 1 AND 5000 OR BETTER.

THE EQUIPMENT USED ON THIS SURVEY IS KEPT ADJUSTED AND STANDARDIZED. WE USED A SOKKIA SET 2,3 OR 4 TOTAL STATION AND LEAP FROGGED A COMPLETE SET UP AT EACH TRAVERSE STATION OR CONTROLLING CORNER.

LOST OR OBLITERATED CORNERS WERE REESTABLISHED IN ACCORDANCE WITH THE B-L-M MANUAL, A COMPLETE DESCRIPTION OF THE CORNERS FOUND, SET OR REESTABLISHED CAN BE FOUND ON PAGE 4 & 5 OF THIS RECORD OF SURVEY. THE FIELD NOTES FOR THIS SURVEY ARE CONTAINED IN BOOK 1, PAGES 1 - 118 TITLED: GRAVEL FLAT CADASTRAL SURVEY.


SURVEYORS CERTIFICATE

THIS PLAT CORRECTLY REPRESENTS A SURVEY MADE BY ME OR UNDER MY DIRECTION IN CONFORMANCE WITH THE STATUTES OF OREGON AND AT THE REQUEST OF THE FOREST SUPERVISOR, WALLOWA-WHITMAN NATIONAL FOREST, DURING THE MONTH OF APRIL, 1992.

PROFESSIONAL
AND SURVEYOR
Ronald E. Stoll
LE. 1988, 1988
RONALD E. STOLL
2038

JOB NO. 1210-691-OR
CONTRACT NO. 53-04M3-1-0113
SHEET 1 OF 5


RONALD E. STOLL, R.L.S. 2058

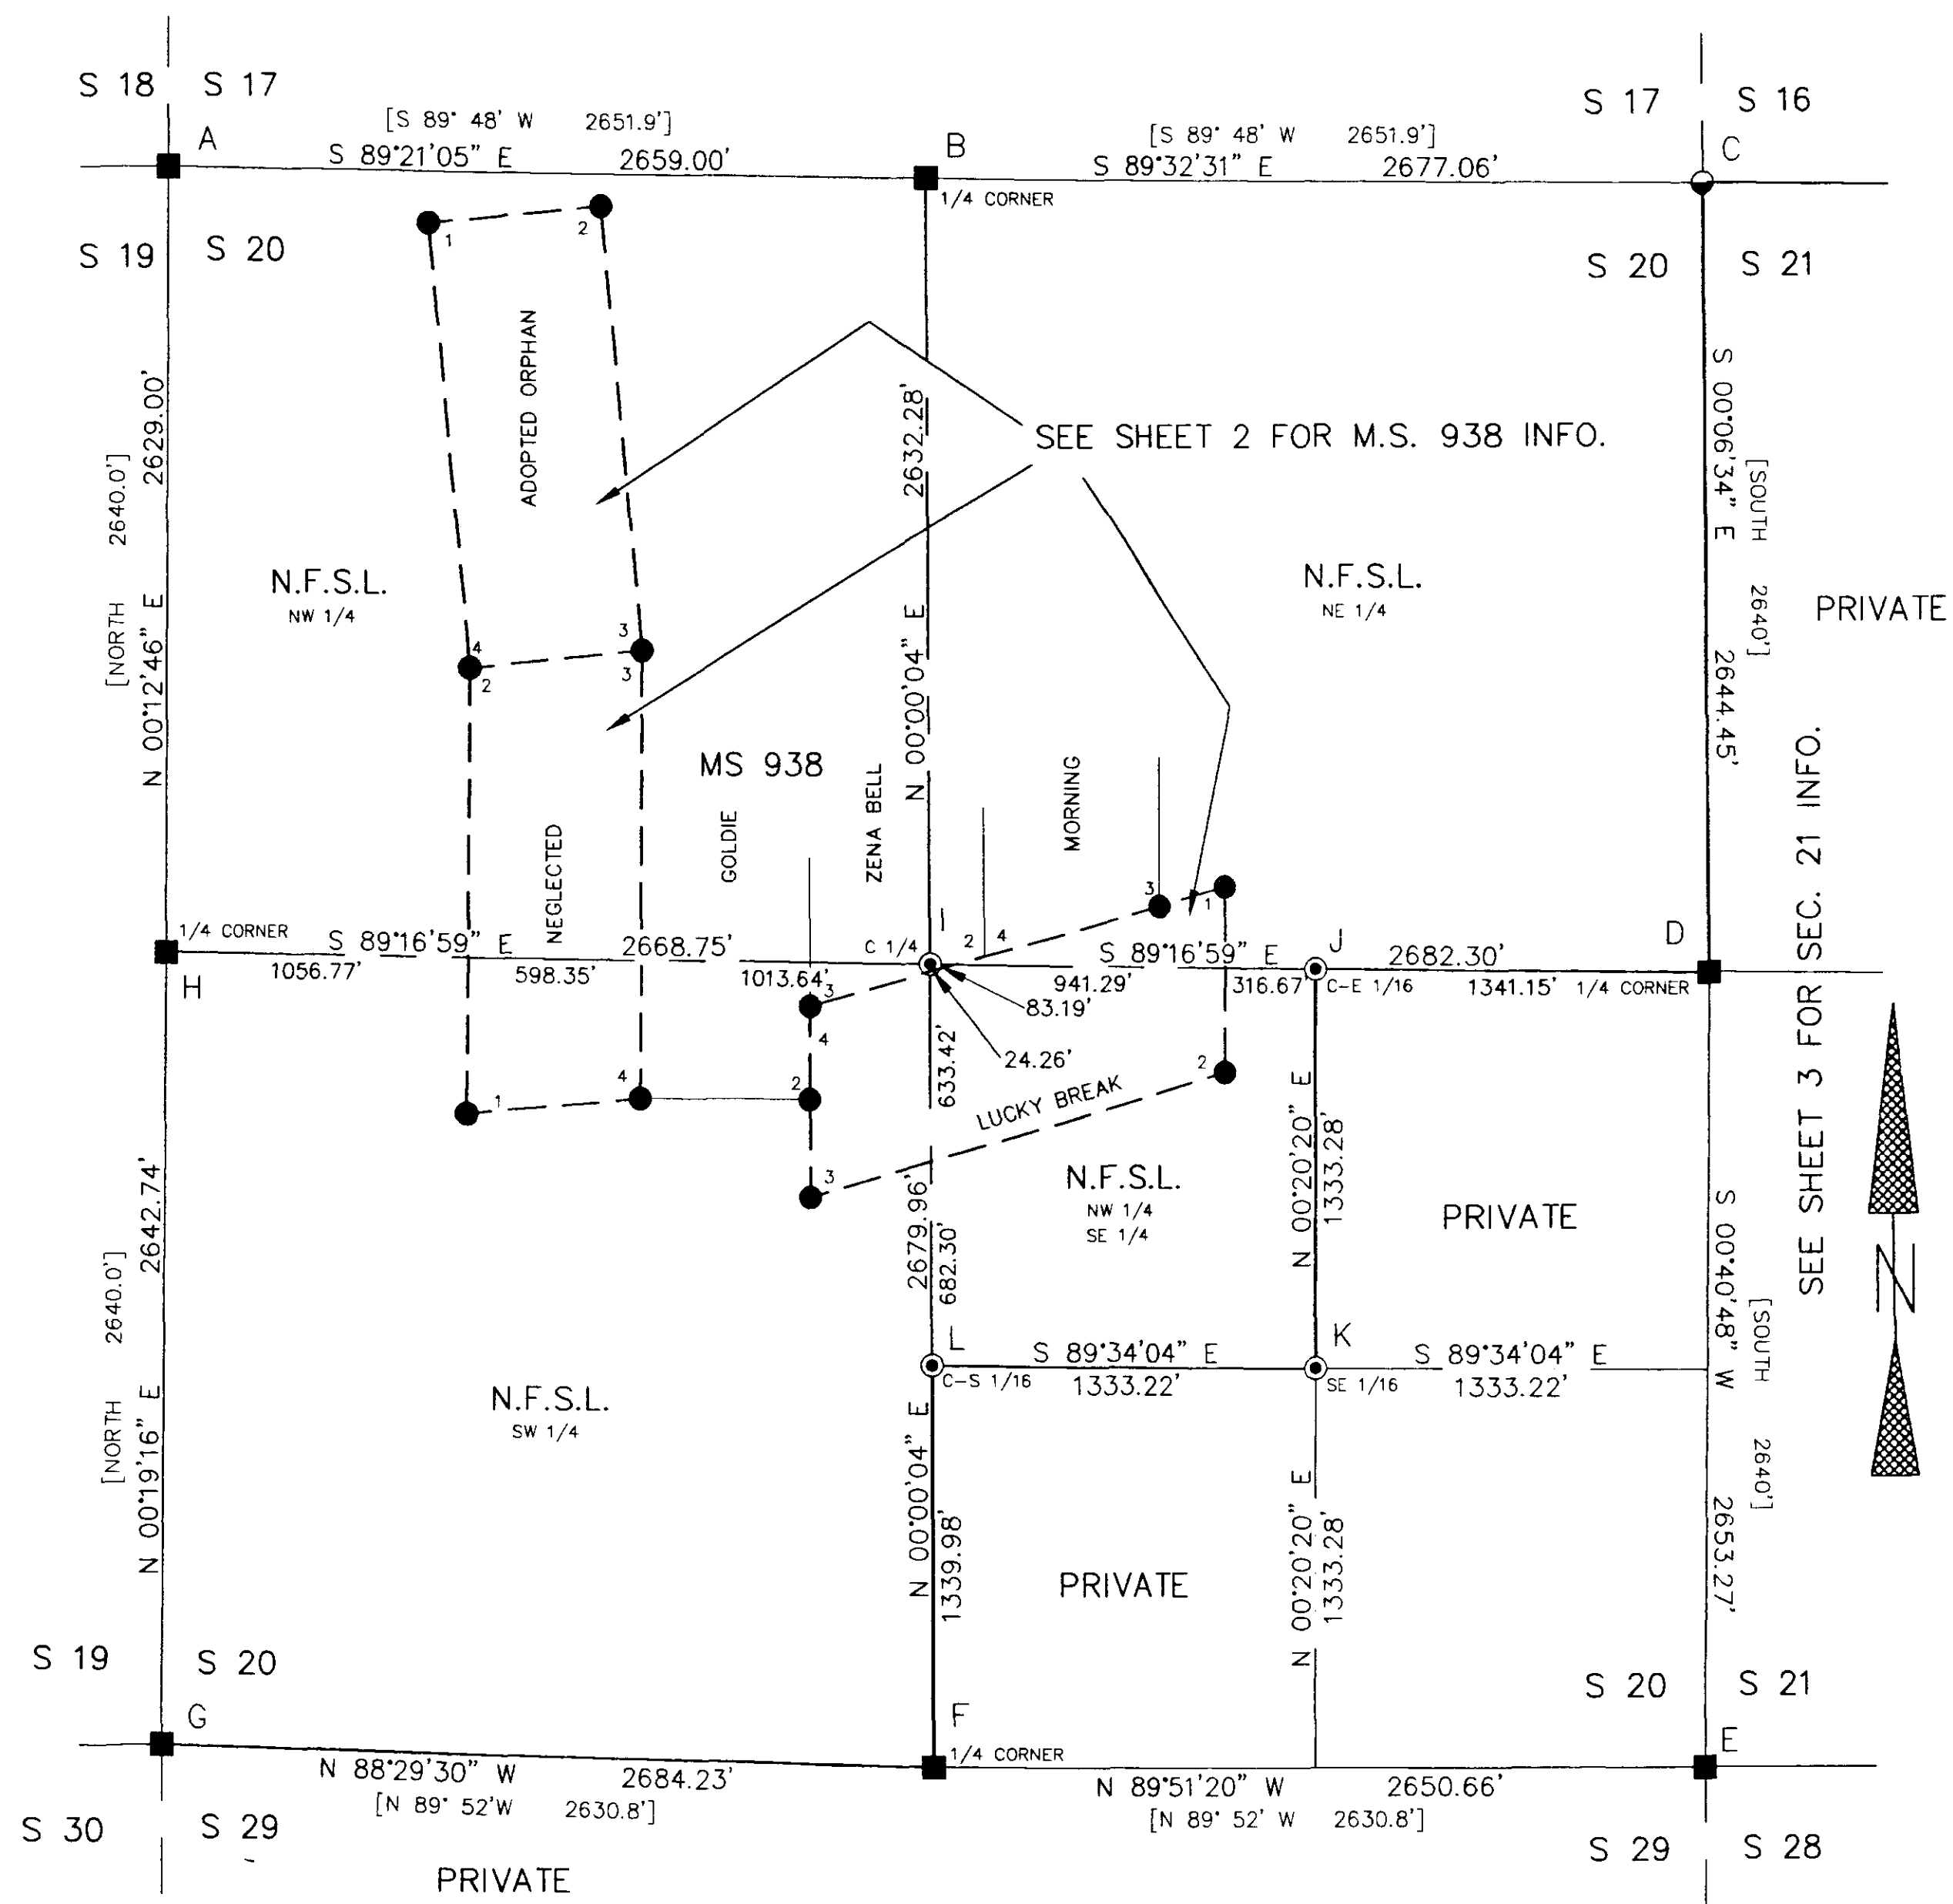

HISTORY OF SURVEYS

THE EXTERIOR OF THE TOWNSHIP WAS SURVEYED IN 1875 BY JOHN W. STONE, DEPUTY SURVEYOR. THE SUBDIVISIONAL SECTION LINES WERE SURVEYED BY W. B. BARR, DEPUTY SURVEYOR IN 1883. MINERAL SURVEY NO. 938 WAS SURVEYED IN 1955 BY GORDON C. SMITH, MINERAL SURVEYOR.

8/30/93
9/16/93
Ronald E. Stoll
038-1993

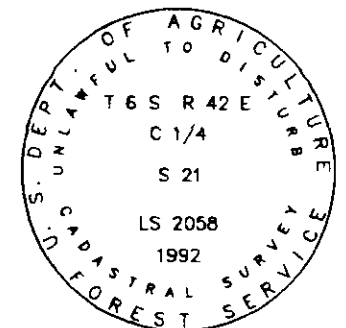

EXAMINED AND ACCEPTED FOR THE U.S. FOREST SERVICE
THIS 24 DAY OF August, 1993, 1992.

Roger Green COR

I CERTIFY THAT THIS SURVEY WAS PERFORMED AT THE REQUEST OF THE WALLOWA-WHITMAN NATIONAL FOREST SUPERVISOR.



Richard 8/24/93
SIGNATURE DATE

A PORTION OF
SECTIONS 20 AND 21
T 6 S R 42 E W.M.
UNION COUNTY, OREGON

RECORD OF SURVEY

RES LAND SURVEYS, INC. 8335 N. PLACITA DADIVOSO TUCSON, ARIZONA 85704

GRAVEL FLAT CADASTRAL SURVEY WALLOWA-WHITMAN NATIONAL FOREST

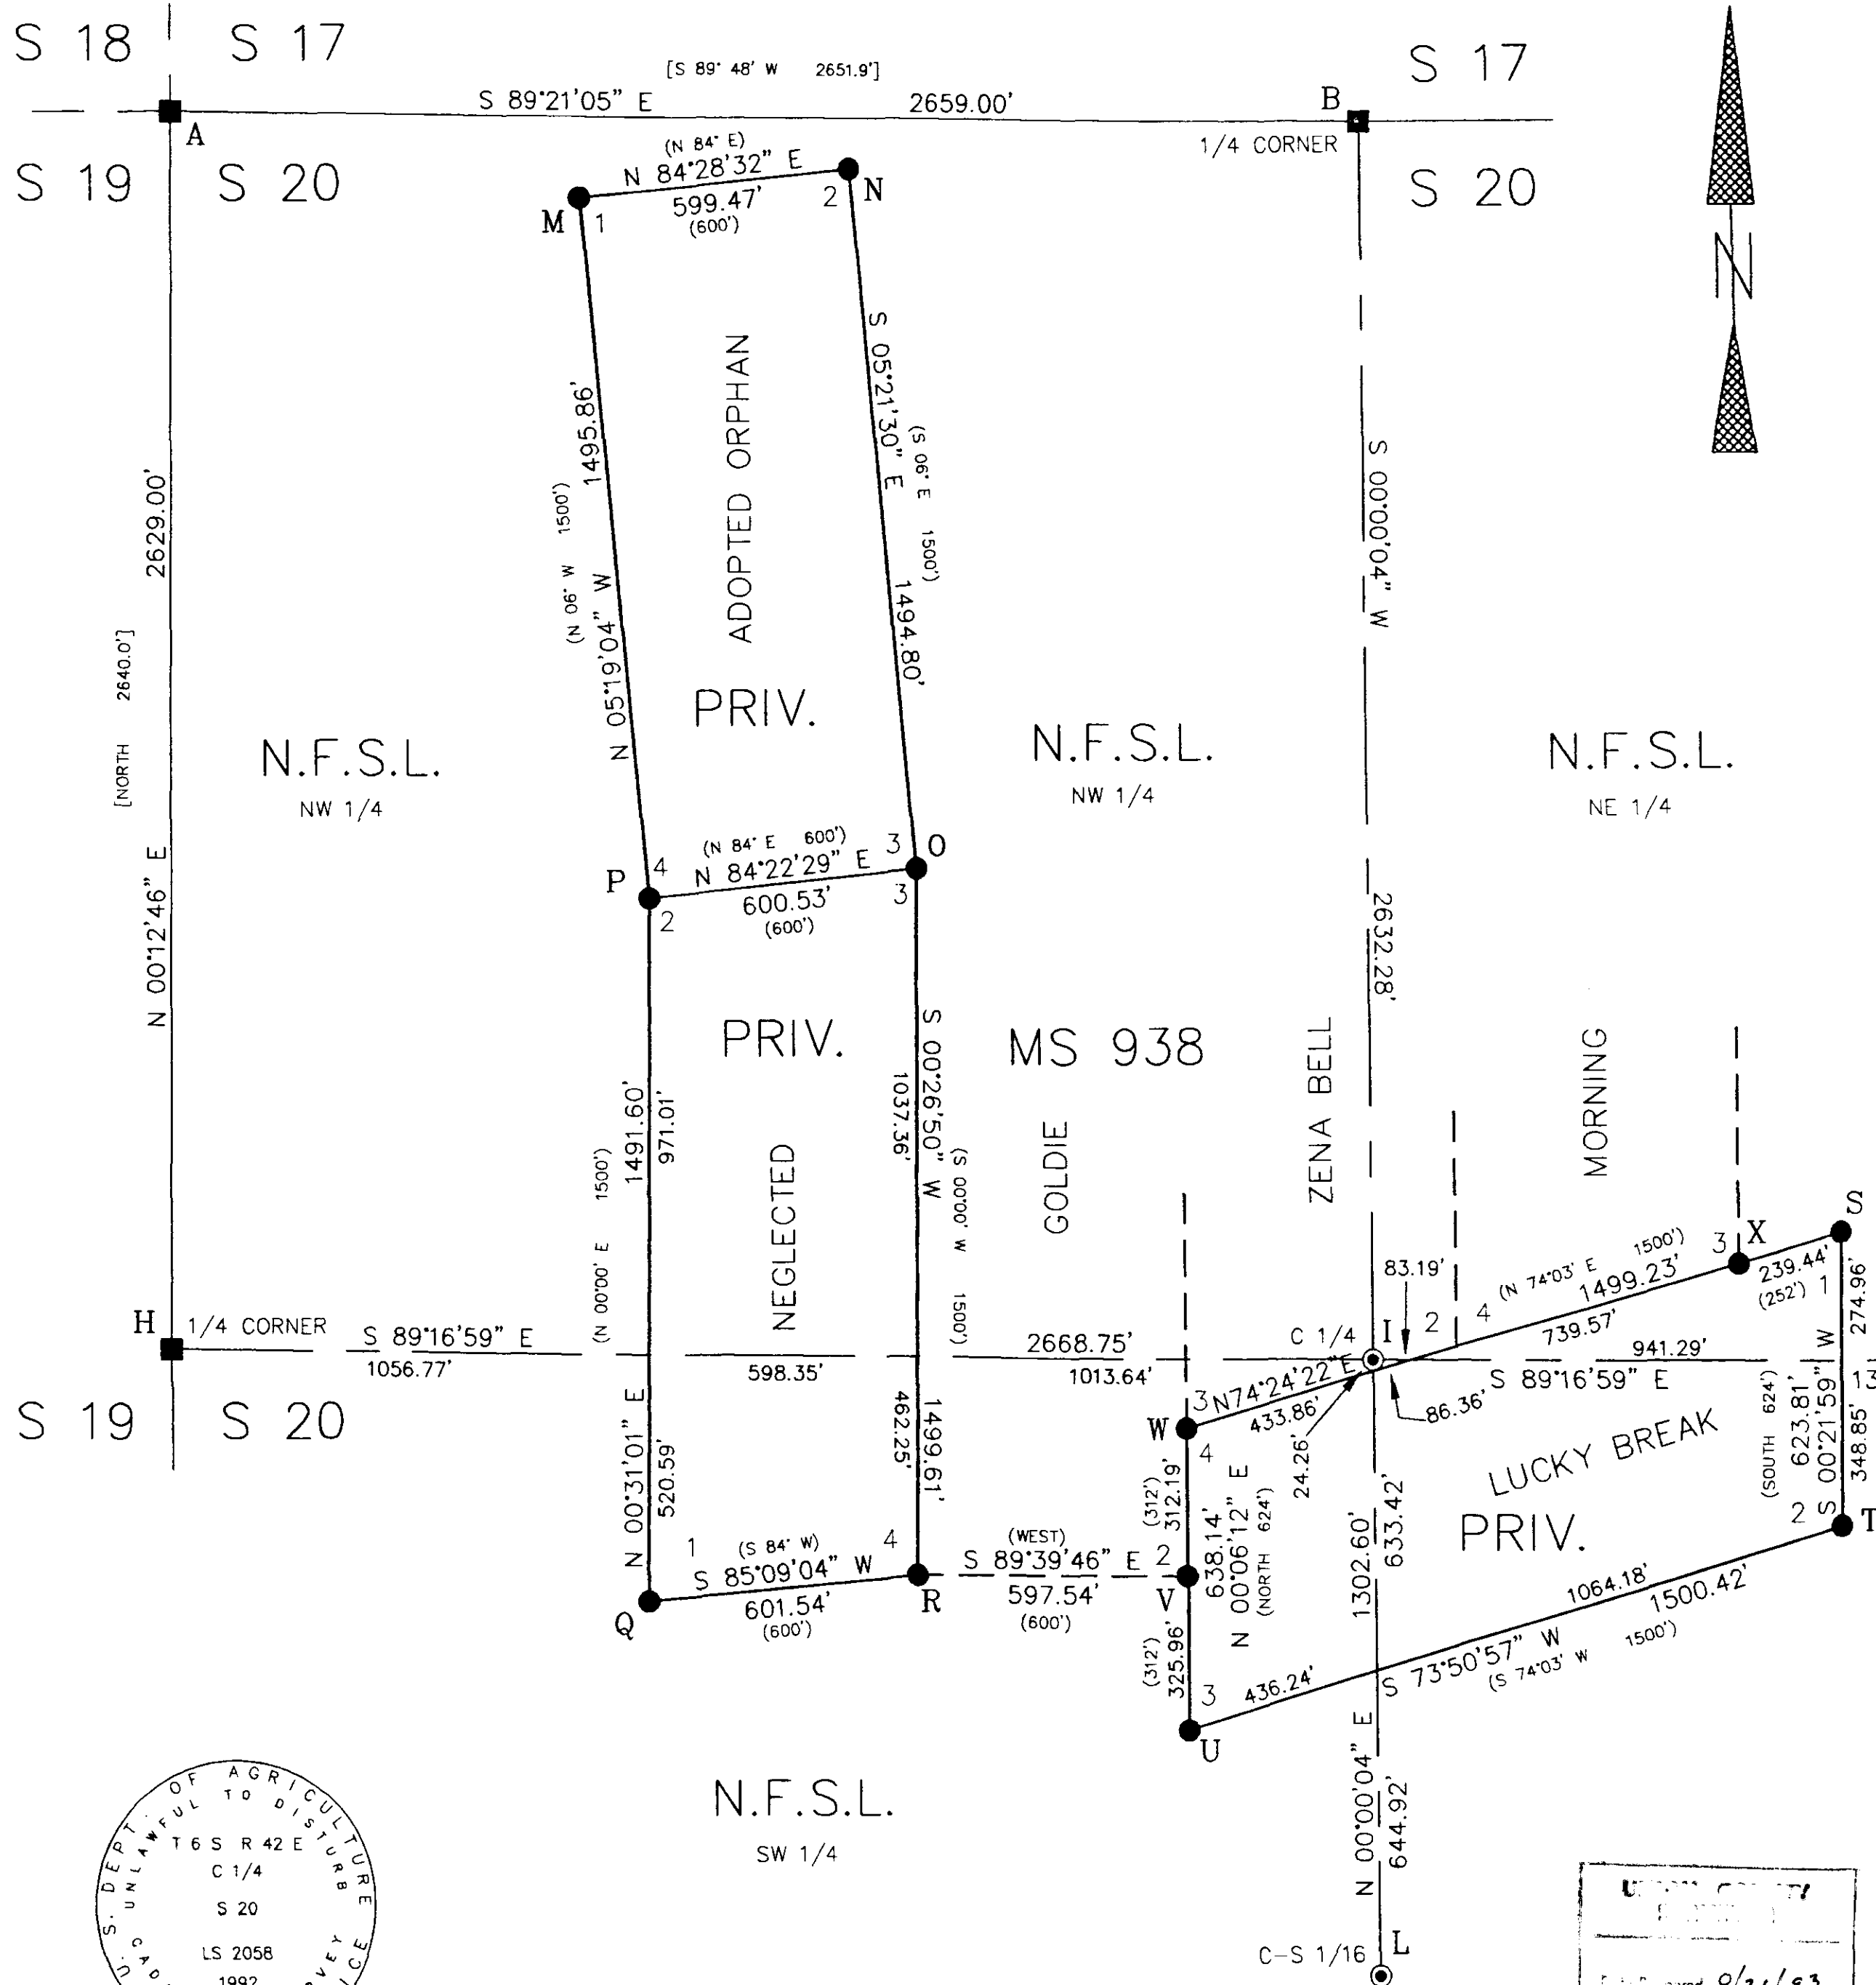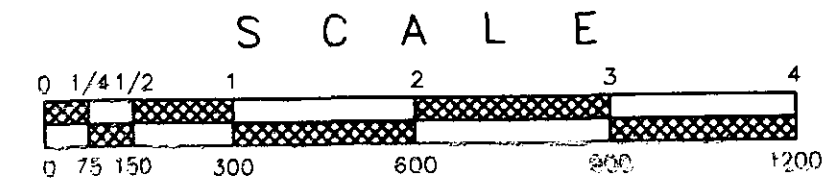

LEGEND

- FOUND G-L-O EVIDENCE, SET A 3" DIAM. U.S.F.S. ALUMINUM CAPPED PIPE, 30" LONG, WITH MAGNET, MARKED PER B-L-M MANUAL, SEE TYPICAL CAP FOR STANDARD MARKINGS
- FOUND MS 938 EVIDENCE, SET A 3" DIAM. U.S.F.S. ALUMINUM CAPPED PIPE, 30" LONG, WITH MAGNET, MARKED PER B-L-M MANUAL, SEE TYPICAL CAP FOR STANDARD MARKINGS
- FOUND 2" DIAM. IRON PIPE WITH BRASS CAP - PLS 1206
- ⊙ SET A 3" DIAM. U.S.F.S. ALUMINUM CAPPED PIPE, 30" LONG, WITH MAGNET, MARKED PER B-L-M MANUAL, SEE TYPICAL CAP FOR STANDARD MARKINGS
- [] RECORD BEARING AND/OR DISTANCE, G-L-O, 1880
- () RECORD BEARING AND/OR DISTANCE, MS 938, 1955
- N.F.S.L. = NATIONAL FOREST SYSTEM LANDS BOUNDARY LINE POSTED TO STANDARD

SURVEY NARRATIVE

BASIS OF BEARING WAS A SOLAR OBSERVATION TAKEN ON 04/03/1992 AT A POINT 6030 FEET NORTH AND 1798 FEET WEST OF THE NE CORNER OF SECTION 21. THE MAGNETIC DECLINATION FOR THIS SURVEY IS 18 1/2' EAST AS DETERMINED FROM A U.S.G.S. TOPO MAP FOR THIS PROJECT AREA.

THIS SURVEY REPRESENTS A RECORD OF THE PARTIAL RETRACEMENT AND/OR SUBDIVISION OF SECTIONS 20 & 21, T 6 S, R 42 E, W.M., BAKER COUNTY, OREGON.

THIS SURVEY WAS PERFORMED AT THE REQUEST OF THE FOREST SUPERVISOR, WALLOWA-WHITMAN NATIONAL FOREST, BAKER CITY, OREGON.

THE PURPOSE OF THIS SURVEY WAS TO DETERMINE THE BOUNDARY LINES BETWEEN THE PRIVATE AND PUBLIC LAND ADMINISTERED BY THE U.S. FOREST SERVICE IN SECTION 20 & 21 AND TO POST TO STANDARD THOSE BOUNDARIES.

THE PROCEDURES USED IN THIS SURVEY WERE IN ACCORDANCE WITH THE CONTRACT SPECIFICATIONS, THE 1973 B-L-M MANUAL AND STATE LAW, RESULTING IN AN ERROR OF CLOSURE OF 1 AND 5000 OR BETTER.

THE EQUIPMENT USED ON THIS SURVEY IS KEPT ADJUSTED AND STANDARDIZED. WE USED A SOKKIA SET 2, 3 OR 4 TOTAL STATION AND LEAP FROGGED A COMPLETE SET UP AT EACH TRAVERSE STATION OR CONTROLLING CORNER.

LOST OR OBLITERATED CORNERS WERE REESTABLISHED IN ACCORDANCE WITH THE B-L-M MANUAL, A COMPLETE DESCRIPTION OF THE CORNERS FOUND, SET OR REESTABLISHED CAN BE FOUND ON PAGE 4 & 5 OF THIS RECORD OF SURVEY. THE FIELD NOTES FOR THIS SURVEY ARE CONTAINED IN BOOK 1, PAGES 1 - 118 TITLED: GRAVEL FLAT CADASTRAL SURVEY.

SURVEYORS CERTIFICATE

THIS PLAT CORRECTLY REPRESENTS A SURVEY MADE BY ME OR UNDER MY DIRECTION IN CONFORMANCE WITH THE STATUTES OF OREGON AND AT THE REQUEST OF THE FOREST SUPERVISOR, WALLOWA-WHITMAN NATIONAL FOREST, DURING THE MONTH OF APRIL, 1992.


REGISTERED
**PROFESSIONAL
SURVEYOR**

W. E. Stoll 8193

OREGON
JULY 16, 1988
RONALD E. STOLL
2058

RONALD E. STOLL, R.L.S. 2058

JOB NO. 1210-691-OR
CONTRACT NO. 53-04M3-1-0113
SHEET 2 OF 5

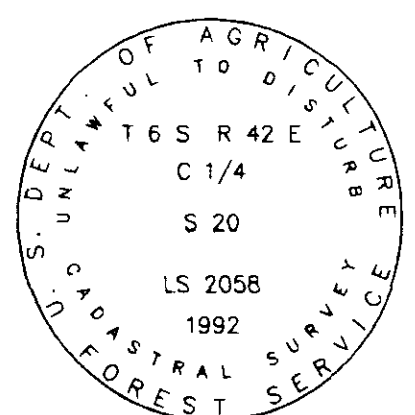

TYPICAL FOREST SERVICE CAP
MARKED PER B-L-M MANUAL

WALLOWA COUNTY
CLERK

FILED 8/30/93

9/10/93

Gregory T. Blak

File No. 038-1993


A PORTION OF
SECTIONS 20 AND 21
T 6 S R 42 E W.M.
UNION COUNTY, OREGON

RECORD OF SURVEY

RES LAND SURVEYS, INC. 8335 N. PLACITA DADIVOSO
TUCSON, ARIZONA 85704

GRAVEL FLAT CADASTRAL SURVEY

WALLOWA-WHITMAN NATIONAL FOREST

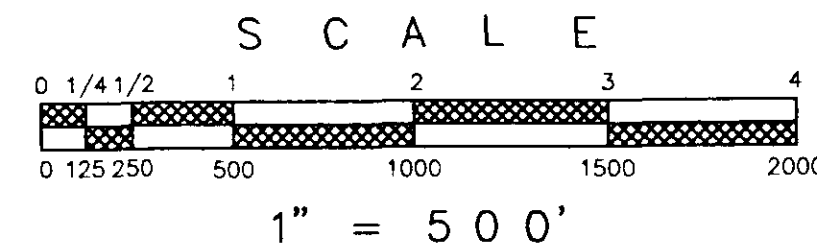

LEGEND

- FOUND G-L-O EVIDENCE, SET A U.S.F.S. 3" DIAM. ALUMINUM CAPPED PIPE, 30" LONG, WITH MAGNET, MARKED PER B-L-M MANUAL, SEE TYPICAL CAP FOR STANDARD MARKINGS
- FOUND MS 938 EVIDENCE, SET A 3" DIAM. U.S.F.S. ALUMINUM CAPPED PIPE, 30" LONG, WITH MAGNET, MARKED PER B-L-M MANUAL, SEE TYPICAL CAP FOR STANDARD MARKINGS
- FOUND 2" DIAM. IRON PIPE WITH BRASS CAP - PLS 1206
- ⊙ SET A 3" DIAM. U.S.F.S. ALUMINUM CAPPED PIPE, 30" LONG, WITH MAGNET, MARKED PER B-L-M MANUAL, SEE TYPICAL CAP FOR STANDARD MARKINGS
- [] RECORD BEARING AND/OR DISTANCE, G-L-O, 1880
- () RECORD BEARING AND/OR DISTANCE, MS 938, 1955
- N.F.S.L. = NATIONAL FOREST SYSTEM LANDS BOUNDARY LINE POSTED TO STANDARD

SURVEY NARRATIVE

BASIS OF BEARING WAS A SOLAR OBSERVATION TAKEN ON 04/03/1992 AT A POINT 6030 FEET NORTH AND 1798 FEET WEST OF THE NE CORNER OF SECTION 21. THE MAGNETIC DECLINATION FOR THIS SURVEY IS 18 1/2' EAST AS DETERMINED FROM A U.S.G.S. TOPO MAP FOR THIS PROJECT AREA.

THIS SURVEY REPRESENTS A RECORD OF THE PARTIAL RETRACEMENT AND/OR SUBDIVISION OF SECTIONS 20 & 21, T 6 S, R 42 E, W.M., BAKER COUNTY, OREGON.

THIS SURVEY WAS PERFORMED AT THE REQUEST OF THE FOREST SUPERVISOR, WALLOWA-WHITMAN NATIONAL FOREST, BAKER CITY, OREGON.

THE PURPOSE OF THIS SURVEY WAS TO DETERMINE THE BOUNDARY LINES BETWEEN THE PRIVATE AND PUBLIC LAND ADMINISTERED BY THE U.S. FOREST SERVICE IN SECTION 20 & 21 AND TO POST TO STANDARD THOSE BOUNDARIES.


THE PROCEDURES USED IN THIS SURVEY WERE IN ACCORDANCE WITH THE CONTRACT SPECIFICATIONS, THE 1973 B-L-M MANUAL AND STATE LAW, RESULTING IN AN ERROR OF CLOSURE OF 1 AND 5000 OR BETTER.

THE EQUIPMENT USED ON THIS SURVEY IS KEPT ADJUSTED AND STANDARDIZED. WE USED A SOKKIA SET 2,3 OR 4 TOTAL STATION AND LEAP FROGGED A COMPLETE SET UP AT EACH TRAVERSE STATION OR CONTROLLING CORNER.

LOST OR OBLITERATED CORNERS WERE REESTABLISHED IN ACCORDANCE WITH THE B-L-M MANUAL, A COMPLETE DESCRIPTION OF THE CORNERS FOUND, SET OR REESTABLISHED CAN BE FOUND ON PAGE 4 & 5 OF THIS RECORD OF SURVEY. THE FIELD NOTES FOR THIS SURVEY ARE CONTAINED IN BOOK 1, PAGES 1 - 118 TITLED: GRAVEL FLAT CADASTRAL SURVEY.

SURVEYORS CERTIFICATE

THIS PLAT CORRECTLY REPRESENTS A SURVEY MADE BY ME OR UNDER MY DIRECTION IN CONFORMANCE WITH THE STATUTES OF OREGON AND AT THE REQUEST OF THE FOREST SUPERVISOR, WALLOWA-WHITMAN NATIONAL FOREST, DURING THE MONTH OF APRIL, 1992.

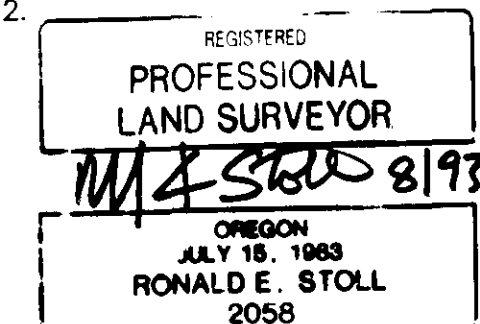

JOB NO. 1210-691-OR
CONTRACT NO. 53-04M3-1-0113
SHEET 3 OF 5


RONALD E. STOLL, R.L.S. 2058

A PORTION OF
SECTIONS 20 AND 21
T 6 S R 42 E W.M.
UNION COUNTY, OREGON

RECORD OF SURVEY

RES LAND SURVEYS, INC.

8335 N. PLACITA DADIVOSO
TUCSON, ARIZONA 85704

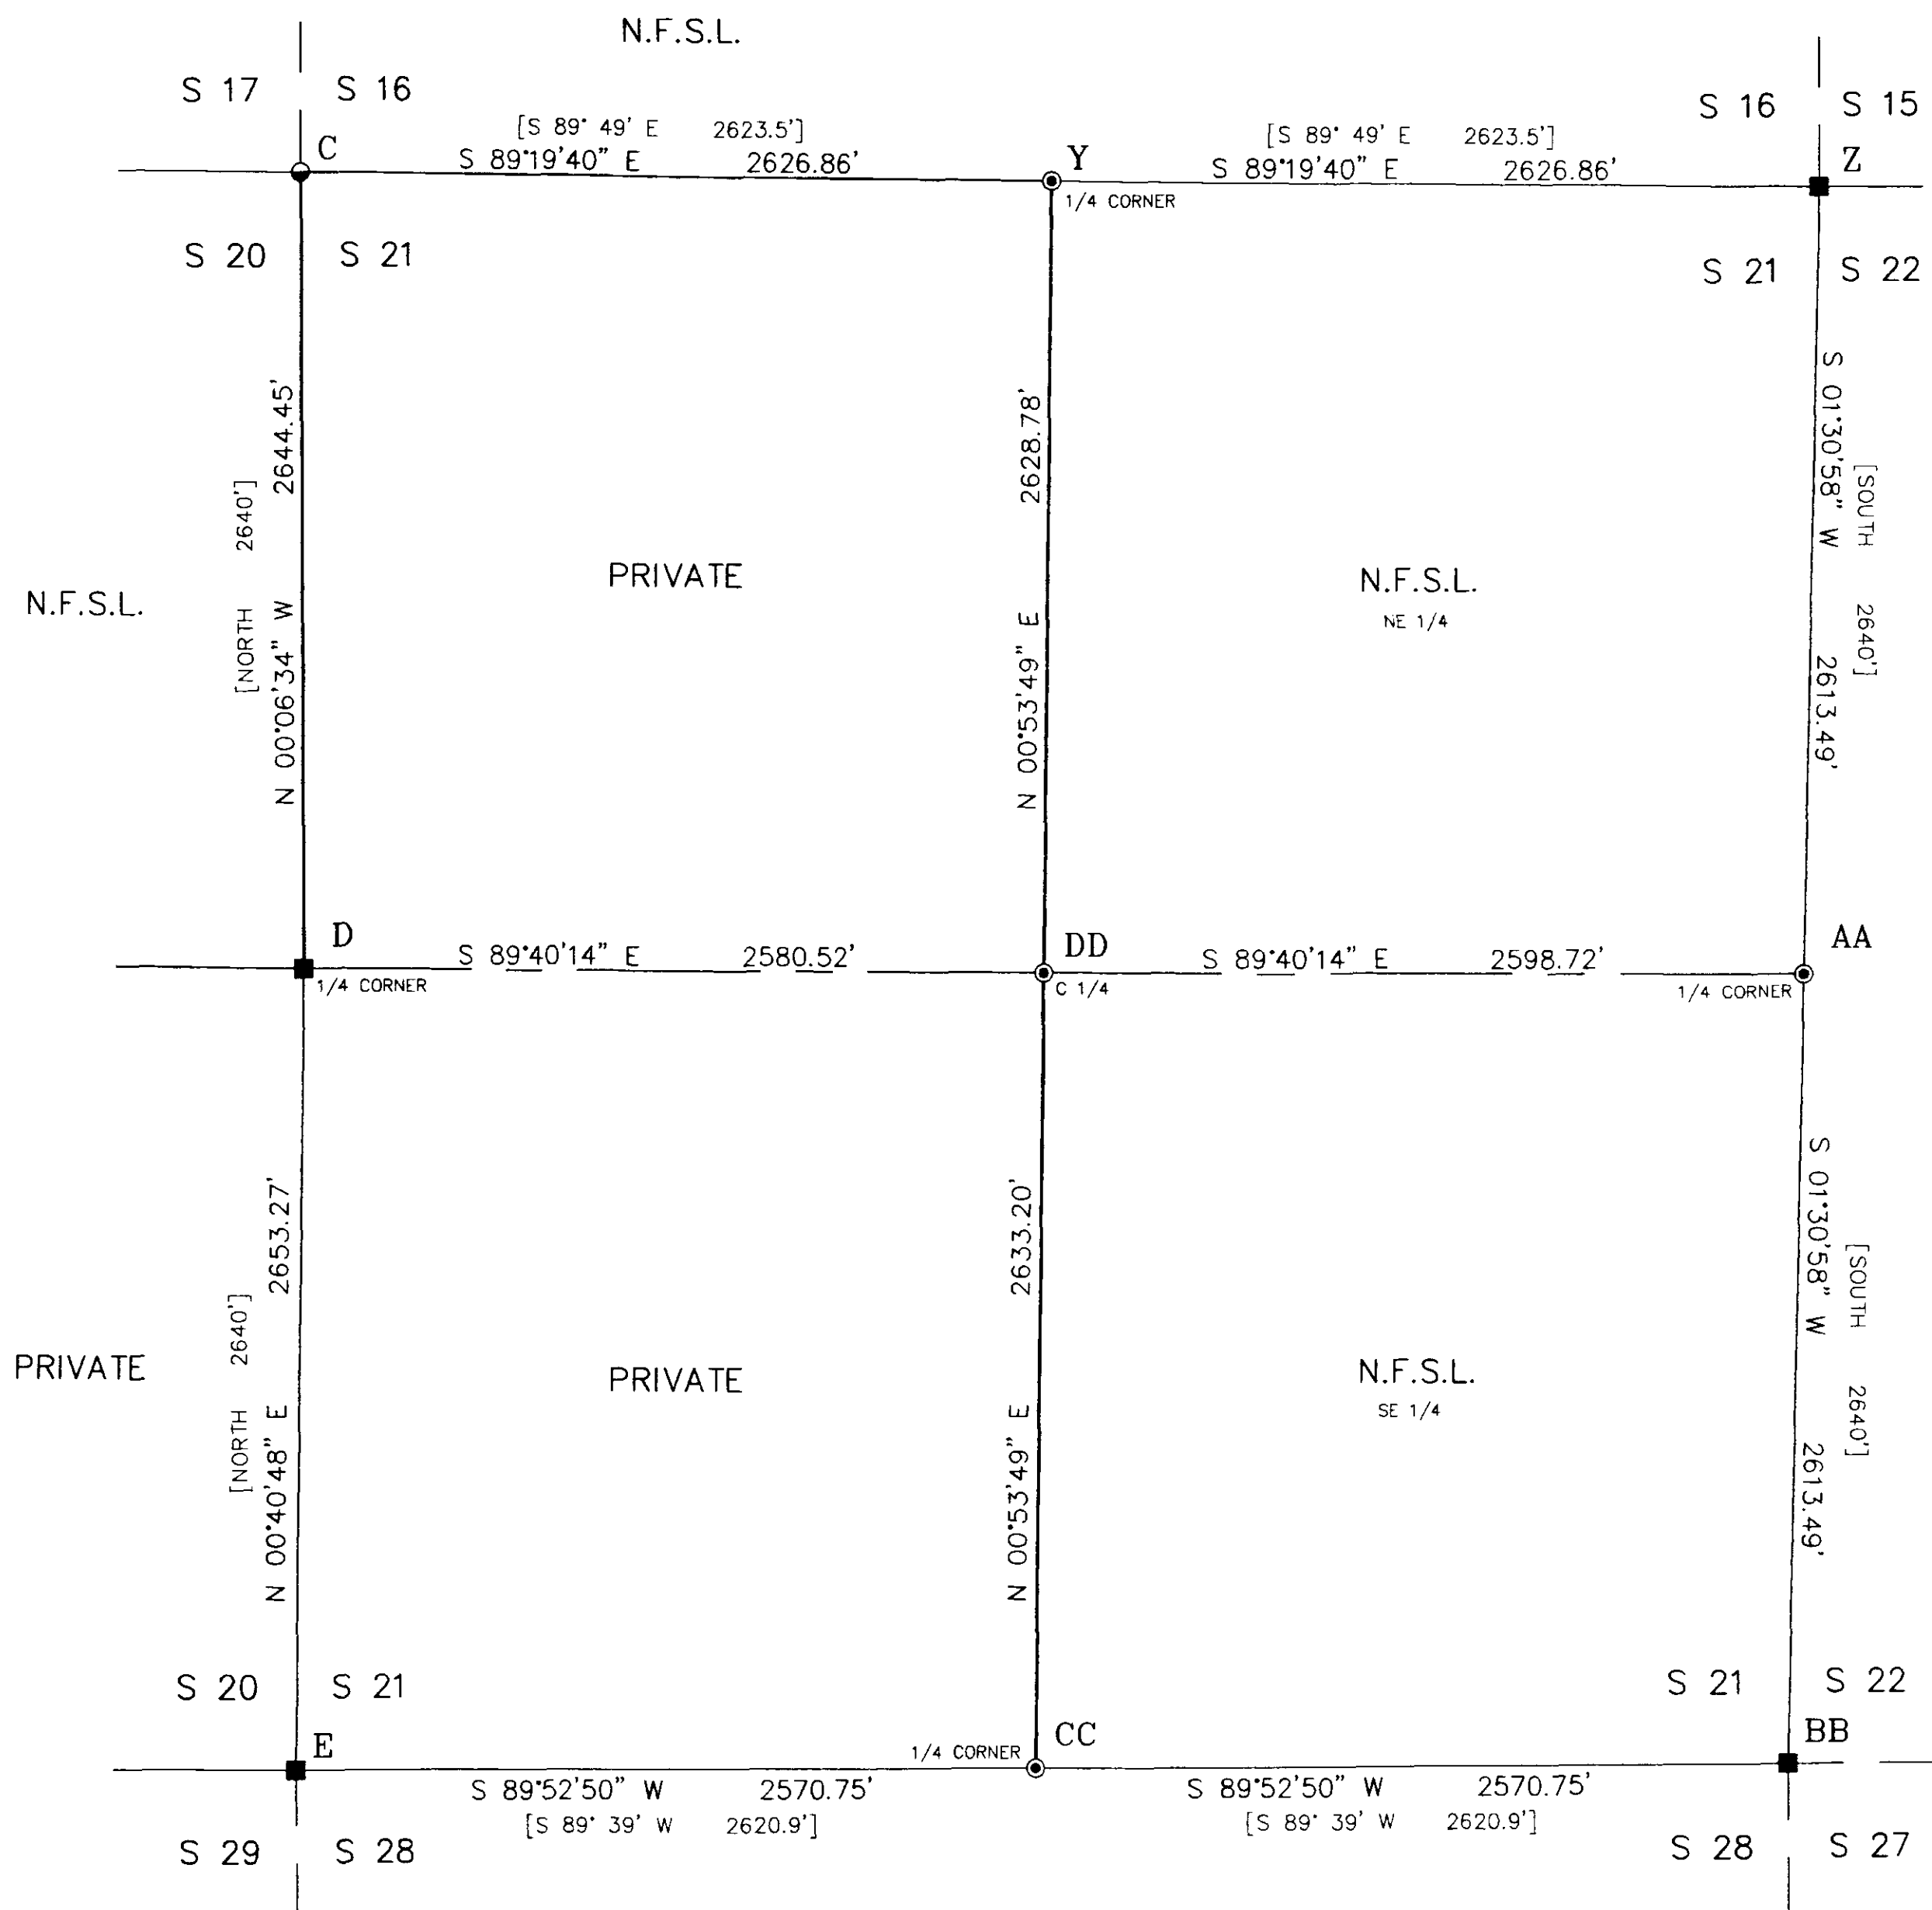

BAKER COUNTY
SURVEY

Received 8/30/93

Filed 9/10/93

By: *Ronald E. Stoll*

File No. 038-1993

DEPARTMENT OF AGRICULTURE

T 6 S R 42 E

C 1/4

S 21

LS 2058

1992


GRAVEL FLAT CADASTRAL SURVEY

WALLOWA-WHITMAN NATIONAL FOREST

TYPICAL FOREST SERVICE CAP
MARKED PER B-L-M MANUAL

A: CORNER TO SECTIONS 17, 18, 19, & 20:

NO EVIDENCE OF ORIGINAL MONUMENT FOUND. POSITION ESTABLISHED FROM INTERSECTION OF RECORD BEARINGS FROM FOUND ORIGINAL BEARING TREES. MONUMENT SET 22" IN GROUND WITH MOUND OF STONE TO CAP, CAP MARKED:

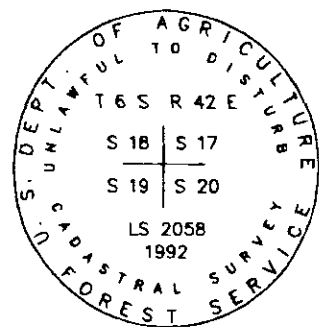


FROM WHICH G.L.O. ACCESSORIES:
A FIR, 36" [20"] IN DIAM. BEARS S 75° W [S 75° W], 26.21' [25.7'], MARKED WITH PARTIALLY OPEN BLAZE.
A ROTTED PINE STUMP, 29" [20"] IN DIAM. BEARS S 72° E [S 72° E], 8.95' [8.6'], NO BLAZE VISIBLE.
A PINE, 33" [22"] IN DIAM. BEARS N 36° E [N 36° E], 22.75' [15.2'], BLAZE OPEN AND SCRIBING VISIBLE.
A 28" [18"] PINE, DEAD AND DOWN BEARS N 60° W [N 60° W], 67.3' [67.3']

FROM WHICH LS2058 ACCESSORIES:

A FIR, 13" DIAM. BEARS N 80°53' W, 18.94', SCRIBED "T6SR42ES18BT".
A FIR, 17" DIAM. BEARS N 45°33' W, 29.00', SCRIBED "T6SR42ES18BT".
A FIR, 9" DIAM. BEARS S 33°32' E, 40.58', SCRIBED "T6SR42ES20BT".

B: 1/4 CORNER TO SECTIONS 17 & 20:

FOUND EVIDENCE OF OLD STONE IN A MOUND OF STONE, NO MARKINGS VISIBLE. SET MONUMENT 25" IN GROUND WITH MOUND OF STONE TO CAP, AND BURIED STONE TO WEST.

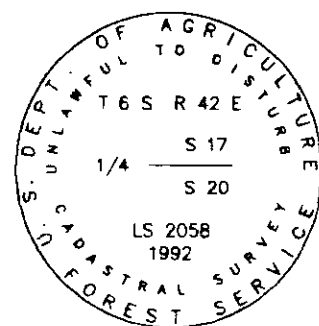

FROM WHICH G.L.O. ACCESSORIES:


A PINE STUMP, 36" [22"], 12" HIGH BEARS N 71° W [N 71° W], 38.6' [37.6'], MARKED WITH OPEN BLAZE SCRIBED "T".

FROM WHICH LS2058 ACCESSORIES:

A FIR, 9" DIAM. BEARS N 43°23' W, 59.49', MKD. T6SR42ES17BT
A FIR, 10" DIAM. BEARS S 36°31' W, 17.61', MKD. T6SR42ES20BT
A PINE, 15" DIAM. BEARS S79°26'E, 32.39', MKD. T6SR42ES20BT
A PINE, 17" DIAM. BEARS N16°05'E, 23.30', MKD. T6SR42ES17BT

C: CORNER TO SECTIONS 16, 17, 20 & 21:

FOUND A 2 1/2" BRASS CAP MONUMENT, 6" ABOVE GROUND IN A 2 1/2" DIAM. MOUND OF STONE. CAP MARKED:

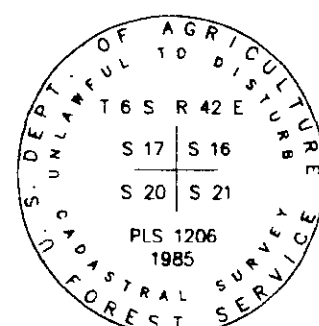

FROM WHICH G.L.O. ACCESSORIES:


A PINE STUMP, 24" [24"] {20"} DIAM. BEARS N60°E [N58°E] {N58°E}, 56.52' [56.1'] {56.8'}, SCRIBED "BT" VISIBLE.

FROM WHICH LS1206 ACCESSORIES:

A DEAD PINE, 12" {12"} DIAM. BEARS S41°18'E {S43°E}, 40.72' {40.8'}, SCRIBED T6SR42ES21BT
A PINE, 9" {9"} DIAM. BEARS S6°24'W {S4°W}, 17.50' {17.8'}, SCRIBED T6SR42ES20BT
A PINE, 9" {10"} DIAM. BEARS N48°W {N38°W}, 5.38' {5.2'}, SCRIBED T6SR42ES17BT
A PINE, 10" {10"} DIAM. BEARS N65°44'E {N63°E}, 12.50' {12.5'}, SCRIBED T6SR42ES16BT

D: 1/4 CORNER TO SECTIONS 20 & 21:

NO EVIDENCE OF ORIGINAL MONUMENT FOUND. POSITION ESTABLISHED AT RECORD BEARING AND DISTANCE FROM REMAINS OF 22" BURNT PINE LOG AND ROOT HOLE. MONUMENT SET 20" IN GROUND AND CAP MARKED:

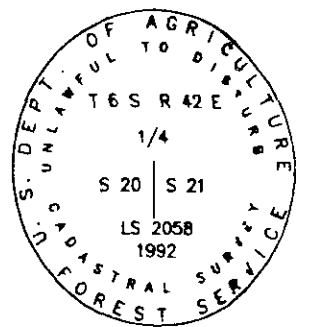

FROM WHICH G.L.O. ACCESSORIES:


A BURNT PINE LOG AND ROOT HOLE, 22" [16"] DIAM. BEARS S48°E [S48°E], 120.10' [120.1'], NO SCRIBING VISIBLE.
A BURNT PINE LOG, 24" [14"] DIAM. BEARS S09°W [S09°W], 142.6' [142.6'], NO SCRIBING VISIBLE.

FROM WHICH LS2058 ACCESSORIES:

A PINE, 12" DIAM. BEARS N20°46'E, 20.23'
A PINE, 9" DIAM. BEARS S07°43'E, 93.85'
A PINE, 9" DIAM. BEARS S78°57'E, 62.45'
A 3/4" DRILL HOLE IN N-S LEDGE ROCK BEARS N52°01'W, 68.38'

E: CORNER TO SECTIONS 20, 21, 28, & 29:

NO EVIDENCE OF ORIGINAL MONUMENT FOUND. POSITION ESTABLISHED USING RECORD BEARING AND DISTANCE FROM FOUND ORIGINAL BEARING TREE STUMP. MONUMENT SET 2" IN GROUND WITH MOUND OF STONE TO CAP, CAP MARKED:

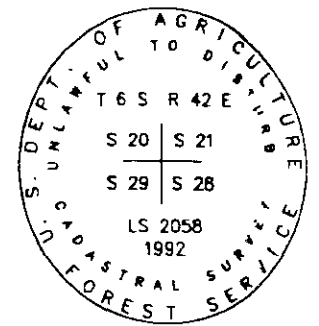

FROM WHICH G.L.O. ACCESSORIES:


A PINE STUMP, 20" [15"] DIAM. BEARS S16°E [S16°E], 56.10' [56.1'], SCRIBING VISIBLE IN BLAZE.
A LOG/ROOT HOLE, 26" [26"] DIAM. BEARS N75°E [N75°E], 47.5' [47.5']

FROM WHICH LS2058 ACCESSORIES:

A CHISELED HOLE, BEARS N27°54'W, 92.54'
A CHISELED HOLE, BEARS S18°21'E, 44.88'
A PINE, 7" DIAM. BEARS N77°31'W, 90.43', SCRIBED XBT
A PINE, 15" DIAM. BEARS N77°59'E, 61.57', SCRIBED T6SR42ES21BT

F: 1/4 CORNER TO SECTIONS 20 & 29:

FOUND A STONE, 12"x8"x6" [12X8X6], IN A SMALL MOUND OF STONE, MARKED 1/4 ON NORTH FACE. SET MONUMENT 24" IN GROUND AT POSITION OF MARKED STONE AND BURIED MARKED STONE TO SOUTH, CAP MARKED:

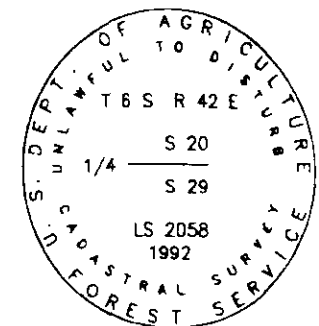

FROM WHICH G.L.O. ACCESSORIES:


A PINE STUMP, 30" [30"] DIAM. BEARS S08°59'E [S10°30'E], 97.56' [97.0'], PARTIAL BLAZE VISIBLE

FROM WHICH LS2058 ACCESSORIES:

A PINE, 15" DIAM. BEARS S06°12'W, 53.71', SCRIBED T6SR42ES29BT
A PINE, 14" DIAM. BEARS N80°08'W, 59.83', SCRIBED T6SR42ES20BT
A PINE, 7" DIAM. BEARS N25°09'W, 24.74', SCRIBED T6SR42ES20BT
A PINE, 15" DIAM. BEARS N59°58'E, 86.15', SCRIBED T6SR42ES20BT

G: CORNER TO SECTIONS 19, 20, 29, & 30:

FOUND A STONE, 12"x12"x8" [12X12X8], WITH 2 NOTCHES ON SOUTH AND 5 NOTCHES ON EAST. SET MONUMENT 20" IN GROUND AND BURIED MARKED STONE TO EAST. CAP MARKED:

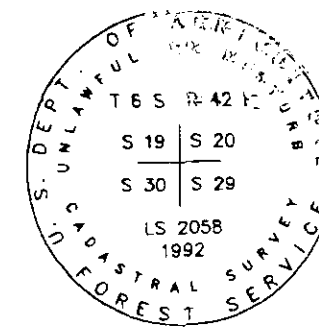


FROM WHICH LS2058 ACCESSORIES:

SET 1/2" REBAR BEARS S88°02'E, 26.71'
SET 1/2" REBAR BEARS S14°03'W, 24.15'
CHISELED X IN ROCK BEARS N88°12'W, 23.17'
SET 1/2" REBAR BEARS N12°40'E, 21.27'

H: 1/4 CORNER TO SECTIONS 19 & 20:

NO EVIDENCE OF ORIGINAL MONUMENT FOUND. SET MONUMENT FROM FOUND ORIGINAL BEARING TREES. SET MONUMENT 26" IN GROUND WITH MOUND OF STONE TO CAP. CAP MARKED:

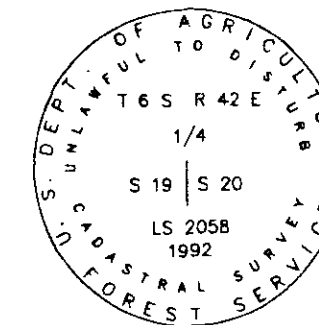

FROM WHICH G.L.O. ACCESSORIES:


A PINE STUMP, 42" [26"] DIAM. BEARS N28°23'W [N25°W], 14.89' [18.5'], BLAZE AND SCRIBING VISIBLE
A PINE, DEAD AND DOWN, 24" [22"] DIAM. BEARS N47°27'E [N48°E], 21.68' [21.1'], BLAZE AND FAINT SCRIBING VISIBLE

FROM WHICH LS2058 ACCESSORIES:

A FIR, 12" DIAM. BEARS N71°34'E, 41.56', SCRIBED T6SR42ES20BT
A FIR, 12" DIAM. BEARS S23°21'E, 18.76', SCRIBED T6SR42ES20BT
A FIR, 12" DIAM. BEARS S50°13'W, 37.67', SCRIBED T6SR42ES19BT
A FIR, 10" DIAM. BEARS N50°07'W, 68.80', SCRIBED T6SR42ES19BT

I: CENTER 1/4 CORNER TO SECTION 20:

MONUMENT SET 26" IN GROUND WITH MOUND OF STONE TO CAP. CAP MARKED:

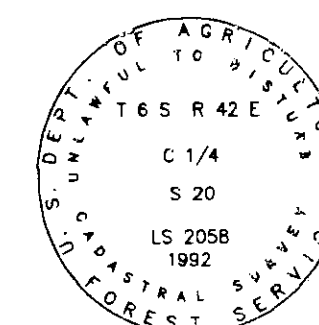


FROM WHICH LS2058 ACCESSORIES:

A TAMARACK, 10" DIAM. BEARS N16°25'E, 1.32'
SCRIBED C1/4S20BT
A PINE, 6" DIAM. BEARS N71°52'E, 18.01', SCRIBED C1/4S20BT
A FIR, 17" DIAM. BEARS S13°09'E, 37.04', SCRIBED C1/4S20BT
A FIR, 11" DIAM. BEARS N85°16'W, 26.88', SCRIBED C1/4S20BT

J: CENTER EAST 1/16 CORNER SECTION 20:

MONUMENT SET 26" IN GROUND WITH MOUND OF STONE TO CAP. CAP MARKED:

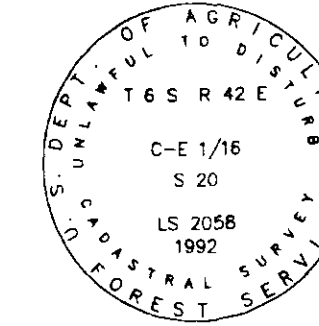

FROM WHICH LS2058 ACCESSORIES:


A PINE, 7" DIAM. BEARS N27°49'E, 6.17', SCRIBED CE1/16S20BT
A PINE, 17" DIAM. BEARS S73°32'E, 8.83', SCRIBED CE1/16S20BT

NOTES


BEARINGS TO BEARING TREES WERE TAKEN TO A NAIL AND BRASS TAG, MARKED LS 2058, PLACED AT THE BASE OF THE FRONT FACE OF THE TREE OR ABOVE THE "B" IN "BT" IN THE BLAZE. DISTANCES WERE TAKEN TO 16d GALVANIZED NAIL IN THE SIDE CENTER BASE OF THE BEARING TREES.

MONUMENT = A 3" DIAM. U.S.F.S. ALUMINUM CAPPED PIPE, 30" LONG, WITH MAGNET

- [] RECORD BEARING AND/OR DISTANCE, G-L-O, 1883
- () RECORD BEARING AND/OR DISTANCE, MS 938, 1955
- { } RECORD BEARING AND/OR DISTANCE, LS1206

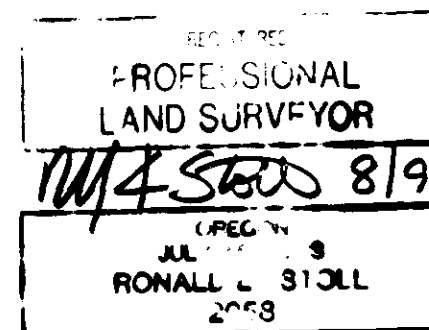


RONALD E. STOLL, R.L.S. 2058

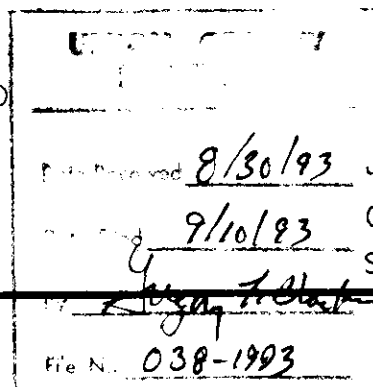

A PORTION OF
SECTIONS 20 AND 21
T 6 S R 42 E W.M.
UNION COUNTY, OREGON
RECORD OF SURVEY
RES LAND SURVEYS, INC. 8335 PLACITA DADIVOSO
TUCSON, ARIZONA 85704

K: SOUTHEAST 1/16 CORNER SECTION 20:

MONUMENT SET 24" IN GROUND WITH MOUND OF STONE TO CAP. CAP MARKED:

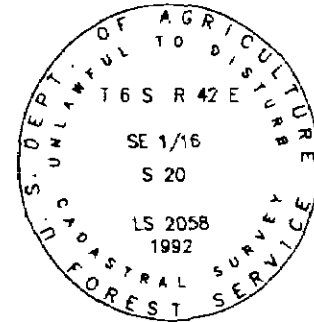


FROM WHICH LS2058 ACCESSORIES:

A PINE, 12" DIAM. BEARS N73°55'E, 9.42', SCRIBED SE1/16S20BT
A PINE, 10" DIAM. BEARS S24°46'E, 24.46', SCRIBED SE1/16S20BT

L: CENTER SOUTH 1/16 CORNER SECTION 20:

MONUMENT SET 25" IN GROUND WITH MOUND OF STONE TO CAP. CAP MARKED:

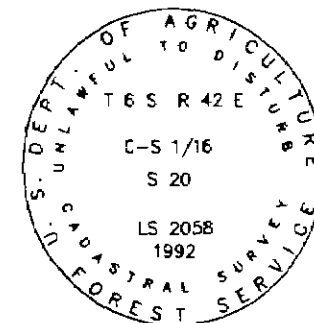


FROM WHICH LS2058 ACCESSORIES:

A FIR, 12" DIAM. BEARS N02°01'E, 72.62', SCRIBED C-S1/16S20BT
A FIR, 18" DIAM. BEARS N78°36'W, 21.71', SCRIBED C-S1/16S20BT

M: CORNER 1 ADOPTED ORPHAN - MS 938:

FOUND 1 1/4" PIPE IN A 30"x12" MOUND OF STONE. MONUMENT SET 24" IN GROUND AND BURIED FOUND PIPE TO WEST. CAP MARKED:

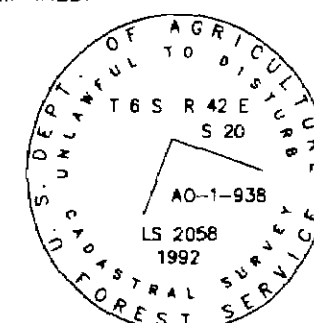


FROM WHICH MS-938 ACCESSORIES:

A PINE, 12" (14") DIAM. BEARS N65°51'E (N73°E), 19.81' (19'), BLAZE CLOSED
A PINE, 14" (14") DIAM. BEARS N68°15'W (N68°W), 4.40' (4'), BLAZE CLOSED

N: CORNER 2 ADOPTED ORPHAN - MS 938:

FOUND 1 1/4" PIPE AND STONE MARKED
2 AO 938 ON WEST FACE.
MONUMENT SET 24" IN GROUND AND BURIED FOUND PIPE TO WEST. CAP MARKED:

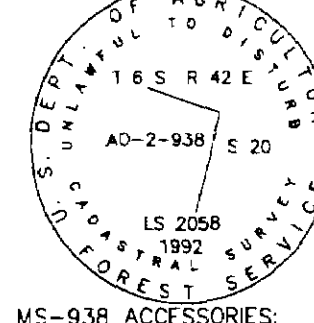


FROM WHICH MS-938 ACCESSORIES:

A FIR, 12" (12") DIAM. BEARS S53°49'W (S57°W), 11.73' (11.3'), BLAZE CLOSED
A FIR, 7" (6") DIAM. BEARS S89°02'E (S85°E), 9.98' (9.9'), BLAZE CLOSED

**O: CORNER 3 ADOPTED ORPHAN - MS 938:
CORNER 3 NEGLECTED - MS 938:**

FOUND A 1" PIPE AND CAP ALONGSIDE MARKED STONE. SET MONUMENT 23" IN GROUND AND BURIED FOUND EVIDENCE ALONGSIDE. BUILD MOUND OF STONE TO CAP MARKED:

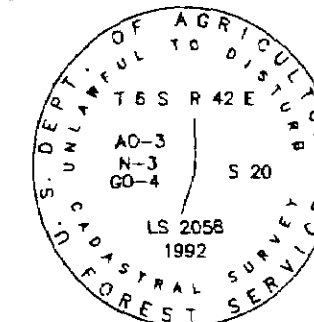


FROM WHICH MS-938 ACCESSORIES:

A PINE, 10" (8") DIAM. BEARS S88°42'E (S60°E), 13.27' (13.1'), BLAZE CLOSED
A PINE, 8" (8") DIAM. BEARS S17°27'W (S20°W), 32.93' (33'), BLAZE CLOSED

**P: CORNER 4 ADOPTED ORPHAN - MS 938:
CORNER 2 NEGLECTED - MS 938:**

FOUND 1 1/4" PIPE IN A 30"x12" MOUND OF STONE. MONUMENT SET 24" IN GROUND AND OVER FOUND PIPE. CAP MARKED:

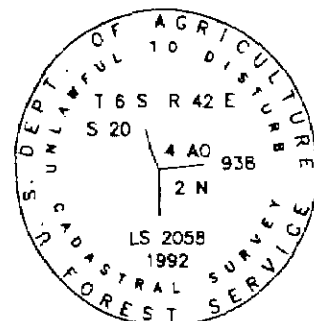

FROM WHICH MS-938 ACCESSORIES:


A PINE, 24" (12") DIAM. BEARS S47°26'E (S50°E), 76.74' (76.9'), BLAZE CLOSED
A PINE, 38" (8") DIAM. BEARS N29°22'W (N25°E), 63.19' (58.3'), BLAZE CLOSED

FROM WHICH LS2058 ACCESSORIES:

A PINE, 10" DIAM. BEARS S19°39'W, 81.23', SCRIBED N2938 BT

Q: CORNER 1 NEGLECTED - MS 938:

FOUND 1 1/4" PIPE IN A 24"x2" MOUND OF STONE. MONUMENT SET 24" IN GROUND AND BURIED FOUND PIPE ALONGSIDE. CAP MARKED:

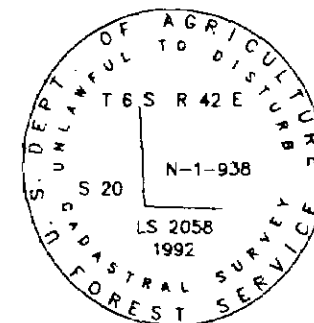

FROM WHICH MS-938 ACCESSORIES:


A PINE, 12" (10") DIAM. BEARS S70°11'W (S68°W), 28.52' (29'), BLAZE CLOSED
A PINE, 10" (8") DIAM. BEARS S86°10'W (S85°W), 20.29' (20.2'), BLAZE CLOSED

FROM WHICH LS2058 ACCESSORIES:

A PINE, 8" DIAM. BEARS S08°05'E, 4.07', SCRIBED N1938BT

**R: CORNER 4 NEGLECTED - MS 938:
CORNER 3 GOLDIE - MS 938:**

NO EVIDENCE OF ORIGINAL MONUMENT FOUND. POSITION ESTABLISHED FROM FOUND ORIGINAL BEARING TREES. SET MONUMENT 6" IN GROUND WITH MOUND OF STONE TO CAP. CAP MARKED:

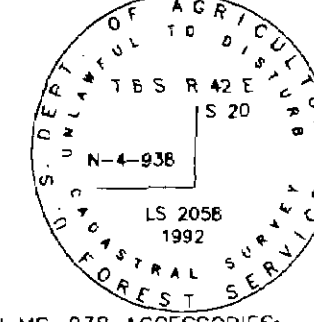

FROM WHICH MS-938 ACCESSORIES:


A FIR STUMP, 21" (24") DIAM. BEARS N24°15'W (N30°W), 12.87' (13.1'), SCRIBED 4N30938BT
A PINE, 15" IN DIAM. BEARS S35°01'E, 23.01', SCRIBED 4N63938 - NOT IN ORIGINAL NOTES.

FROM WHICH LS2058 ACCESSORIES:

A FIR, 10" DIAM. BEARS S63°01'W, 40.36', SCRIBED N4-G3-938BT

S: CORNER 1 LUCKY BREAK - MS 938:

FOUND 1 1/4" PIPE IN A 30"x12" MOUND OF STONE. MONUMENT SET 20" IN GROUND AND BURIED FOUND PIPE TO WEST. CAP MARKED:

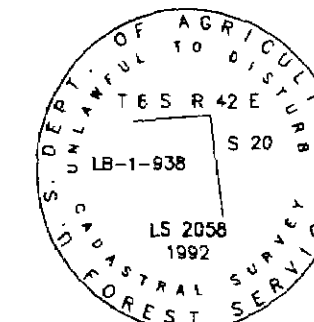


FROM WHICH MS-938 ACCESSORIES:

A PINE, 12" (6") DIAM. BEARS S52°59'W (N65°E), 15.15' (15.5'), BLAZE CLOSED
A PINE, 12" (6") DIAM. BEARS N60°49'E (S55°W), 13.24' (13.5'), BLAZE CLOSED

T: CORNER 2 LUCKY BREAK - MS 938:

FOUND 1 1/4" PIPE IN A 24"x12" MOUND OF STONE. MONUMENT SET 15" IN GROUND AND BURIED FOUND PIPE TO WEST. CAP MARKED:

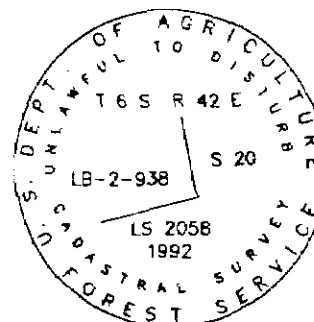


FROM WHICH MS-938 ACCESSORIES:

A PINE, 14" (8") DIAM. BEARS N51°30'E (N56°E), 25.09' (25.2'), BLAZE CLOSED
A PINE, 7" DIAM. BEARS S04°12'E, 32.58'

U: CORNER 3 LUCKY BREAK - MS 938:

FOUND 1 1/4" PIPE IN A 18"x6" MOUND OF STONE. MONUMENT SET 22" IN GROUND AND BURIED FOUND PIPE TO WEST. CAP MARKED:

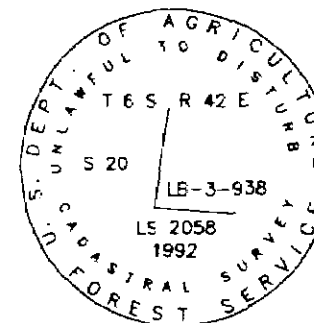

FROM WHICH MS-938 ACCESSORIES:


A PINE STUMP, 16" (18") DIAM. BEARS N34°36'E (N40°E), 6.18' (6.9'), BLAZE OPEN SCRIBED 3LB938BT
A FIR STUMP, 13" (6") DIAM. BEARS S15°51'E (S23°E), 12.98' (13'), BLAZE VISIBLE

FROM WHICH LS2058 ACCESSORIES:

A PINE, 24" DIAM. BEARS N32°52'W, 22.94', SCRIBED LB3938BT
A FIR, 23" DIAM. BEARS S29°45'W, 33.39', SCRIBED LB3938BT

V: CORNER 2 GOLDIE - MS 938:


FOUND 1 1/4" PIPE 2.6' ABOVE GROUND. NO MOUND OF STONE. MONUMENT SET 24" IN GROUND AND BURIED FOUND PIPE TO WEST. CAP MARKED:

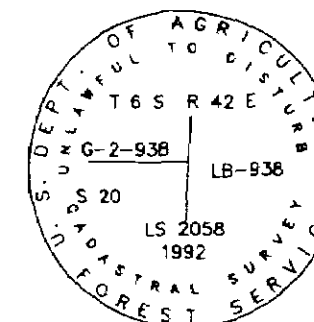

FROM WHICH MS-938 ACCESSORIES:

**W: CORNER 4 LUCKY BREAK - MS 938:
CORNER 3 ZENA BELL - MS 938:**

FOUND 1 1/4" PIPE IN A 24" MOUND OF STONE. MONUMENT SET 24" IN GROUND, BURIED FOUND PIPE ALONGSIDE AND BUILD MOUND OF STONE TO CAP. CAP MARKED:

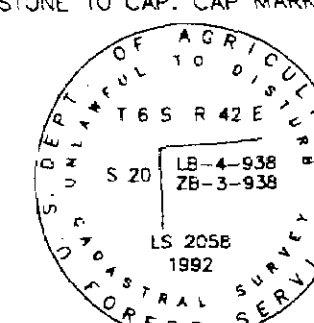


FROM WHICH MS-938 ACCESSORIES:

A FIR, 19" (14") DIAM. BEARS N12°39'W (N15°W), 31.18' (32.7'), BLAZE CLOSED
A FIR, 17" (14") DIAM. BEARS N42°57'E (N70°E), 40.42' (40.8'), BLAZE OPEN - SCRIBING NOT VISIBLE

X: CORNER 3 MORNING - MS 938:

FOUND 1 1/4" PIPE. MONUMENT SET 20" IN GROUND WITH MOUND OF STONE TO CAP. BURIED FOUND PIPE TO WEST. CAP MARKED:

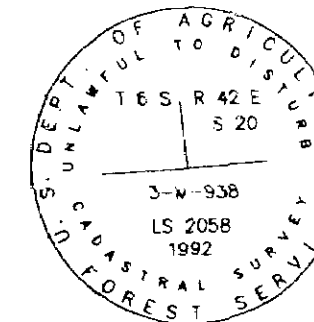

FROM WHICH MS-938 ACCESSORIES:


A PINE STUMP, 10" (12") DIAM. BEARS N08°33'E (N16°E), 7.54' (6.8'), BLAZE OPEN SCRIBED 3M938BT
A PINE STUMP, 16" DIAM. BEARS N44°00'W, 50.61', SCRIBED 3M938BT - NO RECORD ON THIS BT.

FROM WHICH LS2058 ACCESSORIES:

A PINE, 10" DIAM. BEARS S19°27'E, 29.72', SCRIBED 3M938BT
A FIR, 9" DIAM. BEARS N60°14'E, 38.37', SCRIBED 3M938BT

Y: 1/4 CORNER TO SECTIONS 16 & 21:

NO EVIDENCE OF ORIGINAL MONUMENT OR ACCESSORIES FOUND. MONUMENT SET AT PROPORTIONAL POSITION, 24" IN GROUND WITH MOUND OF STONE TO CAP. CAP MARKED:

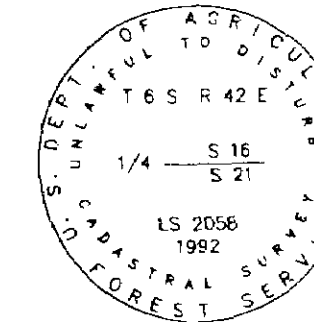


FROM WHICH LS2058 ACCESSORIES:

A FIR, 18" DIAM. BEARS N41°E, 40.64', SCRIBED 1/4S16BT
A TAM, 12" DIAM. BEARS N70°E, 44.38', SCRIBED 1/4S16BT
A FIR, 16" DIAM. BEARS S48°15'E, 68.58', SCRIBED 1/4S21BT
A FIR, 12" DIAM. BEARS S58°45'W, 9.60', SCRIBED 1/4S21BT

Z: CORNER TO SECTIONS 15, 16, 21, & 22:

SET MONUMENT 2" IN GROUND AT LOCATION OF FOUND SMALL MOUND OF STONE. CAP MARKED:

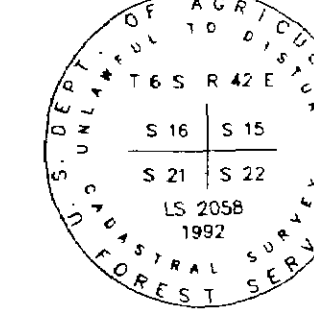

FROM WHICH G.L.O. ACCESSORIES:

A DEAD AND DOWN PINE, 32" DIAM. [10"], BEARS S45°20'W [S47°W], 50.11' [49.5'], SCRIBING NOT VISIBLE
A PINE STUMP, 24" [24"] DIAM. BEARS S65°28'E [S72°E], 134.92' [130.7'], BLAZE NOT VISIBLE
A FIR STUMP, 24" [5"] DIAM. BEARS N28°E [N28°E], 74.6' [74.6']

FROM WHICH LS2058 ACCESSORIES:


A PINE, 11" DIAM. BEARS N38°26'W, 56.97', SCRIBED T6SR42ES16BT
A FIR, 13" DIAM. BEARS S66°22'W, 22.74', SCRIBED T6SR42ES21BT
A PINE, 19" DIAM. BEARS S59°55'E, 60.61', SCRIBED T6SR42ES22BT
A FIR, 18" DIAM. BEARS N28°09'E, 52.96', SCRIBED T6SR42ES15BT

PROFESSIONAL
LAND SURVEYOR
RONALD E. STOLL
2005

RONALD E. STOLL, R.L.S. 2058

AA: 1/4 CORNER TO SECTIONS 21 & 22:

NO EVIDENCE OF ORIGINAL MONUMENT OR ACCESSORIES FOUND. SET MONUMENT 22" IN GROUND AT PROPORTIONAL POSITION WITH MOUND OF STONE TO CAP. CAP MARKED:

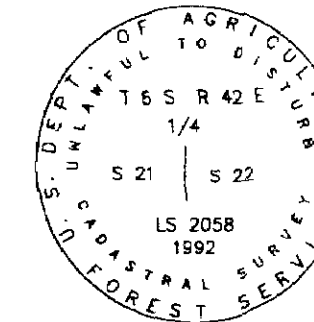


FROM WHICH LS2058 ACCESSORIES:

A PINE, 12" DIAM. BEARS N35°25'W, 33.56', SCRIBED 1/4S21BT
A PINE, 8" DIAM. BEARS N71°00'E, 30.37', SCRIBED 1/4S22BT
A PINE, 14" DIAM. BEARS S39°15'E, 58.51', SCRIBED 1/4S22BT
A PINE, 12" DIAM. BEARS S37°00'W, 50.80', SCRIBED 1/4S21BT

BB: CORNER TO SECTIONS 21, 22, 27, & 28:

NO EVIDENCE OF ORIGINAL MONUMENT FOUND. SET MONUMENT 20" IN GROUND AT INTERSECTION RECORD DISTANCES FROM ORIGINAL BEARING TREES TO NORTHWEST AND SOUTHWEST. CAP MARKED:

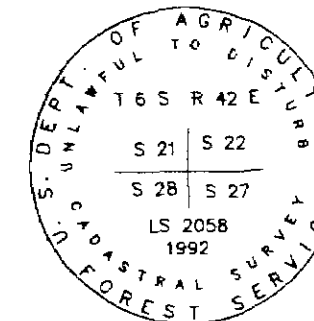


FROM WHICH G.L.O. ACCESSORIES:

A PINE, 17" DIAM. BEARS N10°02'W, 44.79', CLOSED BLAZE
A PINE, 12" [6"] DIAM., BEARS N28°36'E [N23°E], 28.05' [28.4'], BLAZE VISIBLE AND OPEN
A PINE 18" [12"] DIAM. BEARS S58°51'W [S70°W], 12.14' [12.5'], BLAZE OPEN BUT ILLIGIBLE
FROM WHICH LS2058 ACCESSORIES:
A PINE, 13" DIAM. BEARS S60°44'E, 31.38', SCRIBED T6SR42ES27BT

CC: 1/4 CORNER TO SECTIONS 21 & 28:

NO EVIDENCE OF ORIGINAL MONUMENT FOUND. SET MONUMENT 20" IN GROUND AT PROPORTIONAL POSITION, WITH MOUND OF STONE TO CAP.

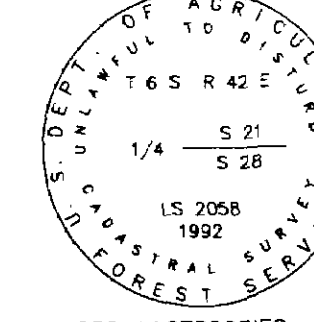


FROM WHICH LS2058 ACCESSORIES:

A TAM, 10" DIAM. BEARS N45°02'W, 11.42', SCRIBED 1/4S21BT
A FIR, 6" DIAM. BEARS S78°45'W, 19.38', SCRIBED 1/4S28BT
A TAM, 6" DIAM. BEARS S19°37'E, 12.65', SCRIBED 1/4S28BT
A TAM, 9" DIAM. BEARS N63°20'E, 6.03', SCRIBED 1/4S21BT

DD: CENTER 1/4 CORNER TO SECTION 21:

SET MONUMENT 18" IN GROUND WITH MOUND OF STONE TO CAP. CAP MARKED:

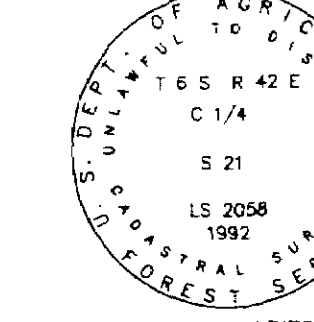

FROM WHICH LS2058 ACCESSORIES:

A TAM, 21" DIAM. BEARS N14°59'W, 79.60', SCRIBED C1/4S21BT
A TAM, 22" DIAM. BEARS N07°02'E, 14.47', SCRIBED C1/4S21BT
A PINE, 14" DIAM. BEARS S19°37'E, 45.90', SCRIBED C1/4S21BT
A PINE, 15" DIAM. BEARS S71°30'W, 62.08', SCRIBED C1/4S21BT

JOB NO. 1210-691-OR
CONTRACT NO. 53-04M3-1-0113
SHEET 5 OF 5

NOTES

BEARINGS TO BEARING TREES WERE TAKEN TO A NAIL AND BRASS TAG, MARKED LS 2058, PLACED AT THE BASE OF THE FRONT FACE OF THE TREE OR ABOVE THE "B" IN "BT" IN THE BLAZE. DISTANCES WERE TAKEN TO 16d GALVANIZED NAIL IN THE SIDE CENTER BASE OF THE BEARING TREES.
MONUMENT = A 3" DIAM. U.S.F.S. ALUMINUM CAPPED PIPE, 30" LONG, WITH MAGNET
[] RECORD BEARING AND/OR DISTANCE, G-L-O, 1883
() RECORD BEARING AND/OR DISTANCE, MS 938, 1955
{ } RECORD BEARING AND/OR DISTANCE, LS1206

A PORTION OF
SECTIONS 20 AND 21
T 6 S R 42 E W.M.
UNION COUNTY, OREGON
RECORD OF SURVEY
RES LAND SURVEYS, INC. 8335 PLACITA DADIVOSO TUCSON, ARIZONA 85704