


# SECTION 26, T1N R40E

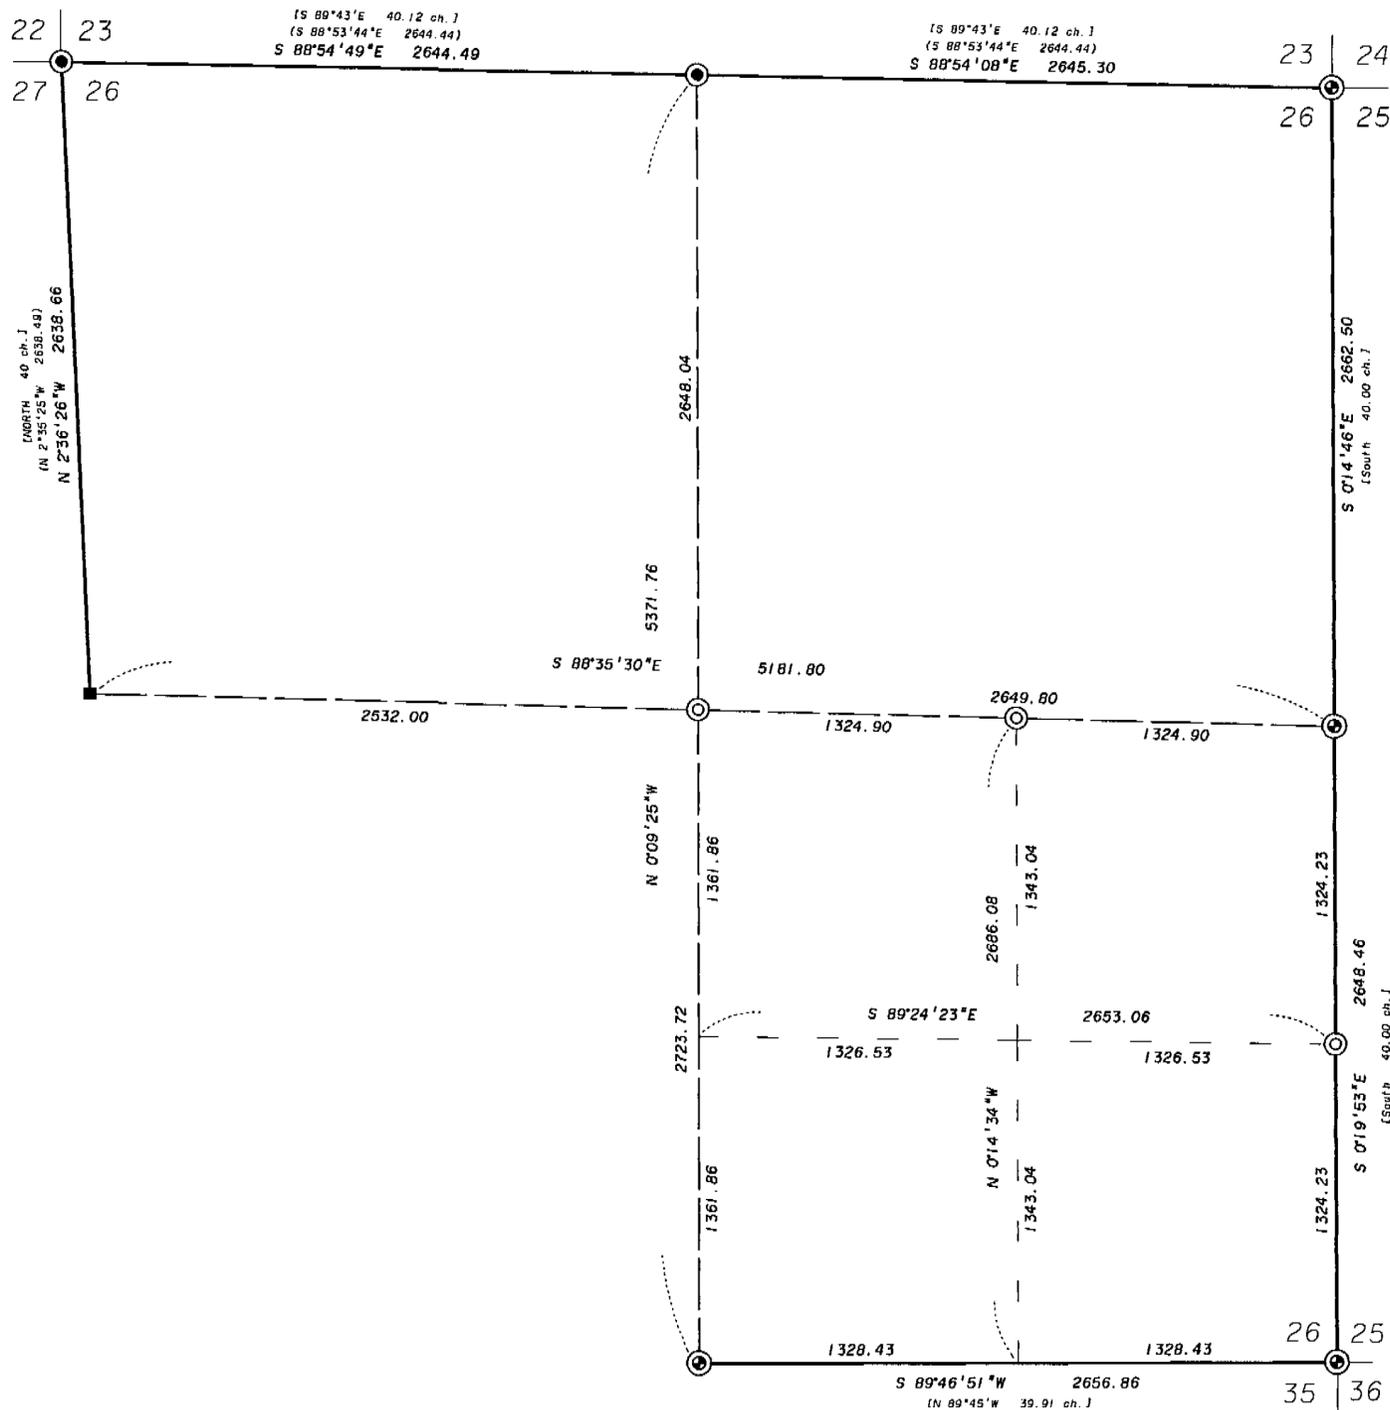

## BASIS OF BEARING

Solar observations taken at a point 536 feet South and 1556 feet West of the Northwest corner of Section 26, Township 1 North, Range 40 East of the Willamette Meridian.



## LEGEND

- ⊙ Set 2 1/2" x 30" aluminum pipe monument. See monumentation sheets filed separately.
- Found 2 1/2" aluminum pipe monument as per survey 049-1992. See monumentation sheets filed separately.
- Found 60d nail believed to be from survey 049-1992 in mound of stone at ancient 4-way fence corner.
- ⊕ Found Union County Surveyor 2 1/2" aluminum pipe monument. See monumentation sheets filed separately.
- ( ) Record information from survey 049-1992.
- [ ] Record information from GLO survey.

## NARRATIVE

This survey was ordered by Steve Guernsey on behalf of Boise Cascade Corporation and Billy Hindman. Mr. Guernsey instructed me to place the Center 1/4 corner, South 1/4 corner, and the Center East 1/16 corner all in Section 26. Also the South 1/16 corner on the East line of Section 26. The Northeast corner, East 1/4 corner, Southeast corner, and the South 1/4 corner of Section 26 have all been placed from original GLO evidence. The North 1/4 corner and the Northwest corner have been placed by proportionate measurement by survey 049-1992. The ancient 4-way fence corner at the West 1/4 corner used for the proportion at the Northwest section corner by survey 049-1992 was also used by me in the subdivision of this section. Using the controlling monuments on the exterior lines of Section 26 the subdivision of the Southeast one-quarter of this section was done in the standard manner as prescribed by the 1973 Manual of Surveying Instructions.

REGISTERED  
PROFESSIONAL  
LAND SURVEYOR  
*Jeffery P. Petersen*  
OREGON  
JULY 20, 1995  
JEFFERY P. PETERSEN  
2625  
Renewal Date: Dec. 31, 1998

## REFERENCE MATERIAL

Original GLO Survey by William H. Odell under joint contract with Joseph G. Gray, contract no. 120, dated May 27, 1867.  
Union County Survey 049-1992  
Union County Monumentation Records

UNION COUNTY  
SURVEYOR  
Date Received 6-1-95  
Date Filed 6-1-95  
By *[Signature]*  
File No. 017-1995

BAGETT, GRIFFITH & BLACKMAN 2006 Adams Avenue, LaGrande, Oregon Map of Survey		
Subdivisional break of Section 26, Township 1 North, Range 40 East of the Willamette Meridian.		
Union County		
SURVEYED FOR	Boise Cascade Corp. - Billy Hindman	
SURVEYED BY	JPP	5-95
Scale: 1" = 500'	Drawn by: JPP	5-95