

NARRATIVE


This survey for Connie Johnson is for purpose of marking on the ground the corners of her property in Block 18, North Powder, Oregon. The property consists of two tax lots in the North half of block. Lots 1,2,3 and 4, and Lots 5,6,7 and 8, comprise separate units.

Previously recovered original or reestablished monumentation, a 1 1/2 inch square iron pin at 3 rd and "C" Streets (now marked on ground surface with a bridge spike), a 1 inch square iron pin at 3 rd and "E" (now marked with a 2 1/2 inch brass cap PLS 1051) 5/8 inch rebar at 2 nd and "B" and 2 nd and "A" are basis of this survey using record bearing of N. 52° 07' E. on centerline of 2 nd street.

Set 3 rd and "A" Intersection monument N. 37° 47' 40" W., 400.23 feet from 2 nd and "A" intersection and S. 52° 07' W., 443.8 feet from 3 rd street centerline intersection with Easterly line of townsite.

LEGEND

- ⊙ Set 5/8" rebar no cap
- Set 5/8" X 30" rebar with plastic cap marked "HANLEY ENGR. PLS 1206."
- Found 5/8" rebar or as noted.

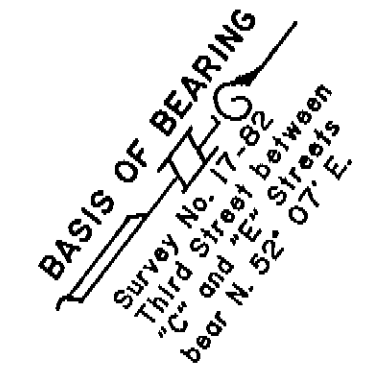

No monument. Location from previous surveys of record along 2nd St.

**MAP OF SURVEY
IN NORTH POWDER, OREGON**
 Surveyed March 2, and Dec. 22, 1995
 For Connie Johnson
 SCALE: 1" = 50'

**UNION COUNTY
SURVEYOR**

Date Received 1-24-96
 Date Filed 1-25-96
 By R. ROBINSON, DEPUTY
 File No. 004-1996


**REGISTERED
PROFESSIONAL
LAND SURVEYOR**

James D. Hanley

OREGON
 SEPTEMBER 21, 1917
 JAMES D. HANLEY
 1206

HANLEY ENGINEERING
 2043 MAIN STREET
 BAKER CITY, OREGON

Renews Jan. 1, 1998

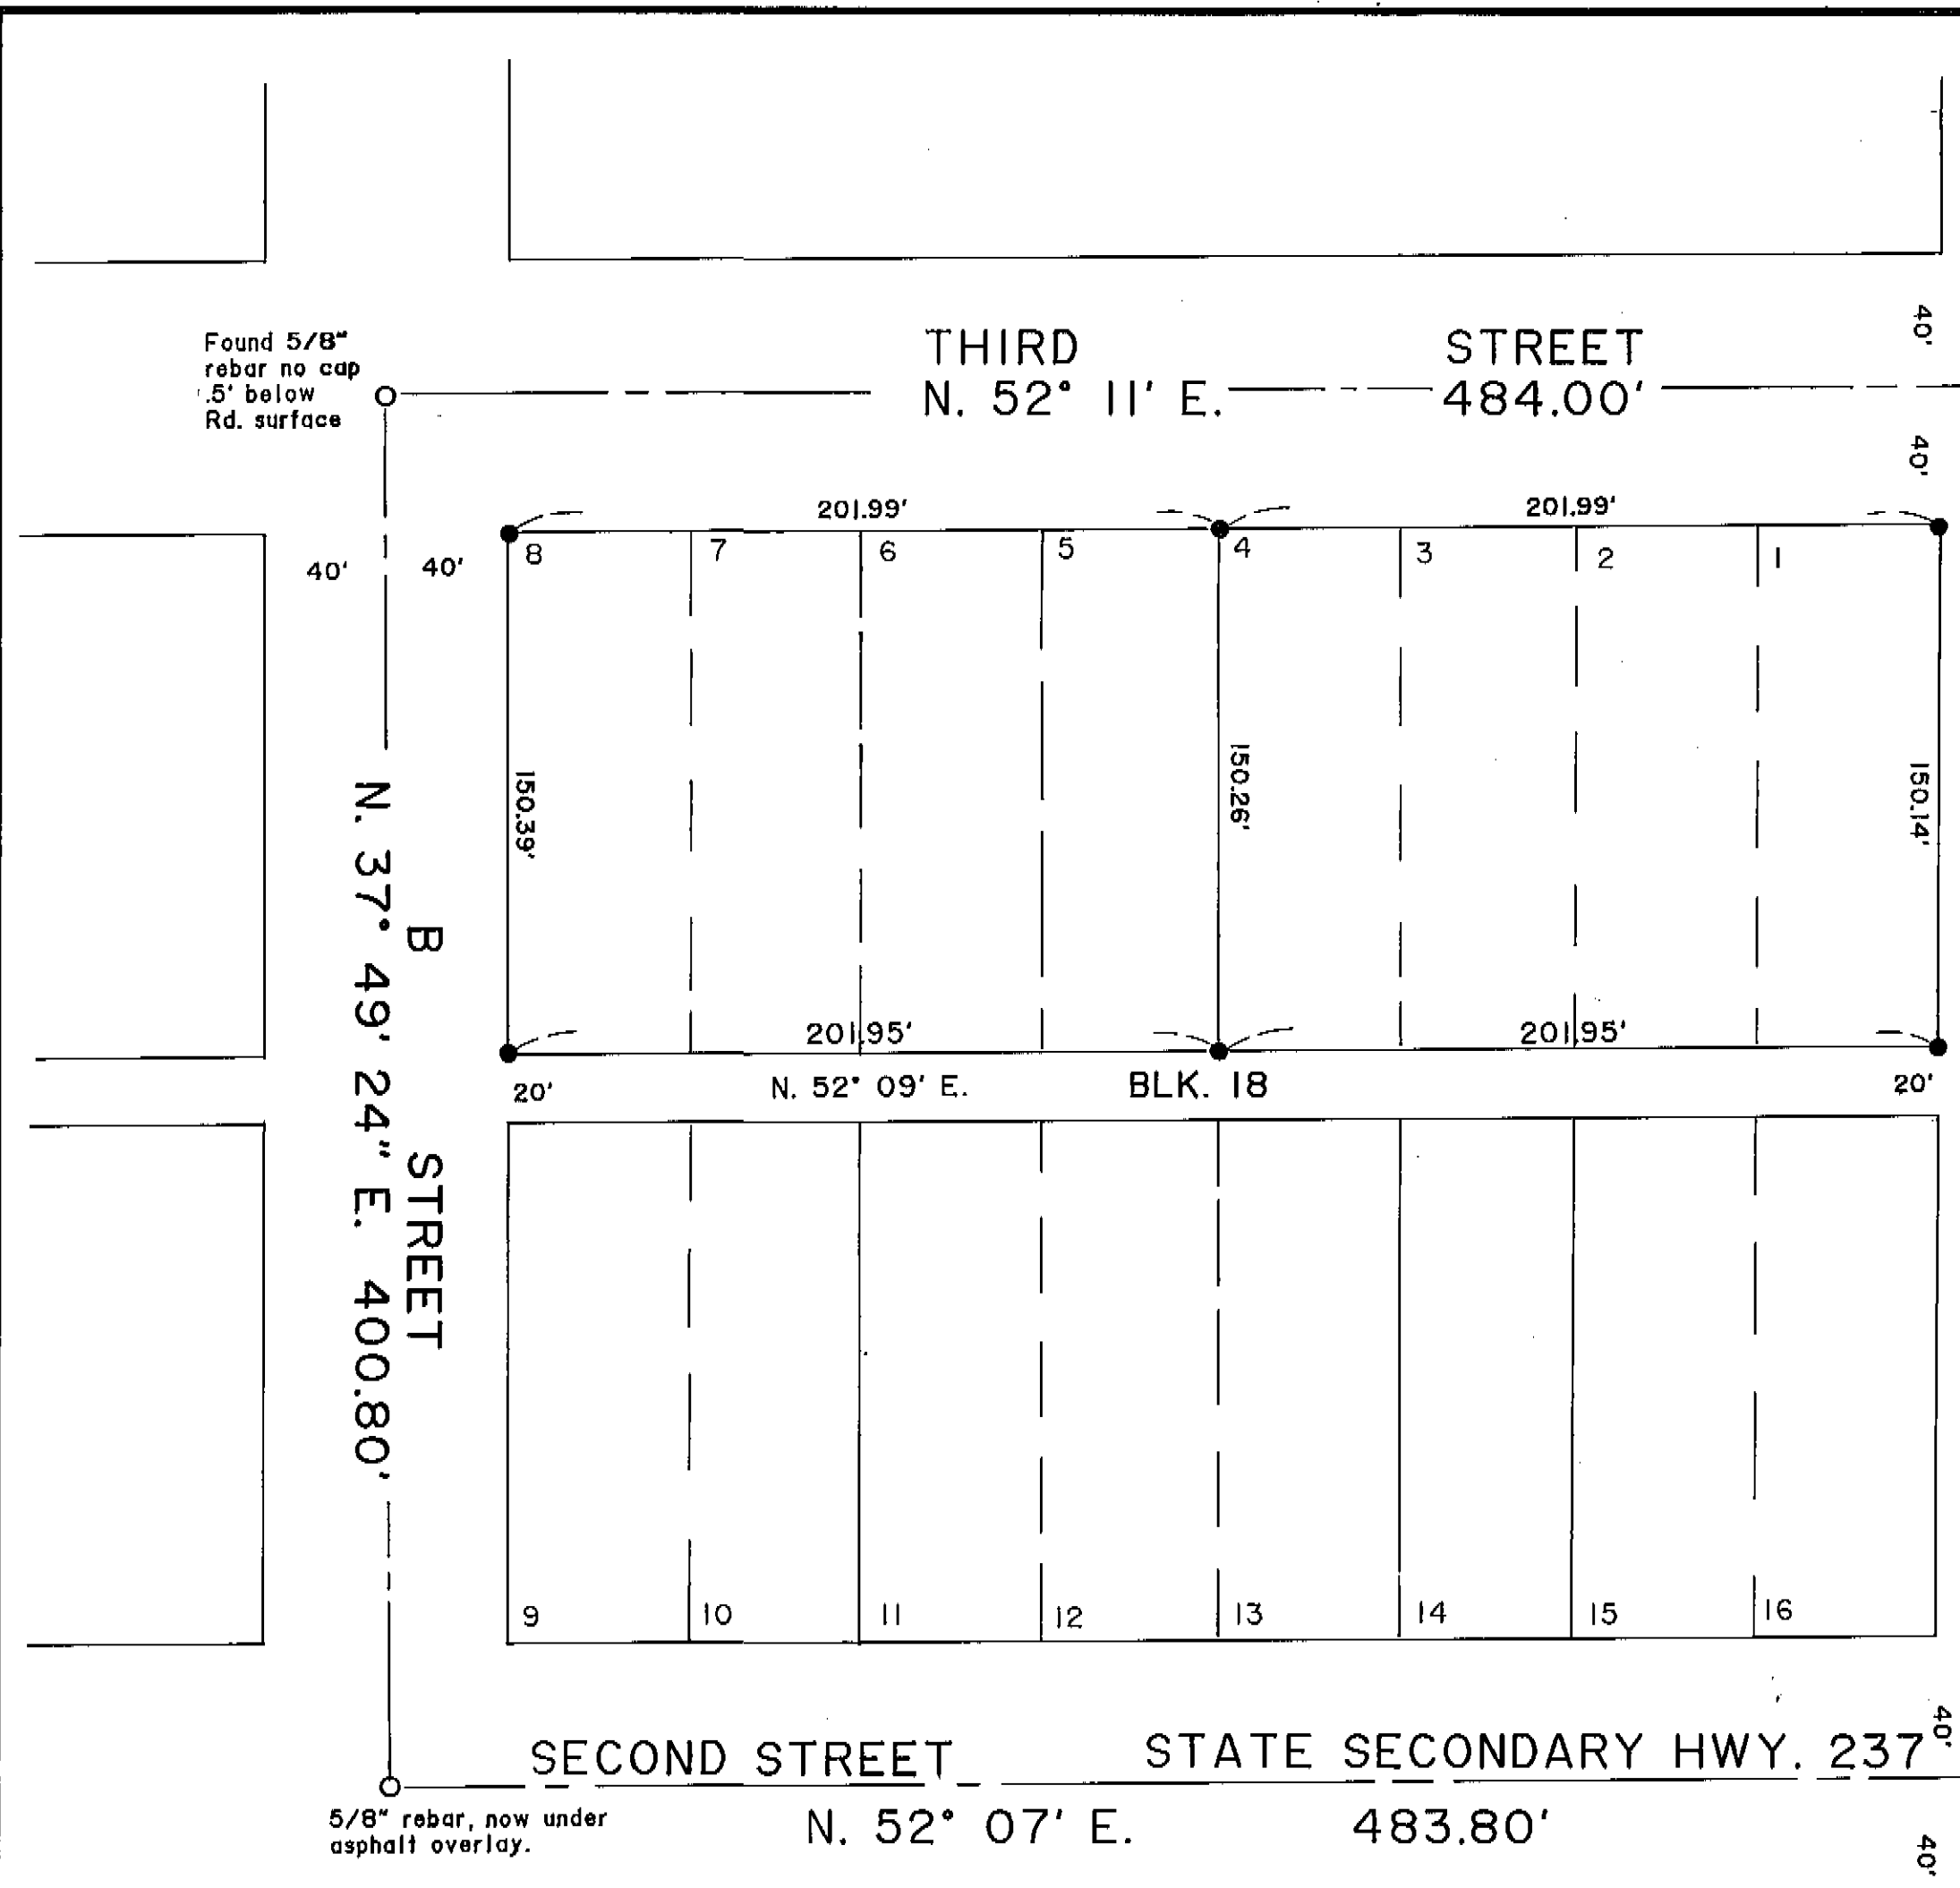

Found 5/8" rebar no cap .5' below Rd. surface

Set 5/8" rebar no cap .3' below Rd. surface.

5/8" rebar, now under asphalt overlay.