BASIS OF BEARING

Solar observation taken at a point 1247.40 feet North and 2644.07 feet West of the Southwest corner of Section 4, Township 1 South, Range 40 East of the Willamette Meridian

SCALE: 1"=500'

LEGEND

- or or — Found 2 1/2" brass cap monument set by survey number 32-80
- or — Found 2 1/2" aluminum monument as per Union County Monumentation records
- or — Set 2 1/2" aluminum monument at position determined by survey
- (( )) — Record information of GLO contract No. 102
- ( ) — Record information of GLO contract No. 450
- [ ] — Record information survey number 32-80
- —— x —— — Barb wire fence
- Gravel road
- Boise Cascade Property line

NARRATIVE

This survey was done at the request of Steve Gurnsey, on behalf of Boise Cascade Corporation, to determine the positions of the Center 1/4 and the Center North 1/16 of Section 4. In locating the controlling corners for the subdivision of this section, I found the monument marking the North 1/16th corner between Sections 3 and 4 to be away from the true proportionate position as shown. The dimensions shown on survey number 32-80 do match the true position much more closely. Line was posted along the North property line between the Center North 1/16 and the North 1/16 of Section 4 in the vicinity of the Laird home to determine if an encroachment existed. No permanent structures were found to be encroaching in this survey, as shown in the detail below. I find no other unusual conditions on this survey.

REFERENCE MATERIAL

Original GLO Contract Number 102 by Timothy W. Davenport, dated July 20th, 1863
Original GLO Contract Number 450 by Henry Meldrum, dated December 1st, 1882
Union County monumentation records
Survey Number 032-1980
Survey Number 066-1974

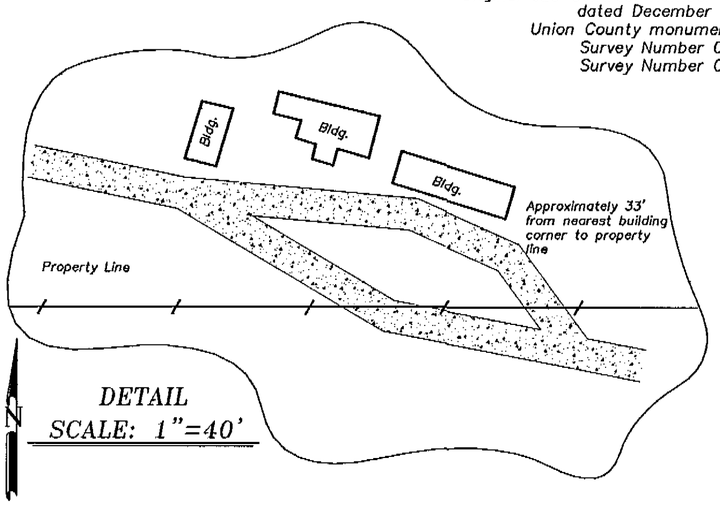

DETAIL
SCALE: 1"=40'

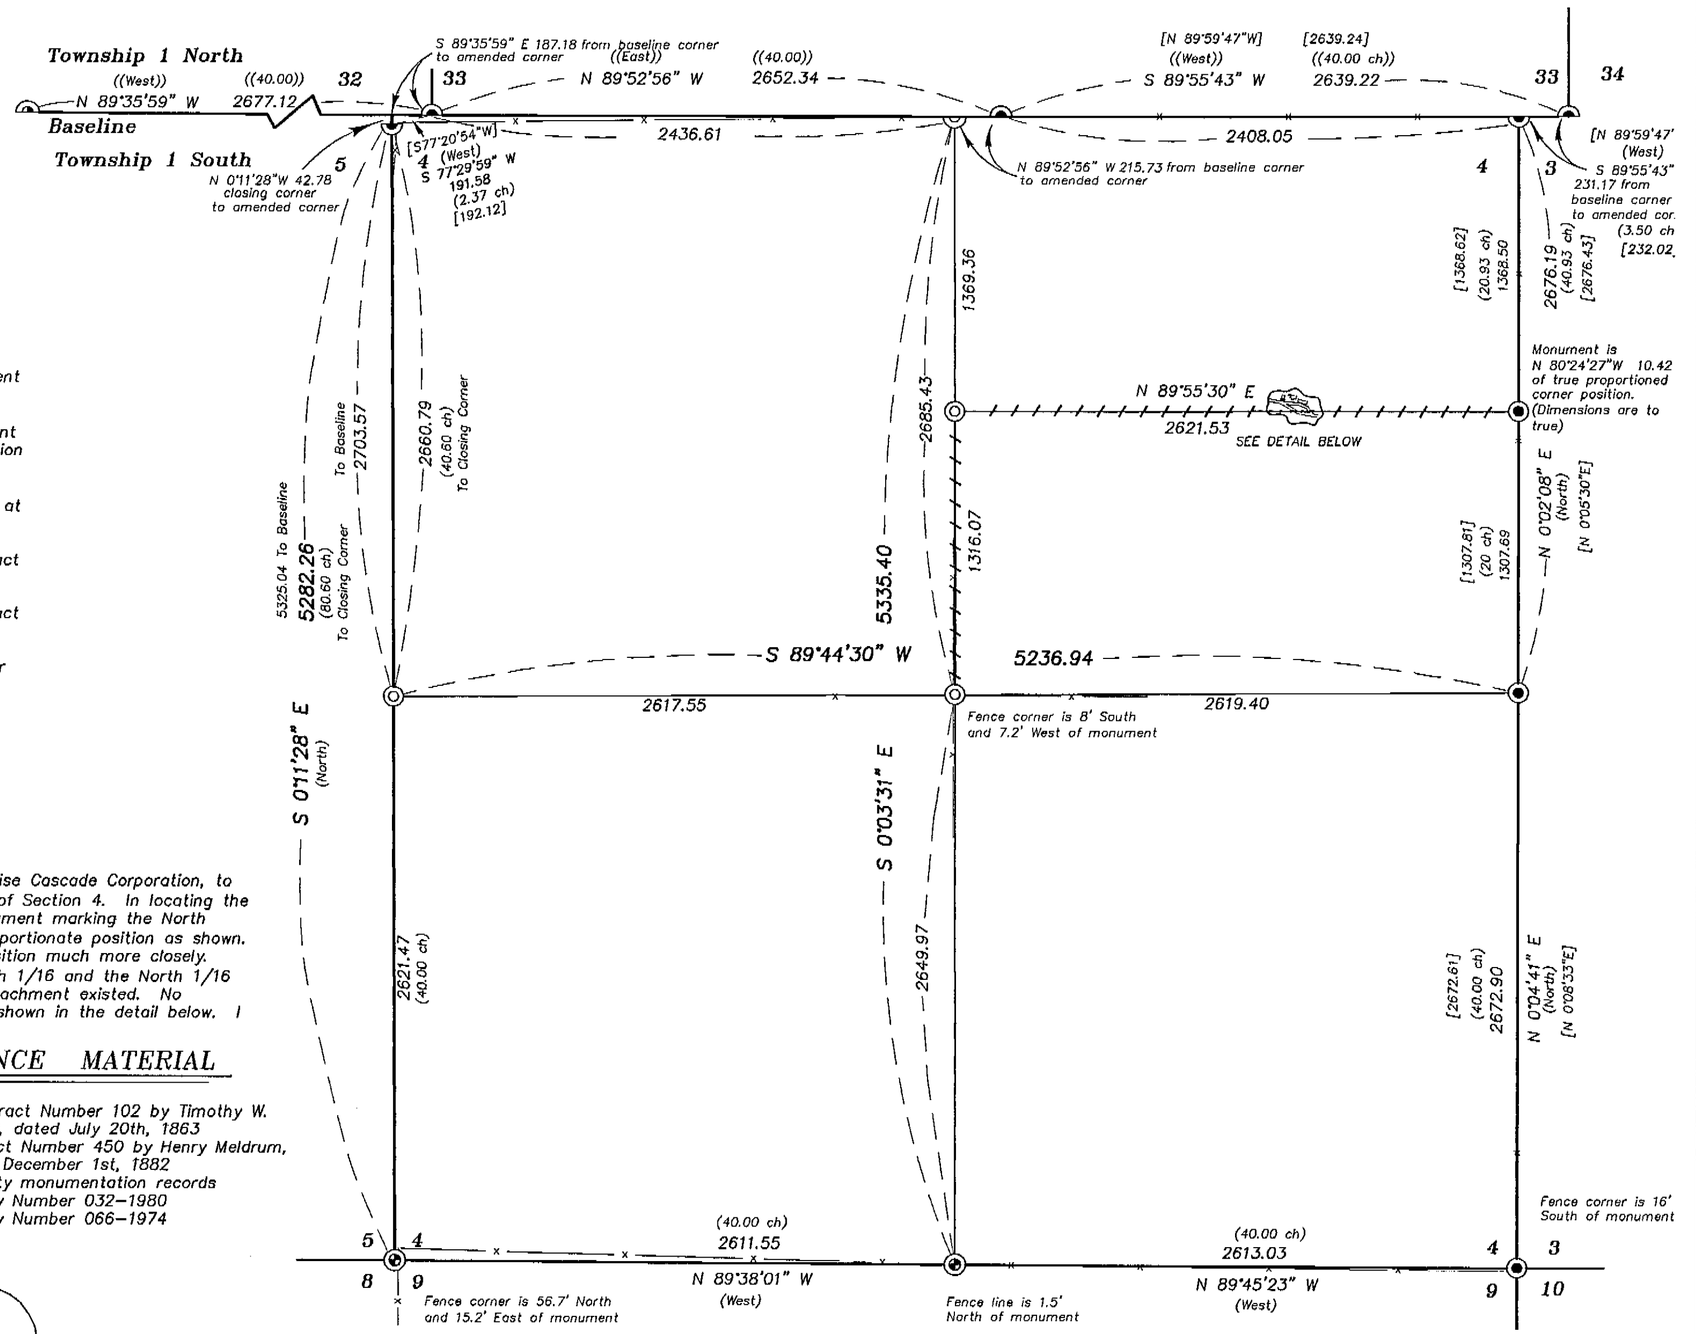

DEED REFERENCES

Volume 141 Page 160
Microfilm Number 82309
Microfilm Number 85460
Microfilm Number 85508
Microfilm Number 114685
Microfilm Number 130739
Microfilm Number 134561
Microfilm Number 142485
Microfilm Number 142610
Microfilm Number 158193
Microfilm Number 965116

REGISTERED PROFESSIONAL LAND SURVEYOR
Rick G. Robinson
OREGON JULY 17, 1986 RICK G. ROBINSON 2219
Renewal Date: Dec. 31, 2000

UNION COUNTY SURVEYOR
Date Received 9/2/98
Date Filed 9/26/98
By Lynda T. Hoke
File No. 033-1998

BAGETT, GRIFFITH & BLACKMAN
2006 Adams Avenue, LaGrande, Oregon

Map of Survey

Subdivision of Section 4, Township 1 South, Range 40 East of the Willamette Meridian
UNION COUNTY, OREGON

SURVEYED FOR	Boise Cascade Corporation	
SURVEYED BY	R. G. R.	9/98
Scale: 1" = 500'	Drawn by: N. W. V.	9/98

SURVEY NUMBER 033-1998