
THE CENTERLINE INTERSECTION WAS ESTABLISHED AT A LINE-LINE INSECTION BETWEEN REFERENCE MARKS, FOUND 5/8" IRON ROD WITNESS CORNER C.5. 18-89 (0.90 NORTH OF LOT CORNER) 0.03 NORTH OF AND 0.17 EAST OF CALCULATED POSITION, PER C.5. 52-74. SPRING STREET 300.33 EAST 299.92 EAST #0.00 #0# (300.33 EAST) {300} (299.92 EAST) [300] 219.92 EAST 40.00 40.00 40.00 40.00 109.96 ((109.96)) {110} 109.96 ((109.96)) {110} *{40}* 1401 B Ĺ FOUND 5/8" IRON ROD 0.03' 50UTH OF AND 0 2 O.15' EAST OF RECORD POSITION PER C.S. 27-71 8 Q 3 NO.00'30'E) $L\Lambda J$ 589°59'30"E 40.00 FOUND 5/8" IRON ROD PER C.S. 27-71 4 ن 0 Ш SEE DETAIL I Ш 109.97 EAST {110} / 00'30" '30" W) H U Ш SEE NOTE I FOUND 5/8" IRON ROD 50.00 NO 00 30 E 5 50.00 50°00'06"E Q 0.06' NORTH OF AND - {50} - *150*} 0.06' EAST OF RECORD POSITION PER C.S. 83-79 5 109.97 WEST {110} 90 6 0 0 110.00 110.00 220.00 EAST

300.00 EAST {300}

DETAILS:

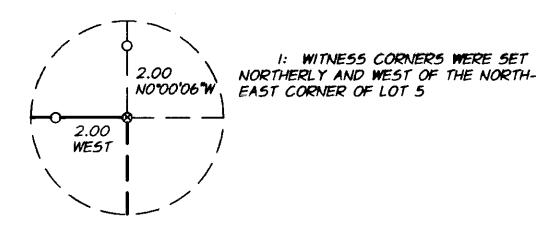

PENN STREET

300.33 N 89° 58' 00" W

(300.33 N89" 58' 00"W) (300)

NOTES:

I: A FENCE CORNER, ATTACHED TO LOT FOUR, EN-CROACHES ONTO LOT FIVE 1.2 FEET SOUTH OF THE PRO-PERTY LINE AT 17.0 FEET EAST OF THE NORTHWEST COR-NER OF LOT 5. THE EASTERLY CORNER OF SAME FENCE ENCROACHES 0.5 FEET SOUTH OF THE PROPERTY LINE AT 1.3 FEET WEST OF THE NOTHEAST CORNER OF LOT 5.

LEGEND

- O SET 5/B INCH IRON ROD WITH YELLOW PLASTIC CAP MARKED "APA"
- FOUND MONUMENT OF RECORD AS NOTED
- FOUND LEAD PLUGS WITH BRASS SCREW SET AS REFER-ENCE MARKS TO THE CENTERLINE INTERSECTION OF SPRING AVENUE AND OAK STREET, C.S. 18-89
- & CALCULATED POSITION, MONUMENT NEITHER SET NOR FOUND
- (XX) RECORD MEASUREMENT, C.S. 83-79
- ((XX)) RECORD MEASUREMENT, C.S. 52-74
- XXX RECORD MEASUREMENT, ROMIG'S ADDITION

REFERENCES

C.5. 83-79 C.5. 18-89 C.5. 27-66 C.5. 52-74 C.5. 27-71 ROMIG'S ADDITION TO THE CITY OF LA GRANDE

NARRATIVE


THIS SURVEY WAS PERFORMED AT THE REQUEST OF ZELL STAHL TO MONU-MENT THE NORTH LINE OF LOT 5, BLOCK 4, ROMIG'S ADDITION TO THE CITY OF LA GRANDE AND TO NOTE THE ENCROACHMENT OF A FENCE ACROSS SUCH LINE.

THE CENTERLINE INTERSECTION OF SPRING AVENUE AND OAK STREET WAS CALCULATED BY A LINE-LINE INTERSECTION OF FOUR FOUND LEAD PLUGS IN THE CURBS OF THIS INTERSECTION, PER C.S. 18-89 AND C.S. 52-74. THE CENTERLINE OF OAK STREET WAS ESTABLISHED FROM SAID CENTERLINE INTERSECTION AND A 40.00 FOOT OFFSET FROM A FOUND 5/8 INCH IRON ROD, PER C.S. 27-71. THE CENTERLINE OF OAK STREET, PER C.S. 83-79, WAS HELD AS THE BASIS OF BEARING AND IT'S LENGTH FROM SPRING AVENUE TO PENN AVENUE WAS HELD TO CONTROL THE WEST LINE OF BLOCK 4, ALSO PER C.S. 83-79. THE CENTERLINES OF SPRING AND PENN AVENUES WAS EXTENDED DUE EAST FROM THE ENDS OF THIS SEGMENT OF OAK STREET CONTAINED BETWEEN THESE TWO AVENUES.

THE NORTHWEST AND SOUTHWEST BLOCK CORNERS OF BLOCK 4 WERE CAL-CULLED AT 40.00 FOOT OFFSETS FROM THE CENTERLINES OF OAK STREET AND SPRING AND PENN AVENUES. THE NORTH-SOUTH CENTERLINE OF THE BLOCK WAS ESTABLISHED BETWEEN THE MIDPOINT OF THE NORTH LINE OF THE BLOCK PER C.S. 52-74, AND THE MIDPOINT OF THE SOUTH LINE OF THE BLOCK, HELD TO BE RECORD DISTANCE PER "ROMIG'S ADDITION. THE NORTHEAST AND SOUTH-EAST CORNERS OF THE BLOCK WERE HELD AT THE ENDS OF SAID NORTH AND SOUTH BLOCK LINES.

THE BLOCK CORNERS ALONG THE WEST LINE, THE NORTH-SOUTH CENTERLINE AND THE EAST LINE OF THE BLOCK WERE CALCULATED AT PROPORTIONED DISTANCES PER "ROMIG'S ADDITION."

THE WORK WAS PERFORMED WITH A LEICA TIGIO THEODOLITE, A WILD DI-TIGOO DISTANCE INSTRUMENT AND A SOKKIA SDR33 DATA COLLECTOR.

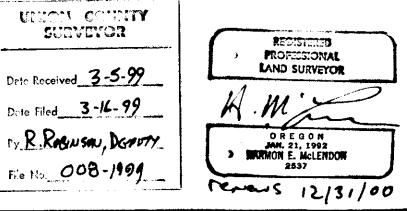

MAP OF SURVEY, THE NORTH LINE OF LOT 5, BLOCK 4, ROMIG'S ADDITION TO THE CITY OF LA GRANDE, SE 1/4 OF SEC. 6, T. 3 S., R. 38 E., W.M., UNION COUNTY, OREGON

for: ZELL STAHL

SCALE:

1" = 50'

DATE:

FEB 1999

JOB NO.

2721-50

anderson perty sociales, inc.

LA GRANDE, OR. WALLA WALLA, WA. BAKER CITY, OF

.....

SHEET