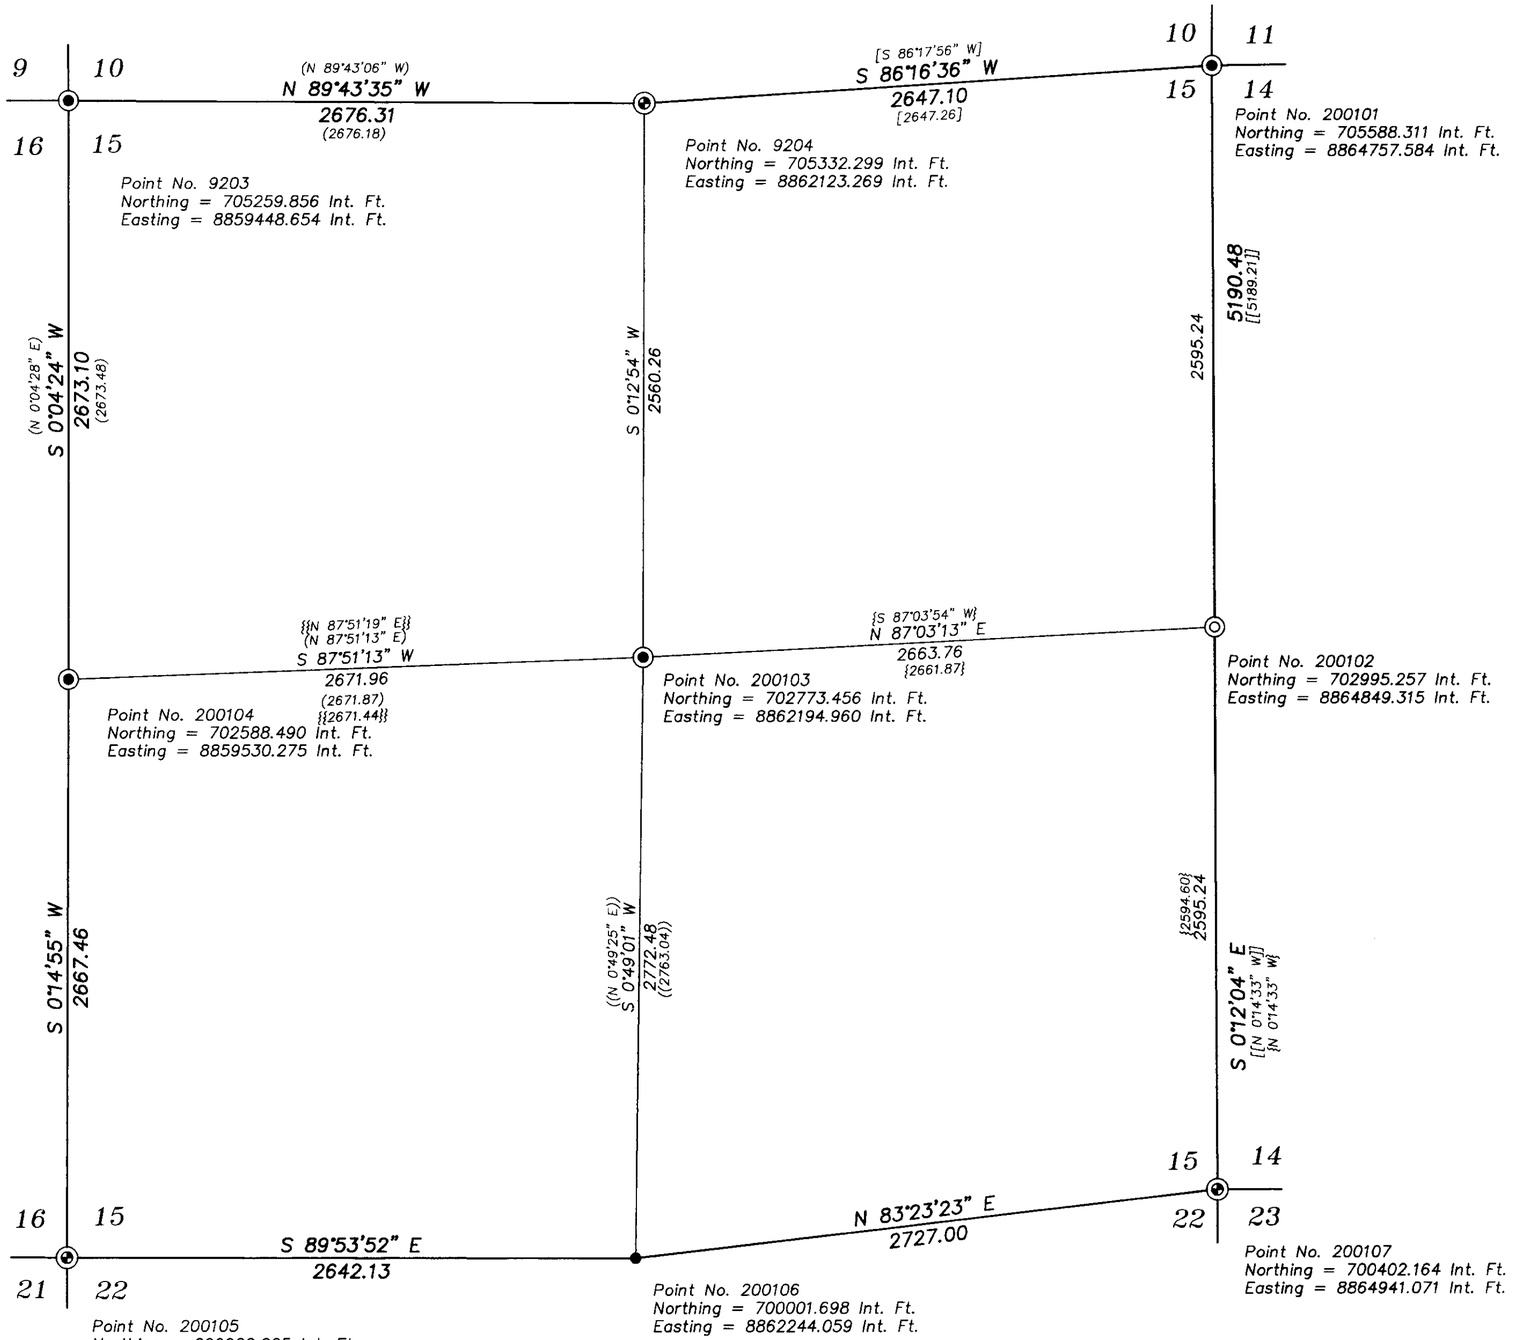

BASIS OF BEARING

Solar observation taken at the North quarter corner of Section 15, Township 1 North, Range 40 East of the Willamette Meridian.

SCALE: 1"=500'

LEGEND

●	Found 1" iron pin in concrete as per Survey No. 2–74
⊛	Found 2 1/2" brass cap as per Union County Monumentation Records
◉	Found 2 1/2" aluminum cap monument as per Union County Monumentation Records
◎	Set 2 1/2" aluminum cap monument at position determined by Survey
( )	Record measurement Survey No. 25–74
(( ))	Record measurement Survey No. 5–76
[ ]	Record measurement Survey No. 35–78
[[ ]]	Record measurement Survey No. 9–86
{ }	Record measurement Survey No. 6–2000
{{ }}	Record measurement Survey No. 33–2000

Point No. 200107
Northing = 700402.164 State Plane Coordinate
Easting = 8864941.071

NARRATIVE

This survey was performed at the request of the Union County Assessor in preparation for GPS observations on the corners of this section. The East quarter was monumented at the proportionate position. There was an error in the coordinate of the Northeast corner of Section 15. This erroneous coordinate was used for Survey Nos. 9–86 and 6–2000. Survey No. 039–1993 shows the correct position used on this survey. I have shown the GPS coordinate positions for each corner. These coordinates do not relate to the bearings and distances on this map. To reduce GPS coordinates shown us scale factor and convergence angle on GPS Info Sheets filed separately. There are no other problems with this survey.

REFERENCE MATERIAL

UNION COUNTY MONUMENTATION RECORDS

UNION COUNTY SURVEYS
Survey 156
Survey No. 31–72
Survey No. 2–74
Survey No. 25–74
Survey No. 5–76
Survey No. 35–78
Survey No. 9–86
Survey No. 007–1999
Survey No. 006–2000
Survey No. 33–2000

NOTES

Coordinates shown are GPS positions in the NAD83(91), OREGON NORTH ZONE 3601. The bearings and distances shown are on a local coordinate system.

For monumentation information see Monumentation Record filed separately

For GPS Info Sheet, see UCS GPS book in UCS office

UNION COUNTY SURVEYOR
Date Received 2/13/2001
Date Filed 3/2/01
By R. Robinson, Deputy
File No. 001–2001

REGISTERED PROFESSIONAL LAND SURVEYOR
OREGON JULY 13, 1973
GREGORY T. BLACKMAN 991
Renewal Date: Dec. 31, 2001

BAGETT, GRIFFITH & BLACKMAN
2006 Adams Avenue, LaGrande, Oregon
Map of Survey

Section 15, Township 1 North, Range 39 East of the Willamette Meridian

UNION COUNTY, OREGON

SURVEYED FOR	UNION COUNTY SURVEYOR	
SURVEYED BY	G.T.B.	2/13/01
Scale: 1" = 500'	Drawn by: N.W.V.	2/13/01

SURVEY NO. 001–2001