GRAPHIC SCALE

1000 0 500 1000 2000 4000

(IN FEET)
1 inch = 1000 ft.

SCALE FACTORS

Elevation Scale Factor = .99986621655
Projection Scale Factor = .9998994119
Combined Scale Factor = .99976564192

BASIS OF BEARING

Bearing as determined by using published NAD83(91) coordinates between GPS control points △9603 and △9614

SCALE: 1"=1000

DATUM

NGVD 29 (elevations determined using GEOID 99)

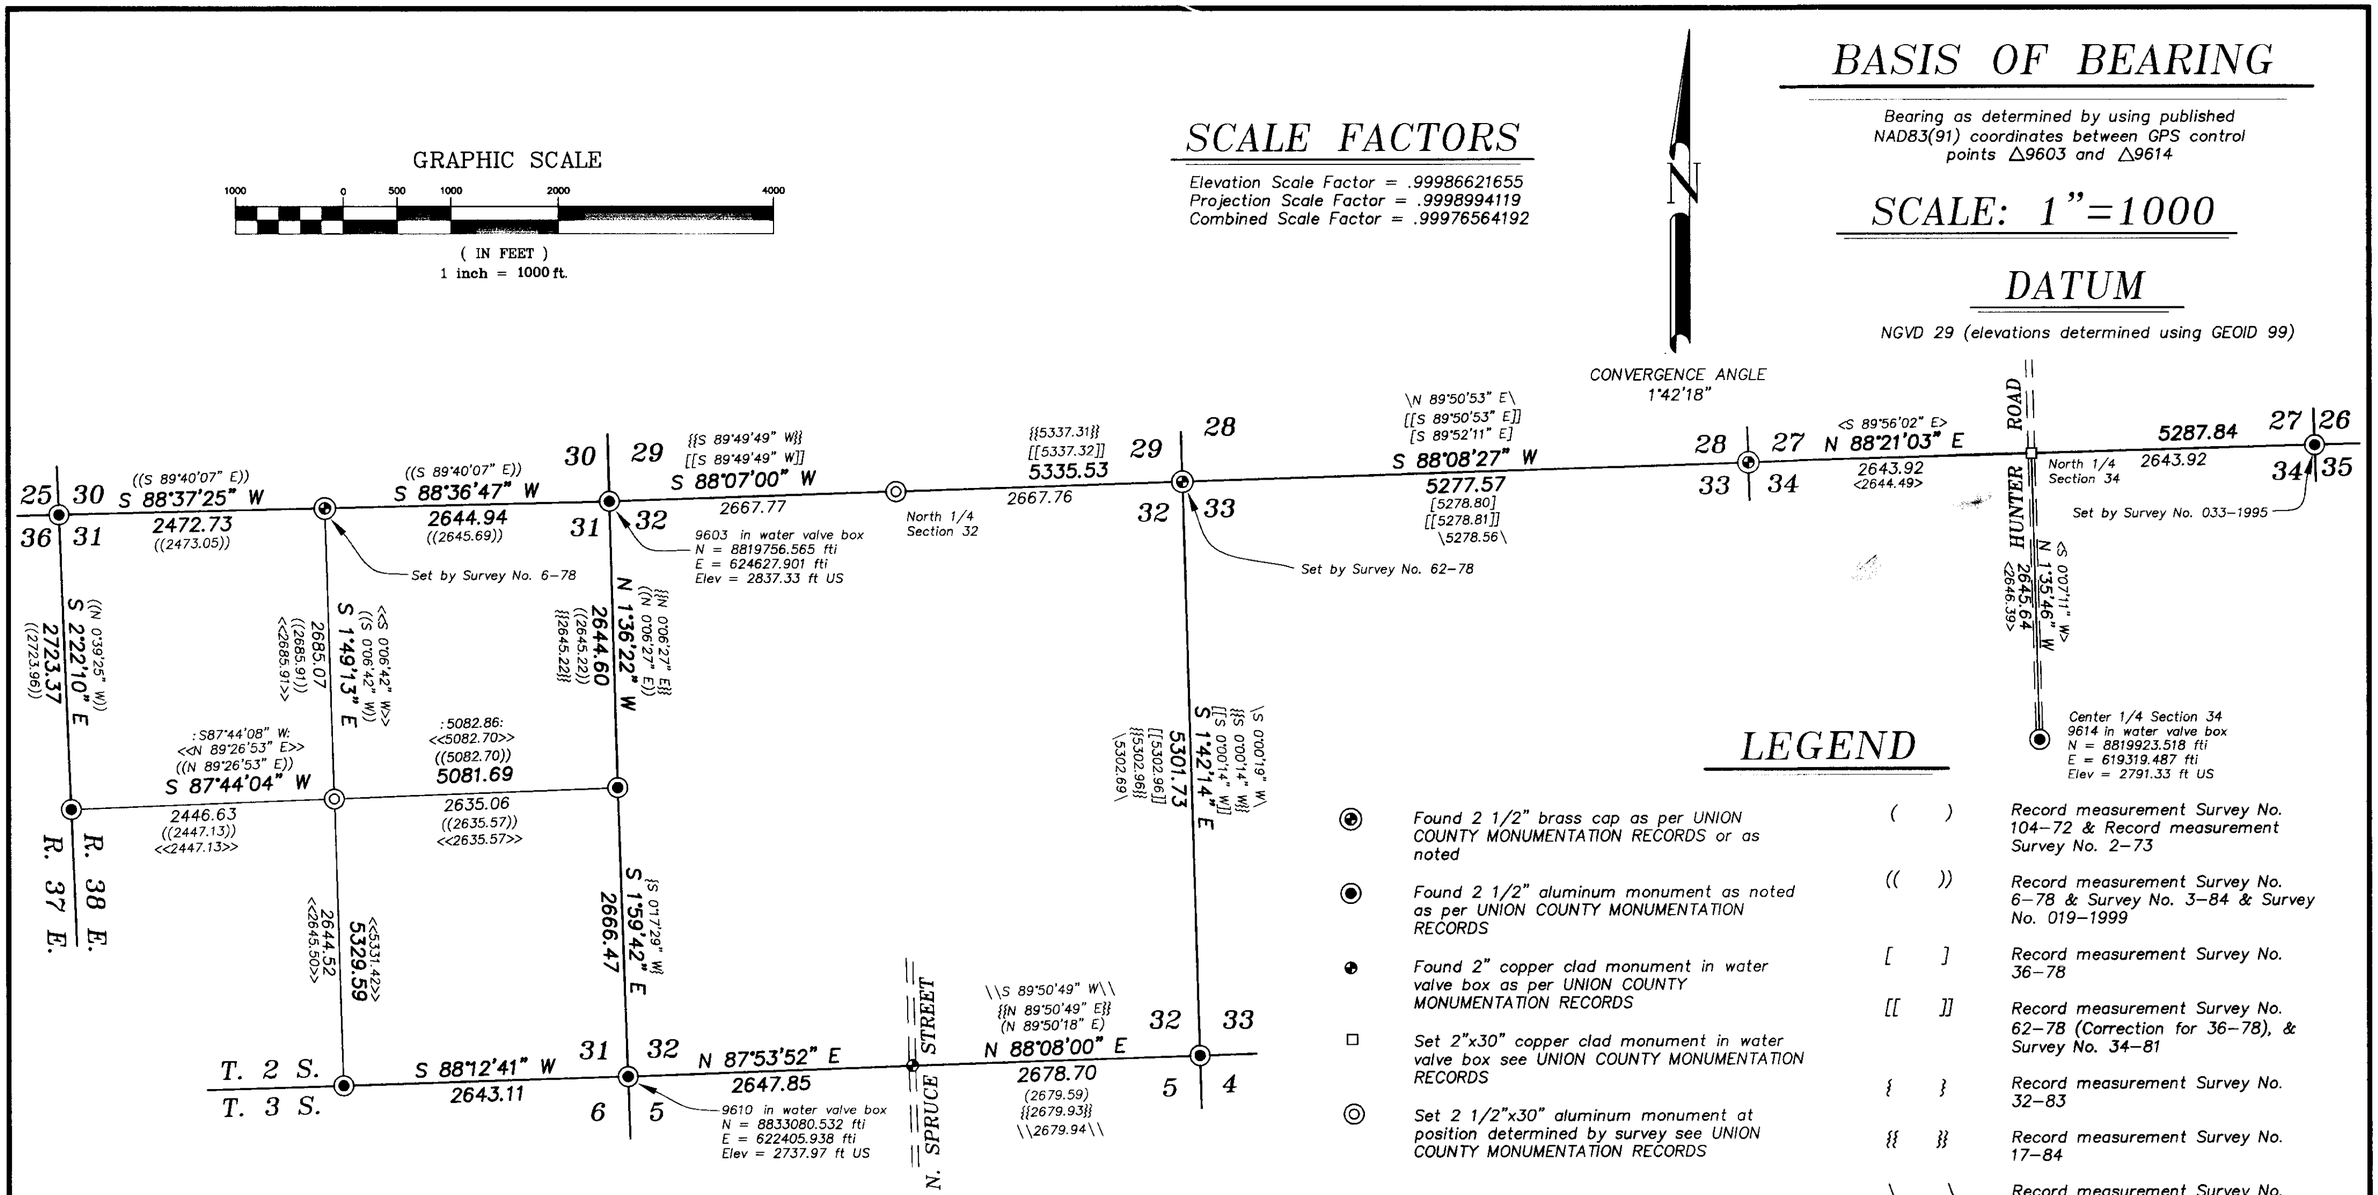

LEGEND

⊙	Found 2 1/2" brass cap as per UNION COUNTY MONUMENTATION RECORDS or as noted
◉	Found 2 1/2" aluminum monument as noted as per UNION COUNTY MONUMENTATION RECORDS
◕	Found 2" copper clad monument in water valve box as per UNION COUNTY MONUMENTATION RECORDS
□	Set 2"x30" copper clad monument in water valve box see UNION COUNTY MONUMENTATION RECORDS
◎	Set 2 1/2"x30" aluminum monument at position determined by survey see UNION COUNTY MONUMENTATION RECORDS

( )	Record measurement Survey No. 104-72 & Record measurement Survey No. 2-73
(( ))	Record measurement Survey No. 6-78 & Survey No. 3-84 & Survey No. 019-1999
[ ]	Record measurement Survey No. 36-78
[[ ]]	Record measurement Survey No. 62-78 (Correction for 36-78), & Survey No. 34-81
{ }	Record measurement Survey No. 32-83
{{ }}	Record measurement Survey No. 17-84
\ \	Record measurement Survey No. 32-84
\\ \\	Record measurement Survey No. 32-85
< >	Record measurement Survey No. 033-1995
<< >>	Record measurement Survey No. 016-1996
: :	Record measurement Survey No. 005-2000

REFERENCE MATERIAL

UNION COUNTY MONUMENTATION RECORDS

UNION COUNTY SURVEYS	UNION COUNTY SURVEYS
Survey No. 104-72	Survey No. 3-84
Survey No. 2-73	Survey No. 17-84
Survey No. 6-78	Survey No. 32-84
Survey No. 36-78	Survey No. 32-85
Survey No. 36-78	Survey No. 033-1995
Survey No. 62-78	Survey No. 016-1996
Survey No. 34-81	Survey No. 019-1999
Survey No. 32-83	Survey No. 005-2000

NARRATIVE

This Survey was performed at the request of the Union County Assesor. The purpose was to monument GLO corners and tie existing corners into a GPS network established by Eagle Survey Corporation for Union County by Survey No. 025-1992, and the 1993 and 1996 GPS control surveys. The Center 1/4 of Section 31 was set by intersection. The North 1/4 of Sections 32 and 34 were set by proportion. The South 1/4 of Section 32 was set by reference ties to a PK nail which had marked the position of an original stone. The bearings and distances are based on State Plane Coordinates NAD83(91). Elevations are NGVD 29 datum. I used Geoid 99 in determination of elevations. Points used as fixed 3d control in the adjustment of the network have their coordinates printed beside them. I find no other problems with this Survey.

UNION COUNTY SURVEYOR

Date Received 2/13/2001

Date Filed 3/2/01

By T. Robinson Deputy

File No. 006-2001

REGISTERED PROFESSIONAL LAND SURVEYOR

OREGON
JULY 13, 1973
GREGORY T. BLACKMAN
991

Renewal Date: Dec. 31, 2001

BAGETT, GRIFFITH & BLACKMAN
2006 Adams Avenue, LaGrande, Oregon

Map of Survey

Situated in Sections 31, 32, 33, and 34 of Township 2 South, Range 38 East of the Willamette Meridian

UNION COUNTY, OREGON

SURVEYED FOR	UNION COUNTY SURVEYOR	
SURVEYED BY	G.T.B.	2/5/01
Scale: 1" = 1000	Drawn by: N.W.V.	2/5/01

SURVEY NO. 006-2001