SECTION 13, T. 4 S., R. 38 E., W.M.

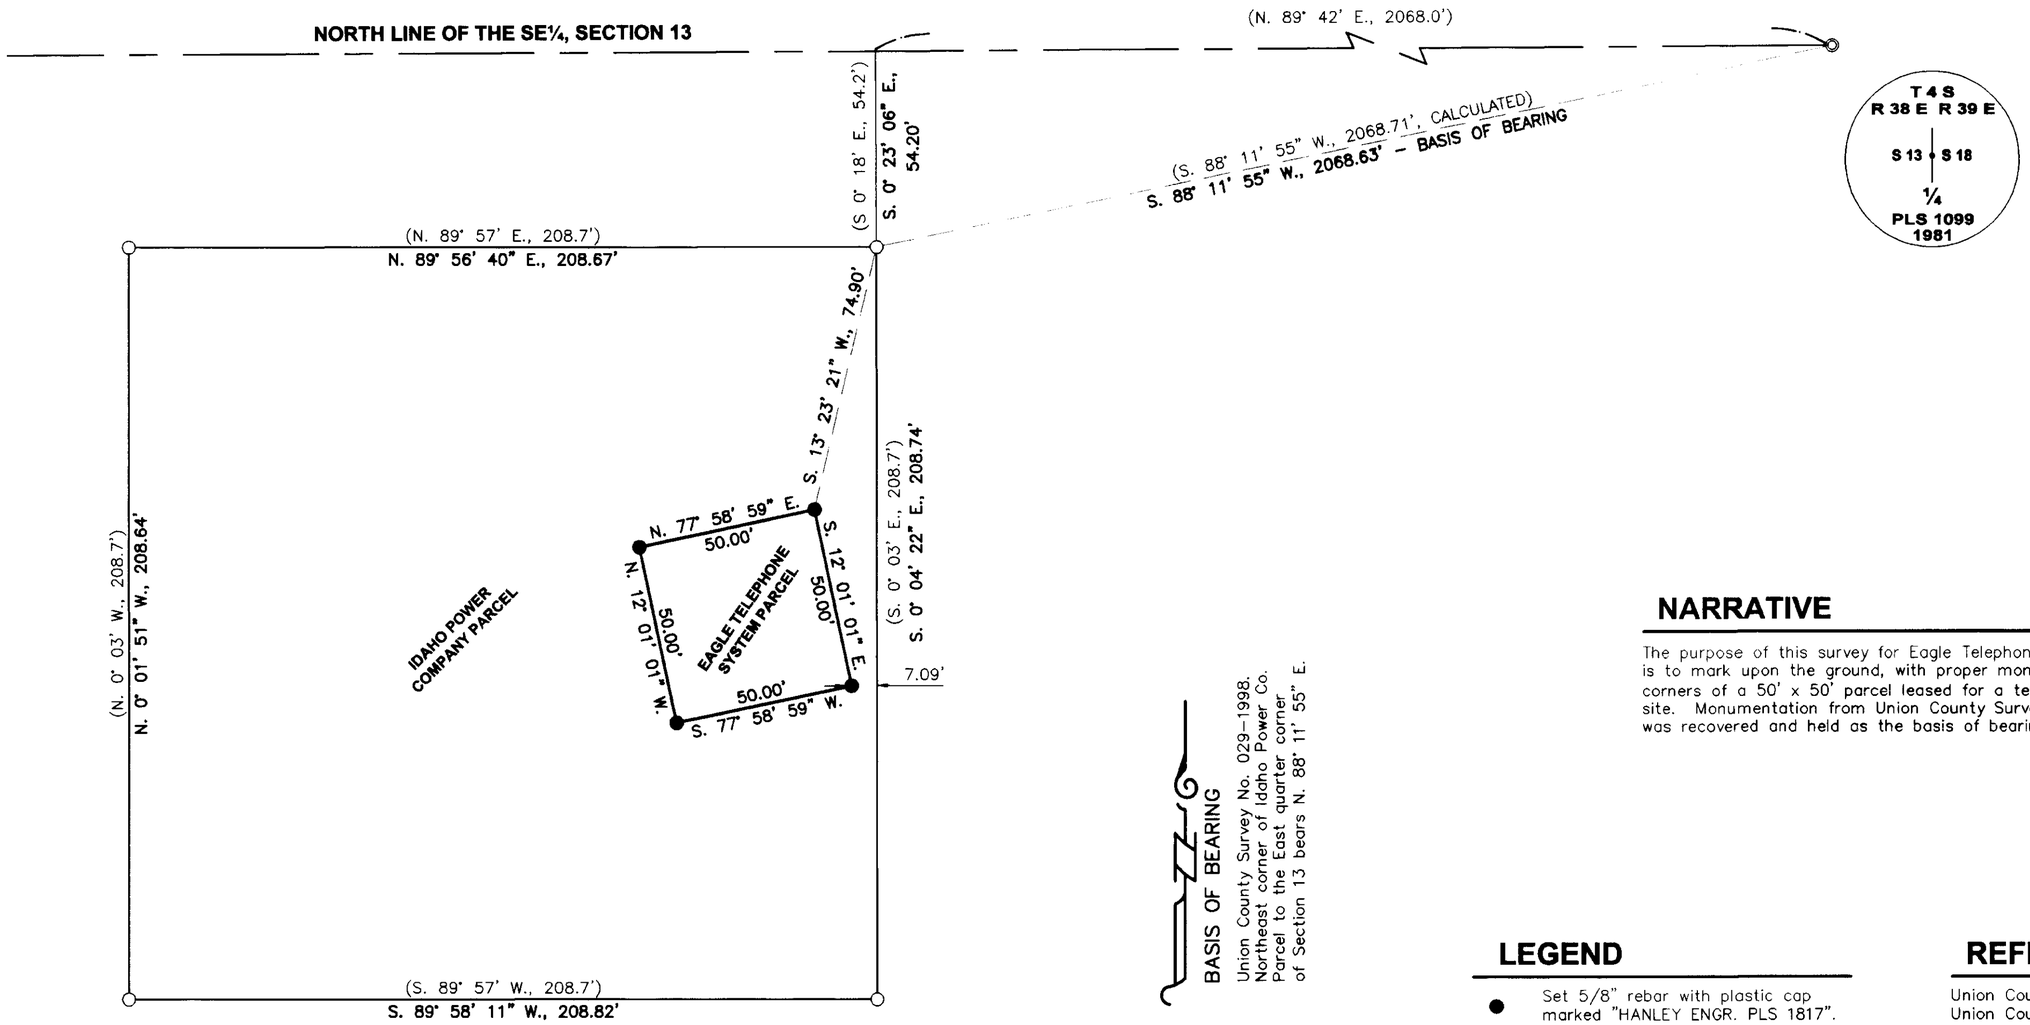

BASIS OF BEARING

Union County Survey No. 029–1998. Northeast corner of Idaho Power Co. Parcel to the East quarter corner of Section 13 bears N. 88° 11' 55" E.

NARRATIVE

The purpose of this survey for Eagle Telephone System, Inc., is to mark upon the ground, with proper monumentation, the corners of a 50' x 50' parcel leased for a telecommunications site. Monumentation from Union County Survey No. 029–1998 was recovered and held as the basis of bearing.

LEGEND

- ● Set 5/8" rebar with plastic cap marked "HANLEY ENGR. PLS 1817".
- ○ Found monument set in concrete set by Union County Survey No. 029–1998.
- ( ) Record data from Union County Survey No. 029–1998.

REFERENCES

Union County Survey No. 76–81.
Union County Survey No. 029–1998.

HANLEY ENGINEERING, INC.

P.O. BOX 701, 2043 MAIN STREET, BAKER CITY, OREGON 97814 (541) 523–3803

MAP OF SURVEY

IN THE NW¼ SE¼, SECTION 13,
T. 4 S., R. 38 E., W.M.
UNION COUNTY, OREGON

Surveyed August 21 thru September 3, 2002
for Eagle Telephone System, Inc.
Scale: 1" = 30'

Date Received 9/10/02
Date Filed 9/18/02
R. Robinson, Deputy
File No. 038-2002

REGISTERED PROFESSIONAL LAND SURVEYOR
OREGON
JULY 13, 1979
THOMAS J. HANLEY
1817

Renews June 30, 2003

SURVEY NUMBER 038-2002