

# RECORD OF SURVEY IN THE NE 1/4 SW 1/4 OF SECTION 34 T.2S., R38E., W.M. UNION COUNTY, OREGON.

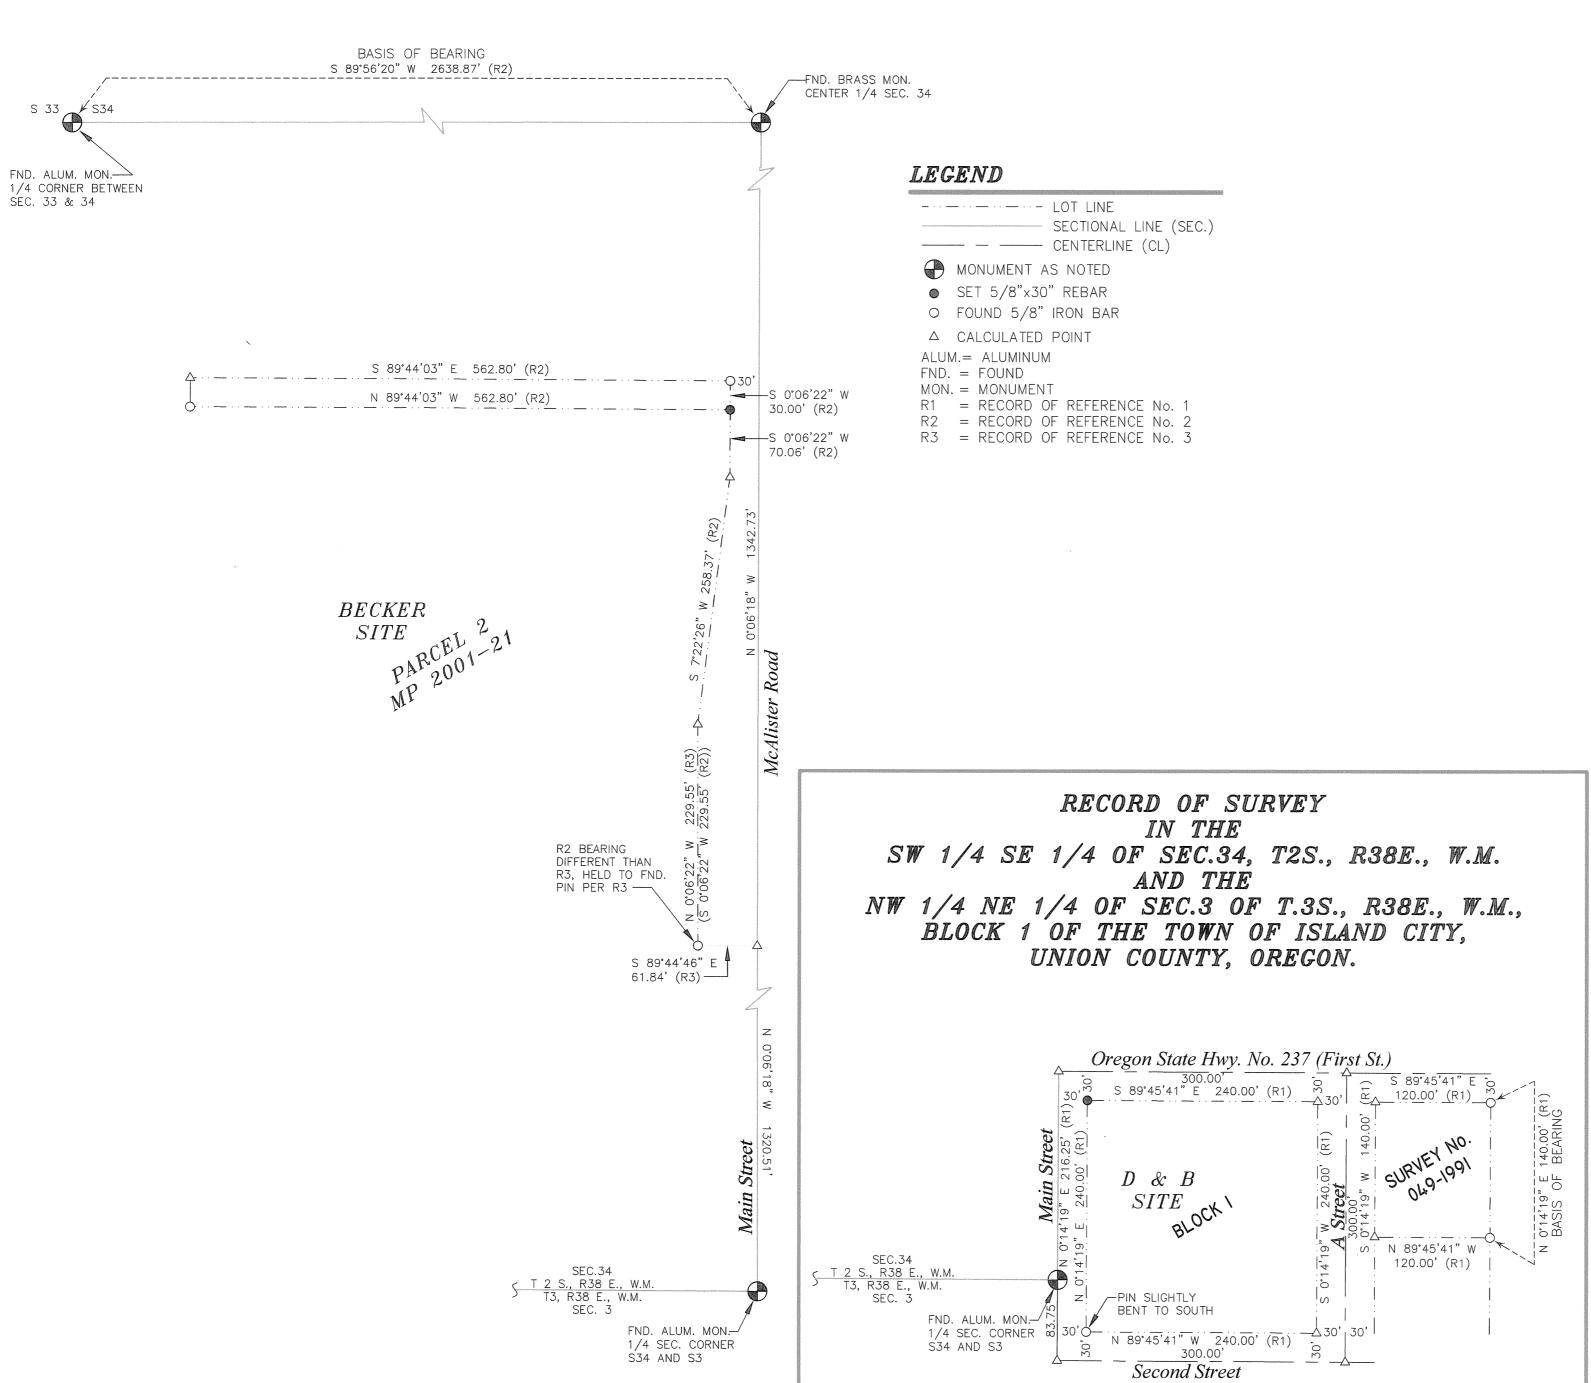

### BASIS of BEARING

BECKER SITE: IS FROM SURVEY No. 046-2001, D & B SITE: IS FROM SURVEY No. 006-1992.

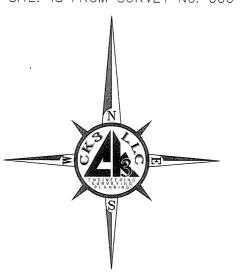

100' 0 100' 20 SCALE 1" = 100'

### ALL DISTANCES SHOWN HERE ARE IN FEET UNLESS NOTED OTHERWISE **RECORDS OF REFERENCE**


- R1 RECORD OF SURVEY FOR D & B SUPPLY, BY BAGETT-GRIFFITH & ASSOCIATES, FILED UNDER COUNTY SURVEY NO. 006-1992.
- R2 RECORD OF SURVEY FOR A LOT LINE ADJUSTMENT FOR MIKE BECKER, BY BAGETT, GRIFFITH & BLACKMAN, FILED UNDER COUNTY SURVEY NO. 046-2001.
- R3 MAJOR PARTITION PLAT No. 1994-22 BY BAGETT-GRIFFITH & ASSOCIATES, FILING PLAT CAB. No. A374.

#### NARRATIVE

THIS SURVEY WAS MADE AT THE REQUEST OF BOB McCAFFERTY TO REPLACE TWO PROPERTY MONUMENTS THAT WERE REMOVED DURING CONSTRUCTION ACTIVITIES OF ODOT, PROJECT OR. 82: RIDDLE ROAD LOGRANDE—IMBLER SECTION. THE FIRST PROPERTY MONUMENT WAS REPLACED & REFERENCE MADE PER COUNTY SURVEY NO. 046—2001 AND PLAT CAB. NO. A374, 1994—22. WE FOUND SEVERAL TYPOGRAPHICAL BEARING ERRORS IN THESE SURVEYS AND HELD TO FOUND PINS AS NOTED. THE BASIS OF BEARING AND CONTROL IS FROM SAID SURVEY AS SHOWN. THE SECOND PROPERTY MONUMENT WAS REPLACED AND REFERENCE MADE PER COUNTY SURVEY NO. 006—1992. THE BASIS OF BEARING AND CONTROL IS FROM SAID SURVEY AS SHOWN. BOTH SURVEYS SHOWN HERE HAVE INDEPENDENT BASIS OF BEARING AND CONTROL AND ONE COMMON POINT BEING THE 1/4 CORNER BETWEEN SEC. 3 T3 S. R38 E. W.M. AND SEC. 34 T2 S. R38 E. W.M. THEY ARE SHOWN TOGETHER HERE FOR GENERAL REFERENCE TO EACH OTHER ONLY.

#### SURVEYOR'S CERTIFICATE

I, DANNY K. CUMMINGS, A REGISTERED PROFESSIONAL LAND SURVEYOR HEREBY CERTIFY THAT A SURVEY WAS COMPLETED ON 12/31/2007, THAT THE SURVEY WAS MADE BY ME, OR UNDER MY DIRECTION, THAT THE MONUMENTS ARE AS SHOWN, AND THAT THIS MAP IS A TRUE AND ACCURATE REPRESENTATION OF SAID SURVEY.

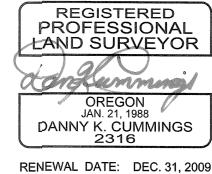

UNION COUNTY
SURVEYOR
DATE RECEIVED: 1/29/08

DATE FILED: 1/30/08

BY: R.ROSINSON, DEPUTY

FILE No.: 003-2008

SURVEY FOR:

## McCafferty - Whittle



# CIVIL-STRUCTURAL-ELECTRICAL ENGINEERING SURVEYING & PLANNING 368 S.W. 5th AVENUE ONTARIO, OREGON 97914

SHEET:

TEL: 541-889-5411 ~ FAX: 889-2074

E-MAIL: ck3@fmtc.com

CHECKED BY: DKC FIELDBOOK No.: 0-242 PAGE(S): 11-20

DRAWN BY: MATT URE DWG FILE No.:

APPROVED BY: DKC FILENAME: V0-07014.dwg JOB No.: V0-07014

SURVEY NUMBER 003-2008