

# BASIS OF BEARING

Solar observation taken at a point 1087 feet North and 1256 feet West of the Southwest corner of Section 31, Township 4 South, Range 41 East of the Willamette Meridian

SCALE: 1" = 400'

## REFERENCE MATERIAL

Union County Monumentation Records  
 Survey Number 29-86  
 Survey Number 30-86  
 Survey Number 24-88  
 Survey Number 25-88


DEED REFERENCES  
 Book 105 Page 20  
 Book 135 Page 540  
 Book 142 Page 606  
 Book 158 Page 629  
 Microfilm Number 991956

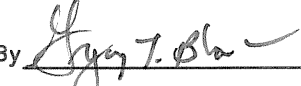
## NARRATIVE

This survey was done at the request of Craig Cox, owner of the land within. Mr. Cox wanted to monument the corners and post the lines shown hereon. The break of Section 31 is based on Surveys 25-88 and 24-88. I recover the monuments as shown. I find no unusual conditions with this survey.

## LEGEND

- ⊙ Record position of 2 1/2" aluminum monument set by Survey Number 29-86
- ⊕ Found 2 1/2" aluminum monument set by Survey Number 29-86
- Found 2 1/2" brass cap on iron pipe as per Union County Monumentation Records
- ⊙ Found 2 1/2" aluminum monument set by Survey Number 25-88
- ⊕ Found 5/8" iron pin with 2 1/2" aluminum cap set by Survey Number 25-88
- ⊙ Set 5/8"x30" iron pin with 2 1/2" aluminum cap
- Set 5/8"x30" iron pin with yellow plastic cap marked "BGB SURVEY MARKER"
- [ ] Record measurement as per Survey Number 24-88
- ( ) Record measurement as per Survey Number 25-88
- Posted Line
- Position of steel fencepost set on line

REGISTERED  
 PROFESSIONAL  
 LAND SURVEYOR  
  
 OREGON  
 JULY 17, 1988  
 RICK G. ROBINSON  
 2219  
 Renewal Date: Dec. 31, 2010

UNION COUNTY  
 SURVEYOR  
 Date Received 6/9/09  
 Date Filed 6/9/09  
 By   
 File No. 012-2009

**BAGETT, GRIFFITH & BLACKMAN**  
 2006 Adams Avenue, LaGrande, Oregon  
 Map of Survey  
 A tract of land situated in Lots 8, 9, 10, and 11 and the South half of Lot 4 of Section 31, Township 3 South, Range 41 East of the Willamette Meridian  
 UNION COUNTY, OREGON  
 SURVEYED FOR Craig Cox  
 SURVEYED BY R. G. R.  
 Scale: 1" = 400' Drawn by: J. S. H. May/June 2009

SURVEY NUMBER 012-2009

